


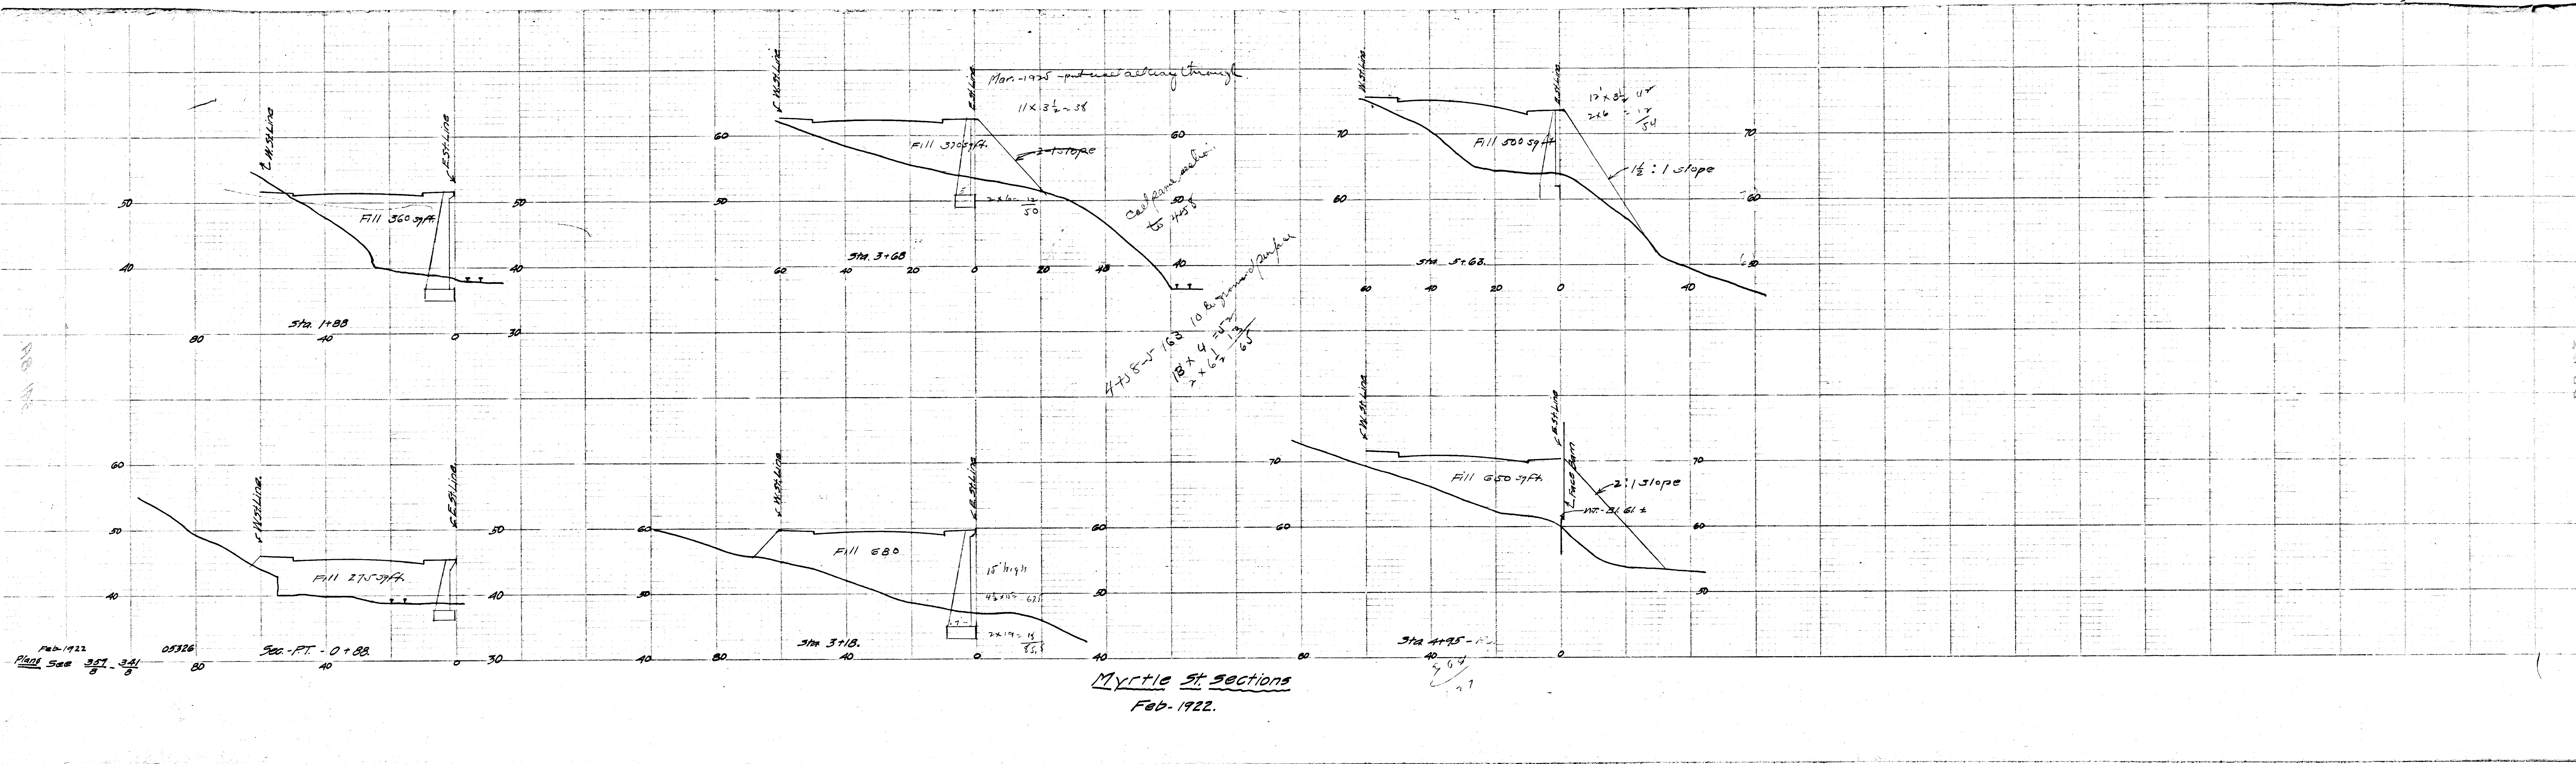

Myrtle St. sections
Feb. 1922.

Feb. 1922
Plans See 357 - 341
05326
Sec. - PT. - 0 + 88