


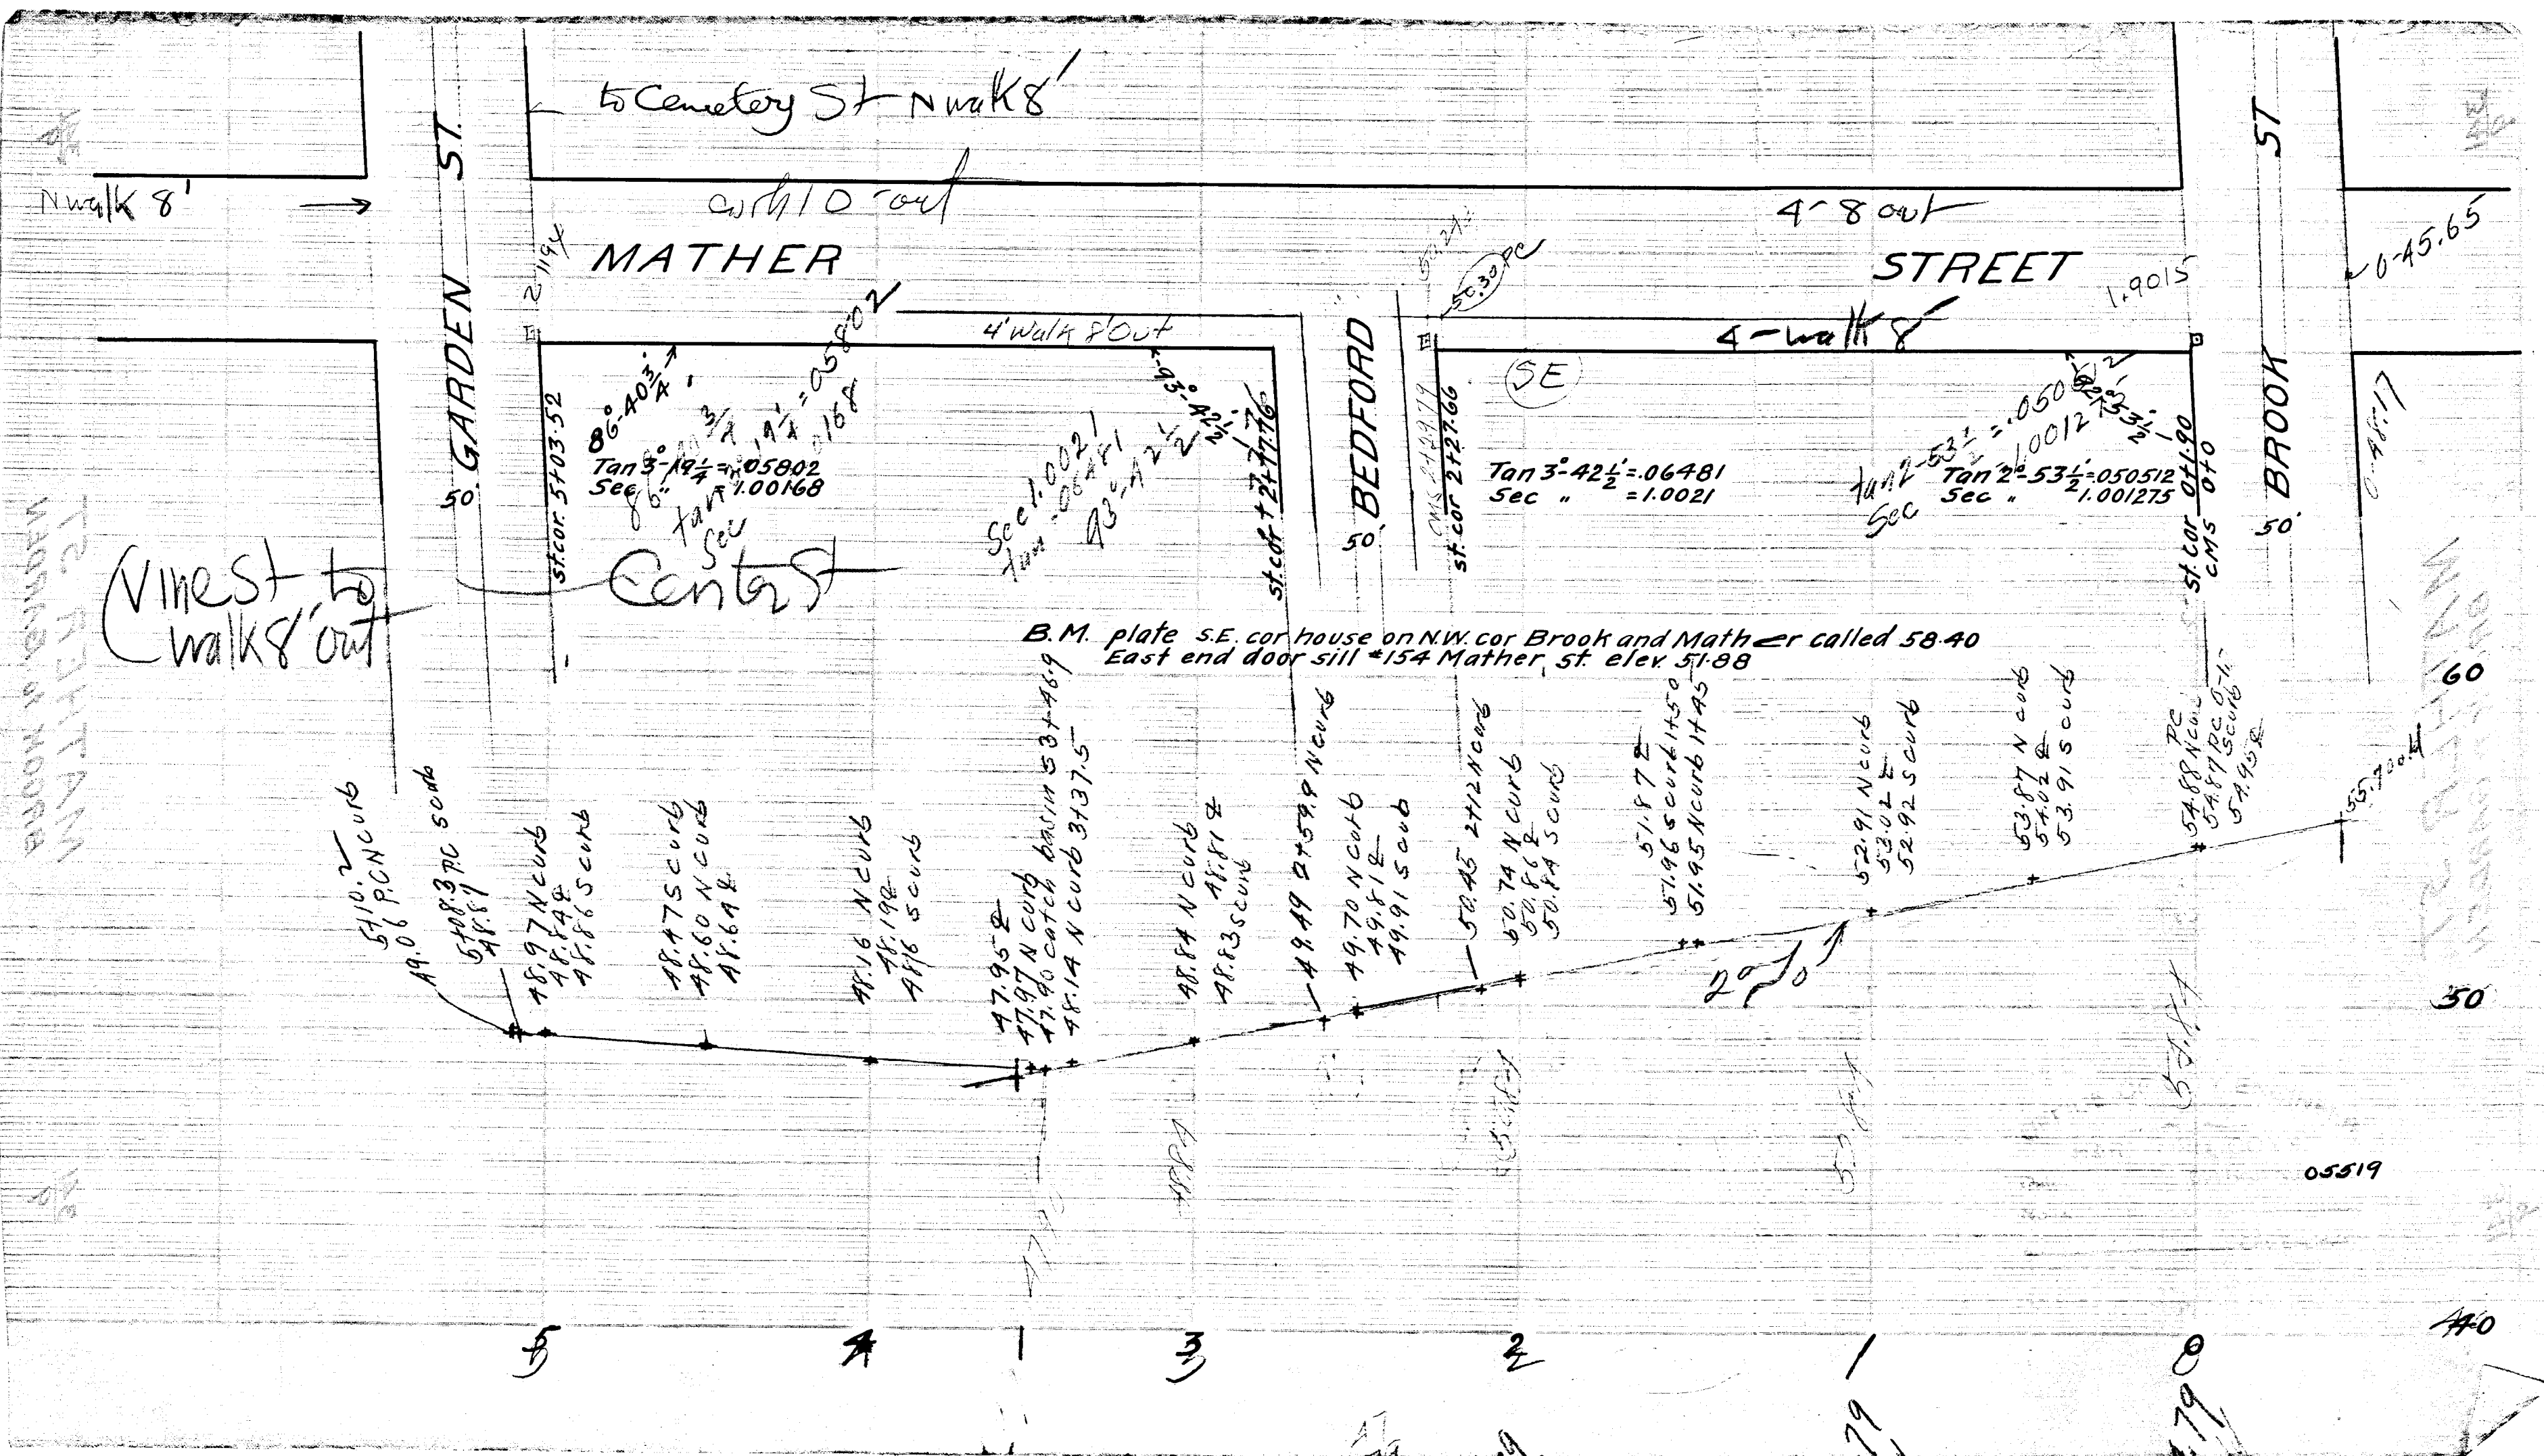

N walk 8'

to Cemetery St N walk 8'

MATHER

STREET

ST

50. GARDEN ST.

50. BEDFORD

50. BROOK ST

(Vine St to walk 8' out)

Center St

B.M. plate S.E. cor house on NW cor Brook and Mather called 58.40
East end door sill #154 Mather St. elev 51.88



5110.2 N curb

5108.3 PC 50 db

48.97 N curb

48.86 S curb

48.75 S curb

48.60 N curb

48.64 E

48.16 N curb

48.19 E

48.16 S curb

47.95 E

47.97 N curb

47.90 catch basin 53+46.9

48.14 N curb 3437.5

48.84 N curb

48.81 E

48.83 S curb

49.49 2+54.9 N curb

49.70 N curb

49.81 E

49.91 S curb

50.45 2+12 N curb

50.74 N curb

50.86 E

50.84 S curb

51.87 E

51.96 S curb 1+50

51.95 N curb 1+45

52.91 N curb

53.02 E

52.92 S curb

53.87 N curb

54.02 E

53.91 S curb

54.88 N curb

54.87 PC 5+1

54.95 E

55.70 E





