


Profile of Bartholomew Avenue

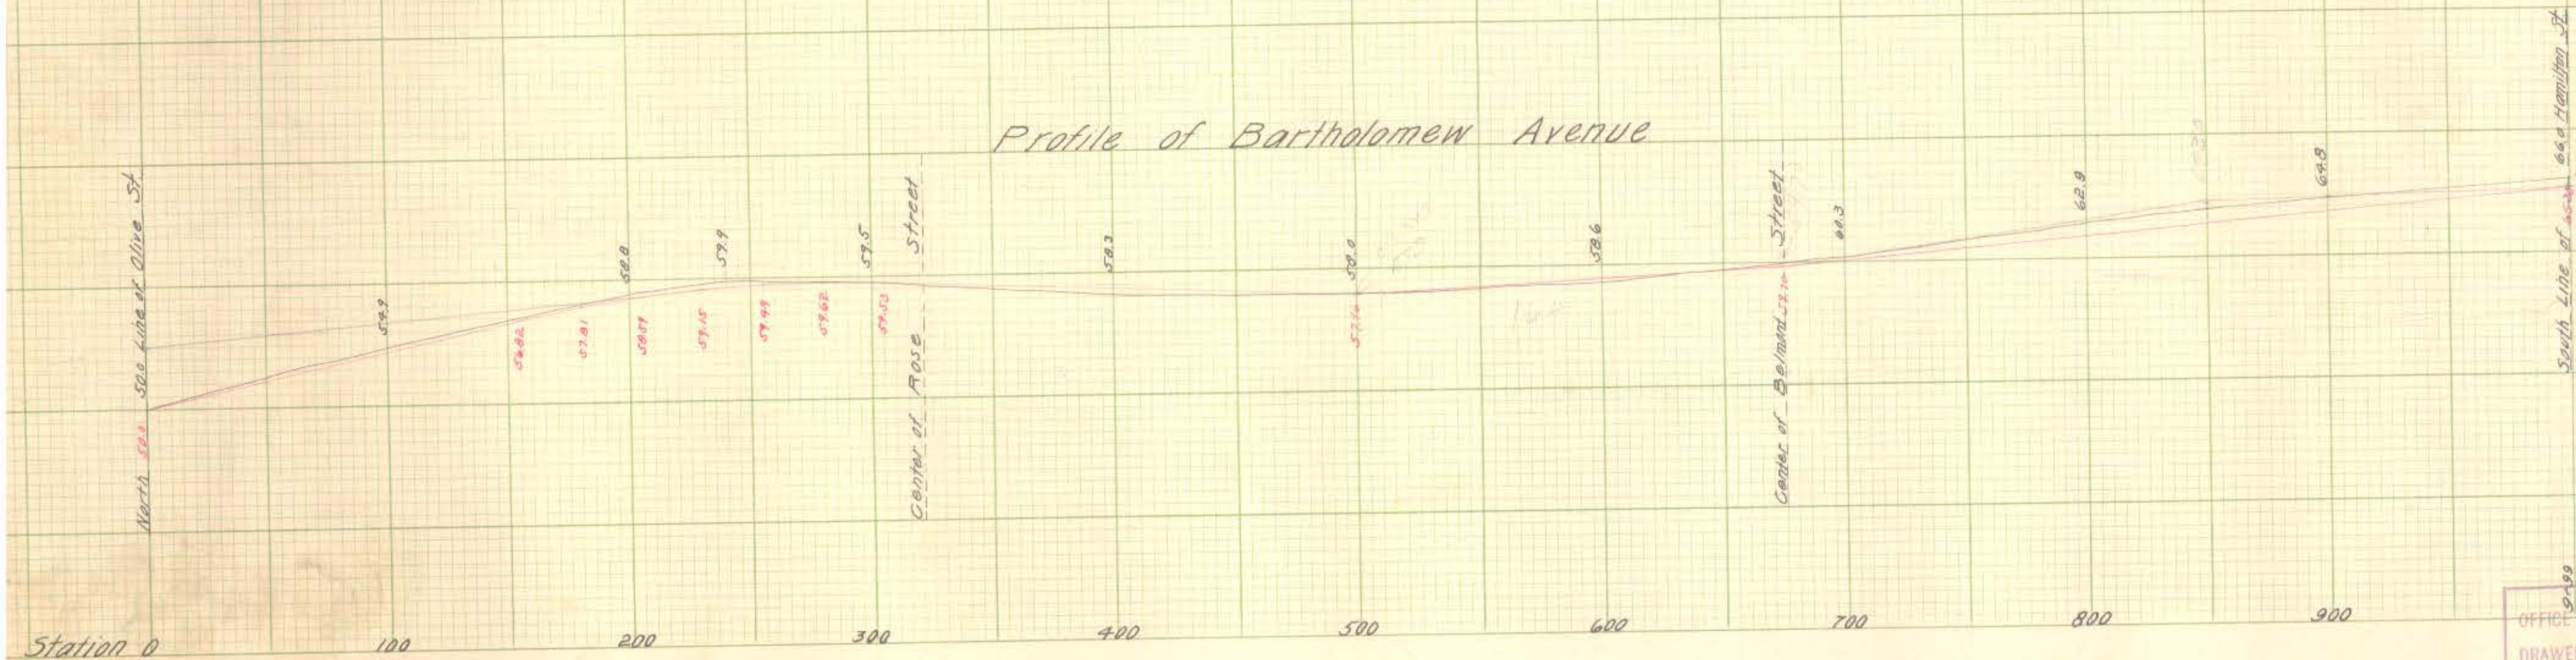

OFFICE No. 59
DRAWER " 142
SHEET "