


PROFILE OF WARRENTON AVE.

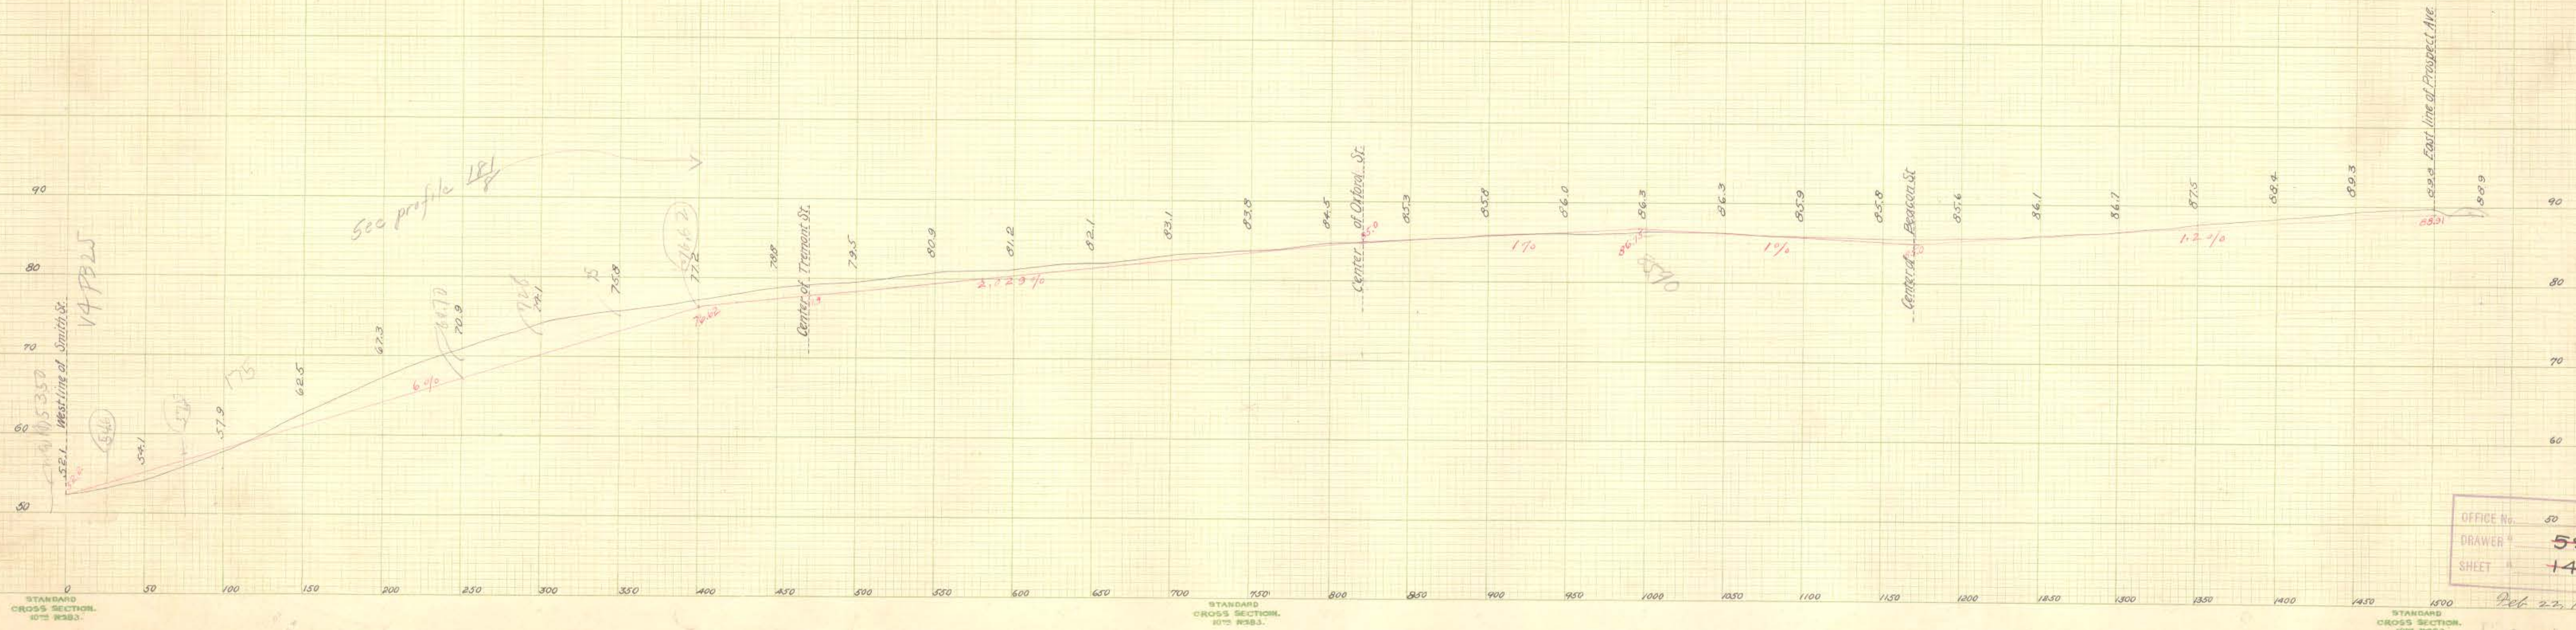

OFFICE No. 50
 DRAWER 59 343
 SHEET 143 10

Feb 22, 1897