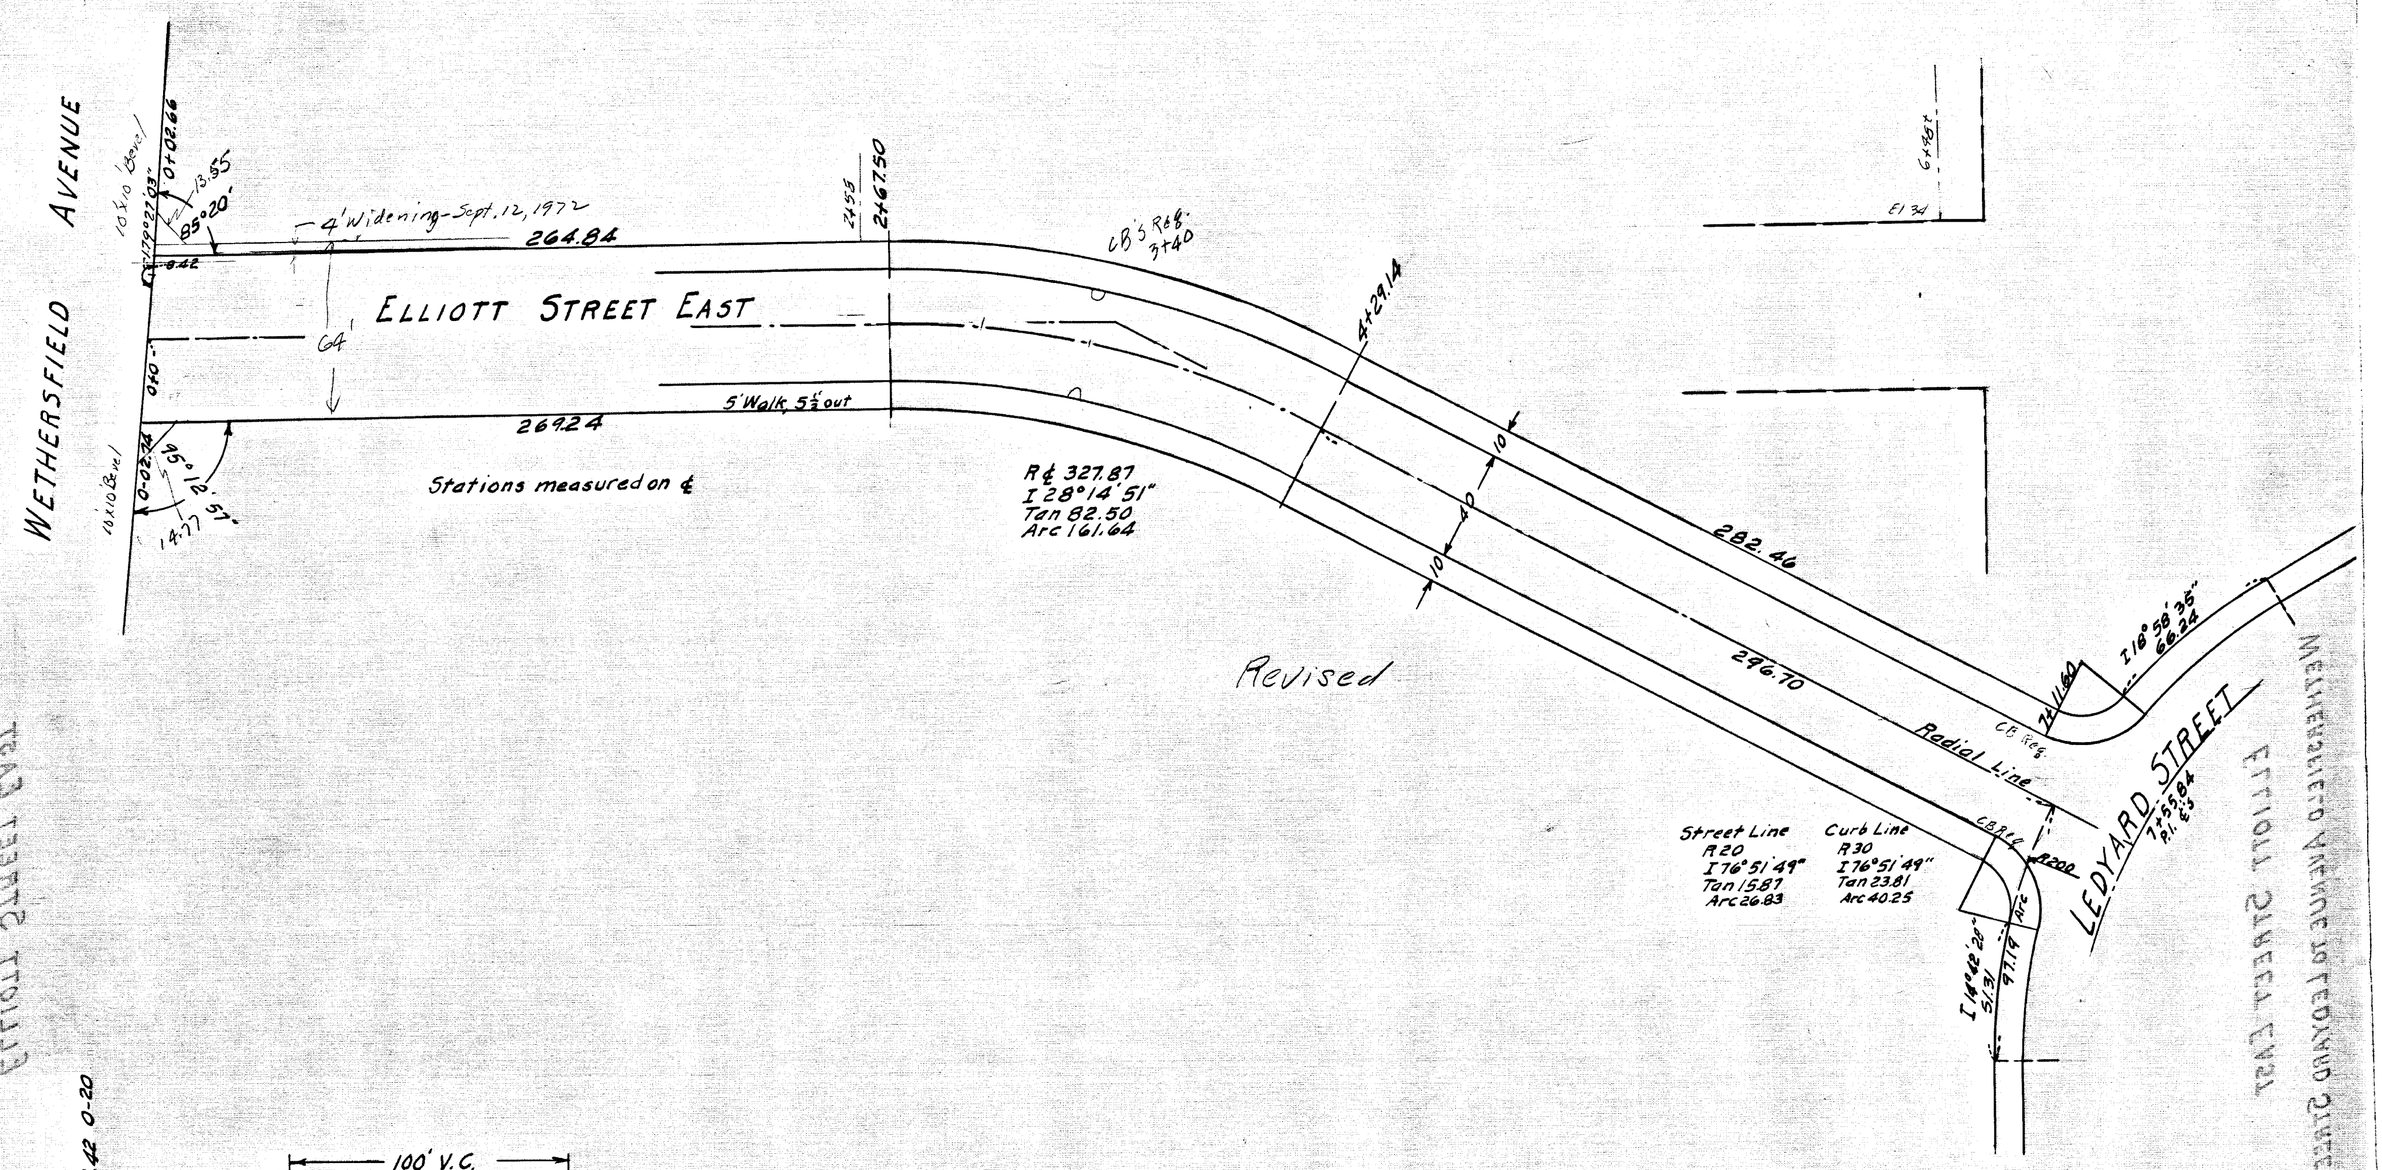

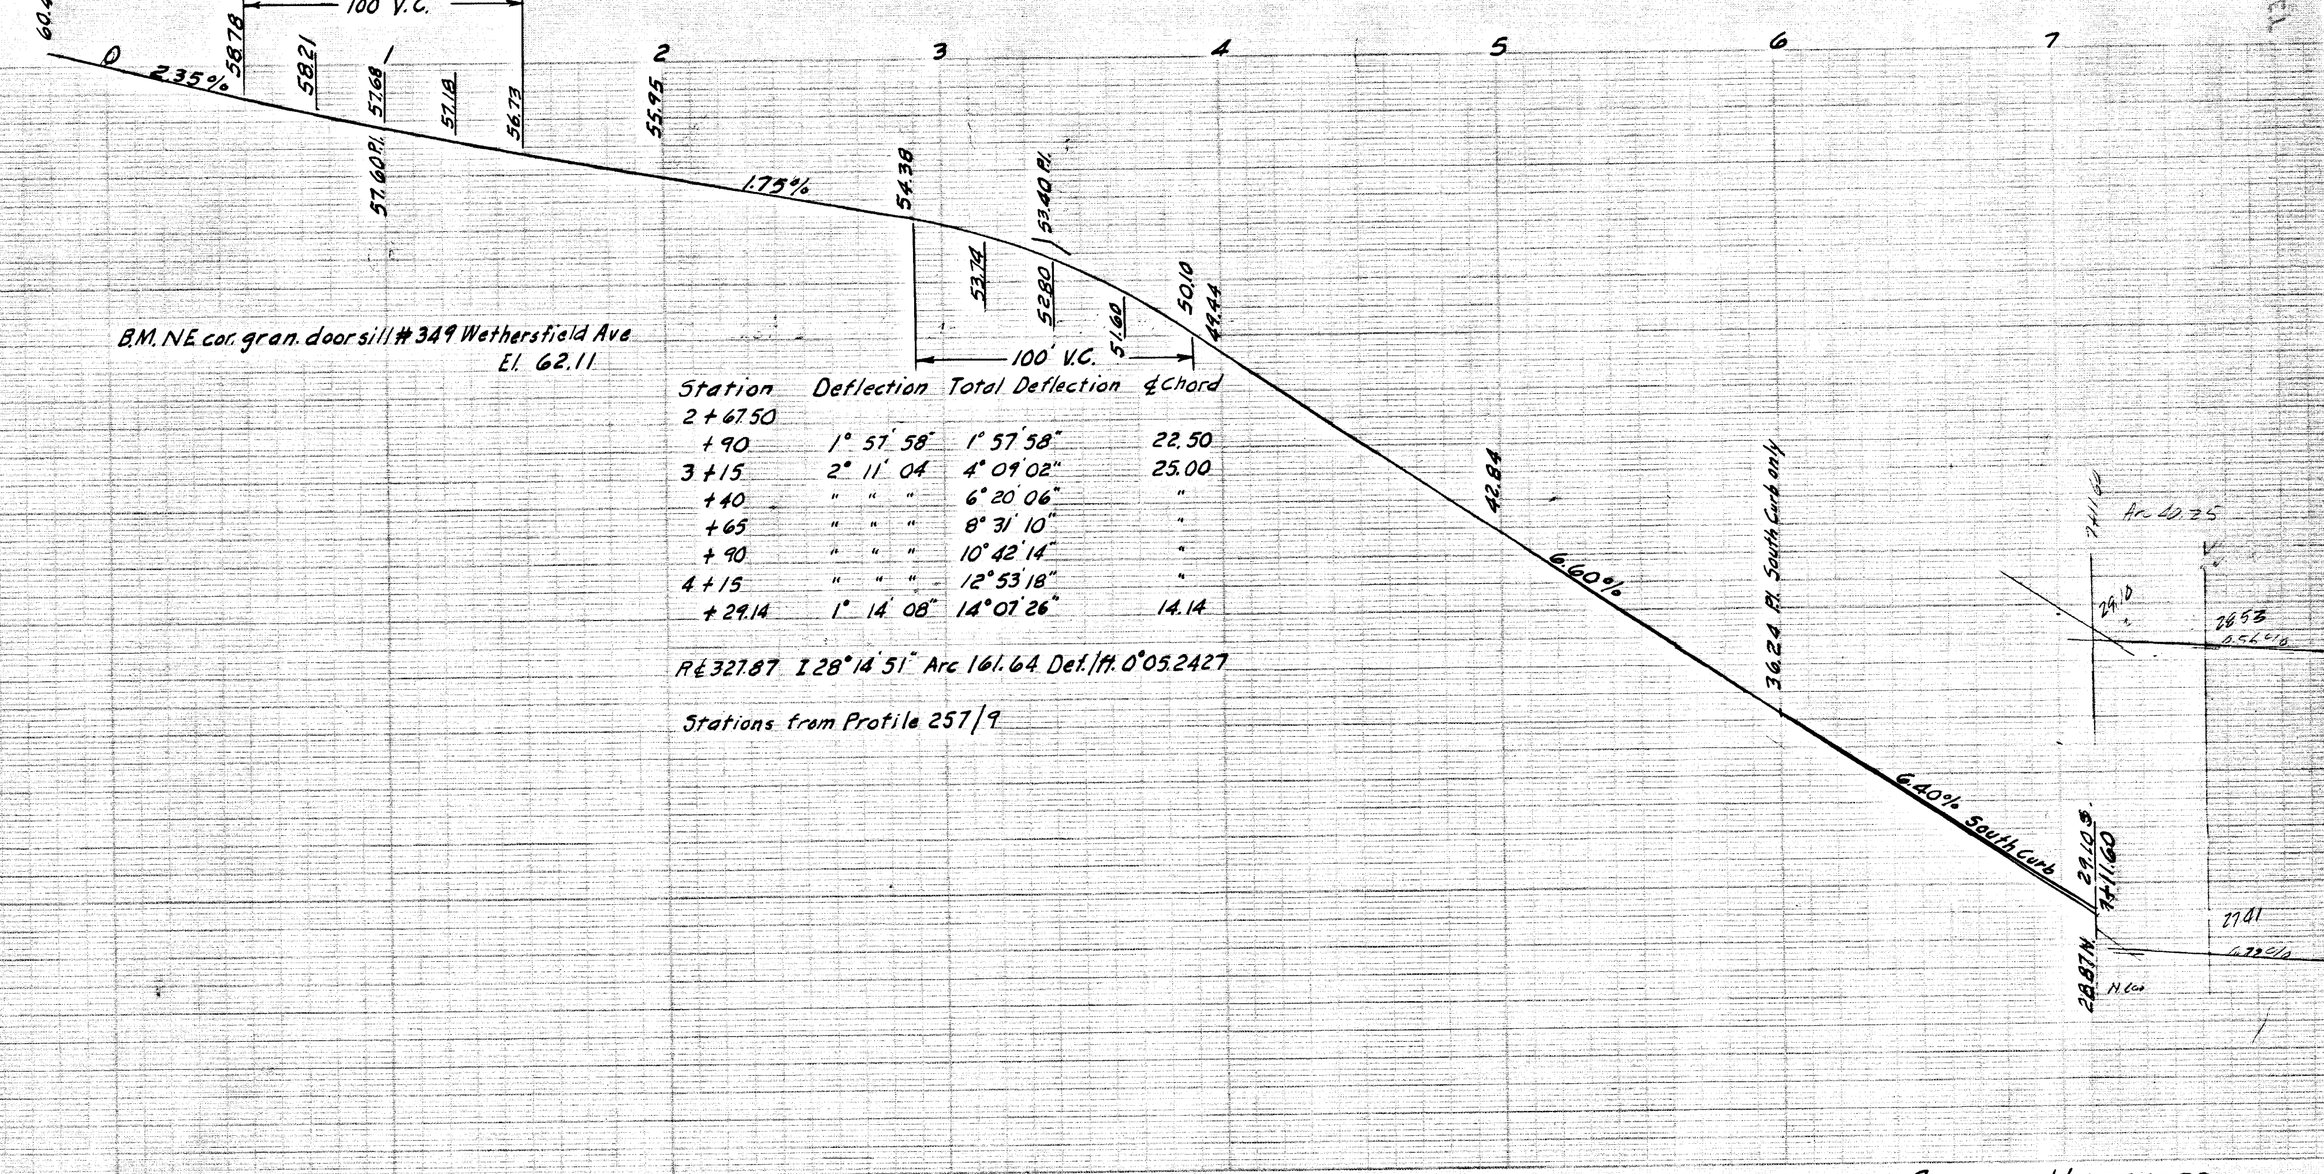

Station	Deflection	Total Deflection	℄ Chord
2+67.50			
+90	1° 57' 58"	1° 57' 58"	22.50
3+15	2° 11' 04	4° 09' 02"	25.00
+40	" " "	6° 20' 06"	"
+65	" " "	8° 31' 10"	"
+90	" " "	10° 42' 14"	"
4+15	" " "	12° 53' 18"	"
+29.14	1° 14' 08"	14° 07' 26"	14.14

R℄ 327.87 I 28°14'51" Arc 161.64 Det./ft. 0°05.2427

Stations from Profile 257/9

LAYOUT PASSED!

NEVER N.G.

CITY OF HARTFORD
DEPARTMENT OF ENGINEERING
SCALES H. 1" = 40' V. 1" = 4'
JANUARY 1972
DAYBOOK No. 10318