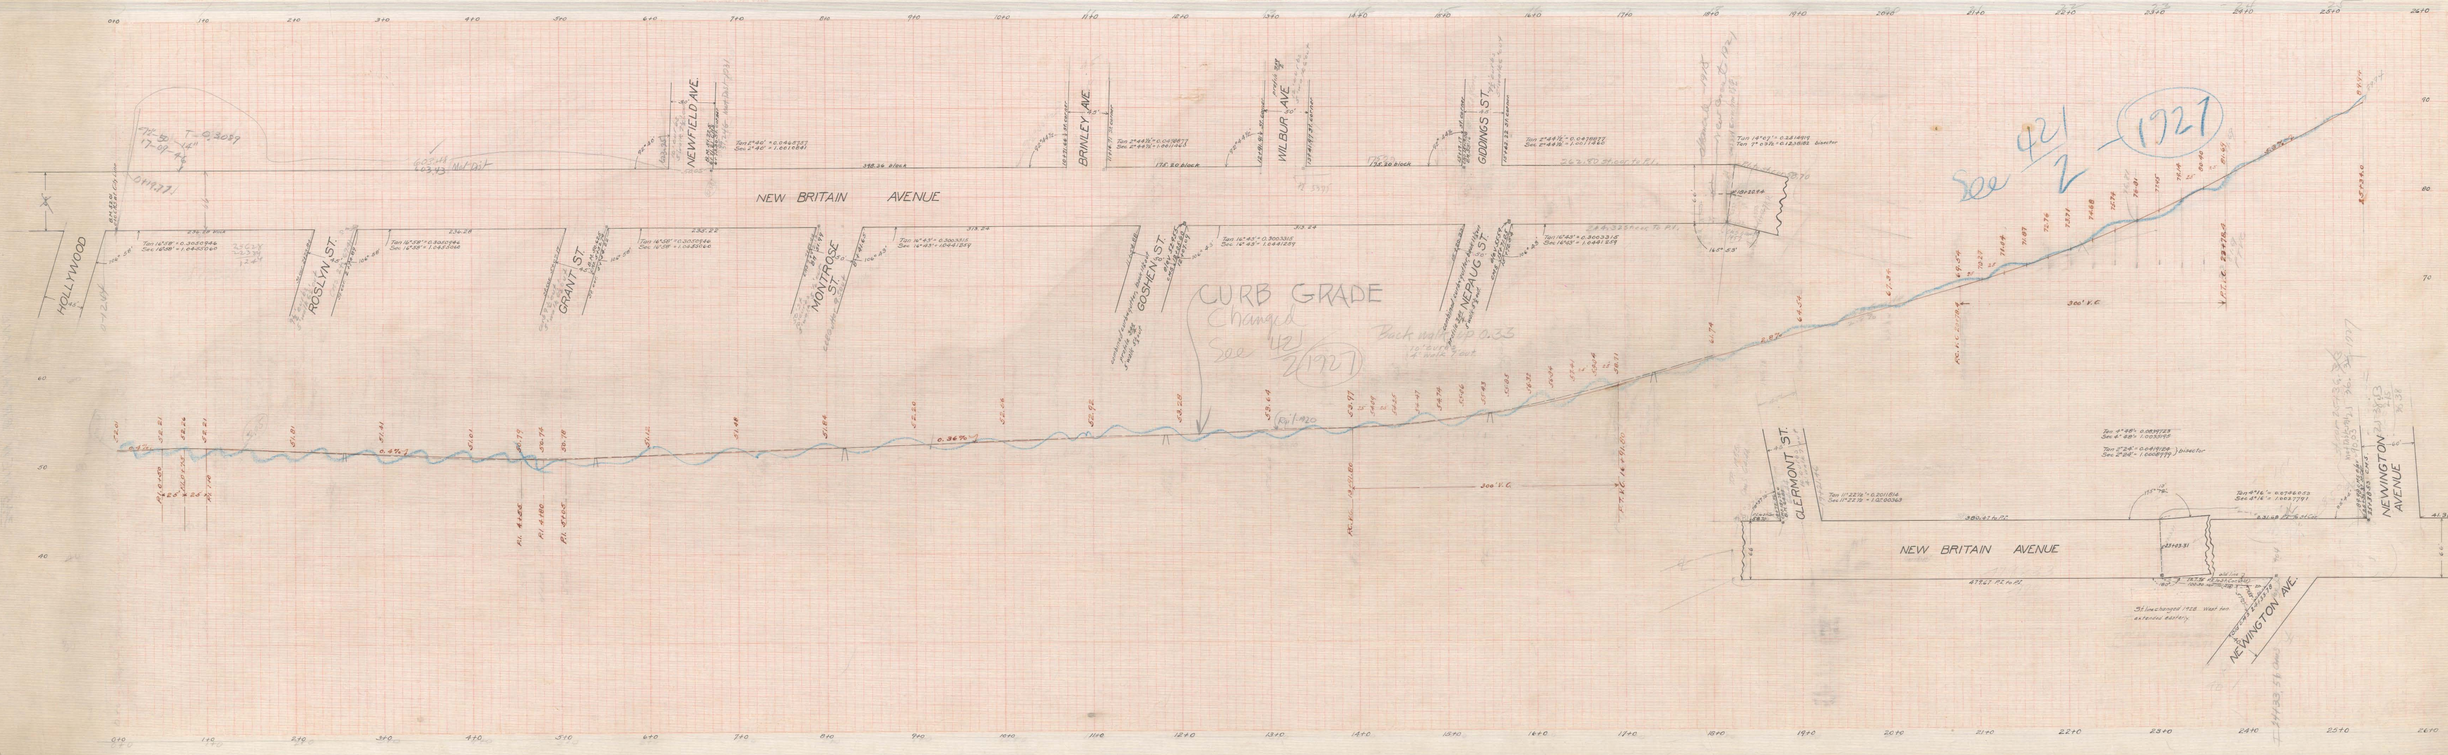
NEW BRITAIN AVENUE
HOLLYWOOD
ROSLYN ST.
GRANT ST.
MONTROSE ST.
NEWFIELD AVE.
BRAINLEY AVE.
WILBUR AVE.
GOSHEN ST.
NEPAUG ST.
CLERMONT ST.
NEWINGTON AVENUE
CURB GRADE
Changed
300' V.C.
NEW BRITAIN AVENUE
NEWINGTON AVE.