


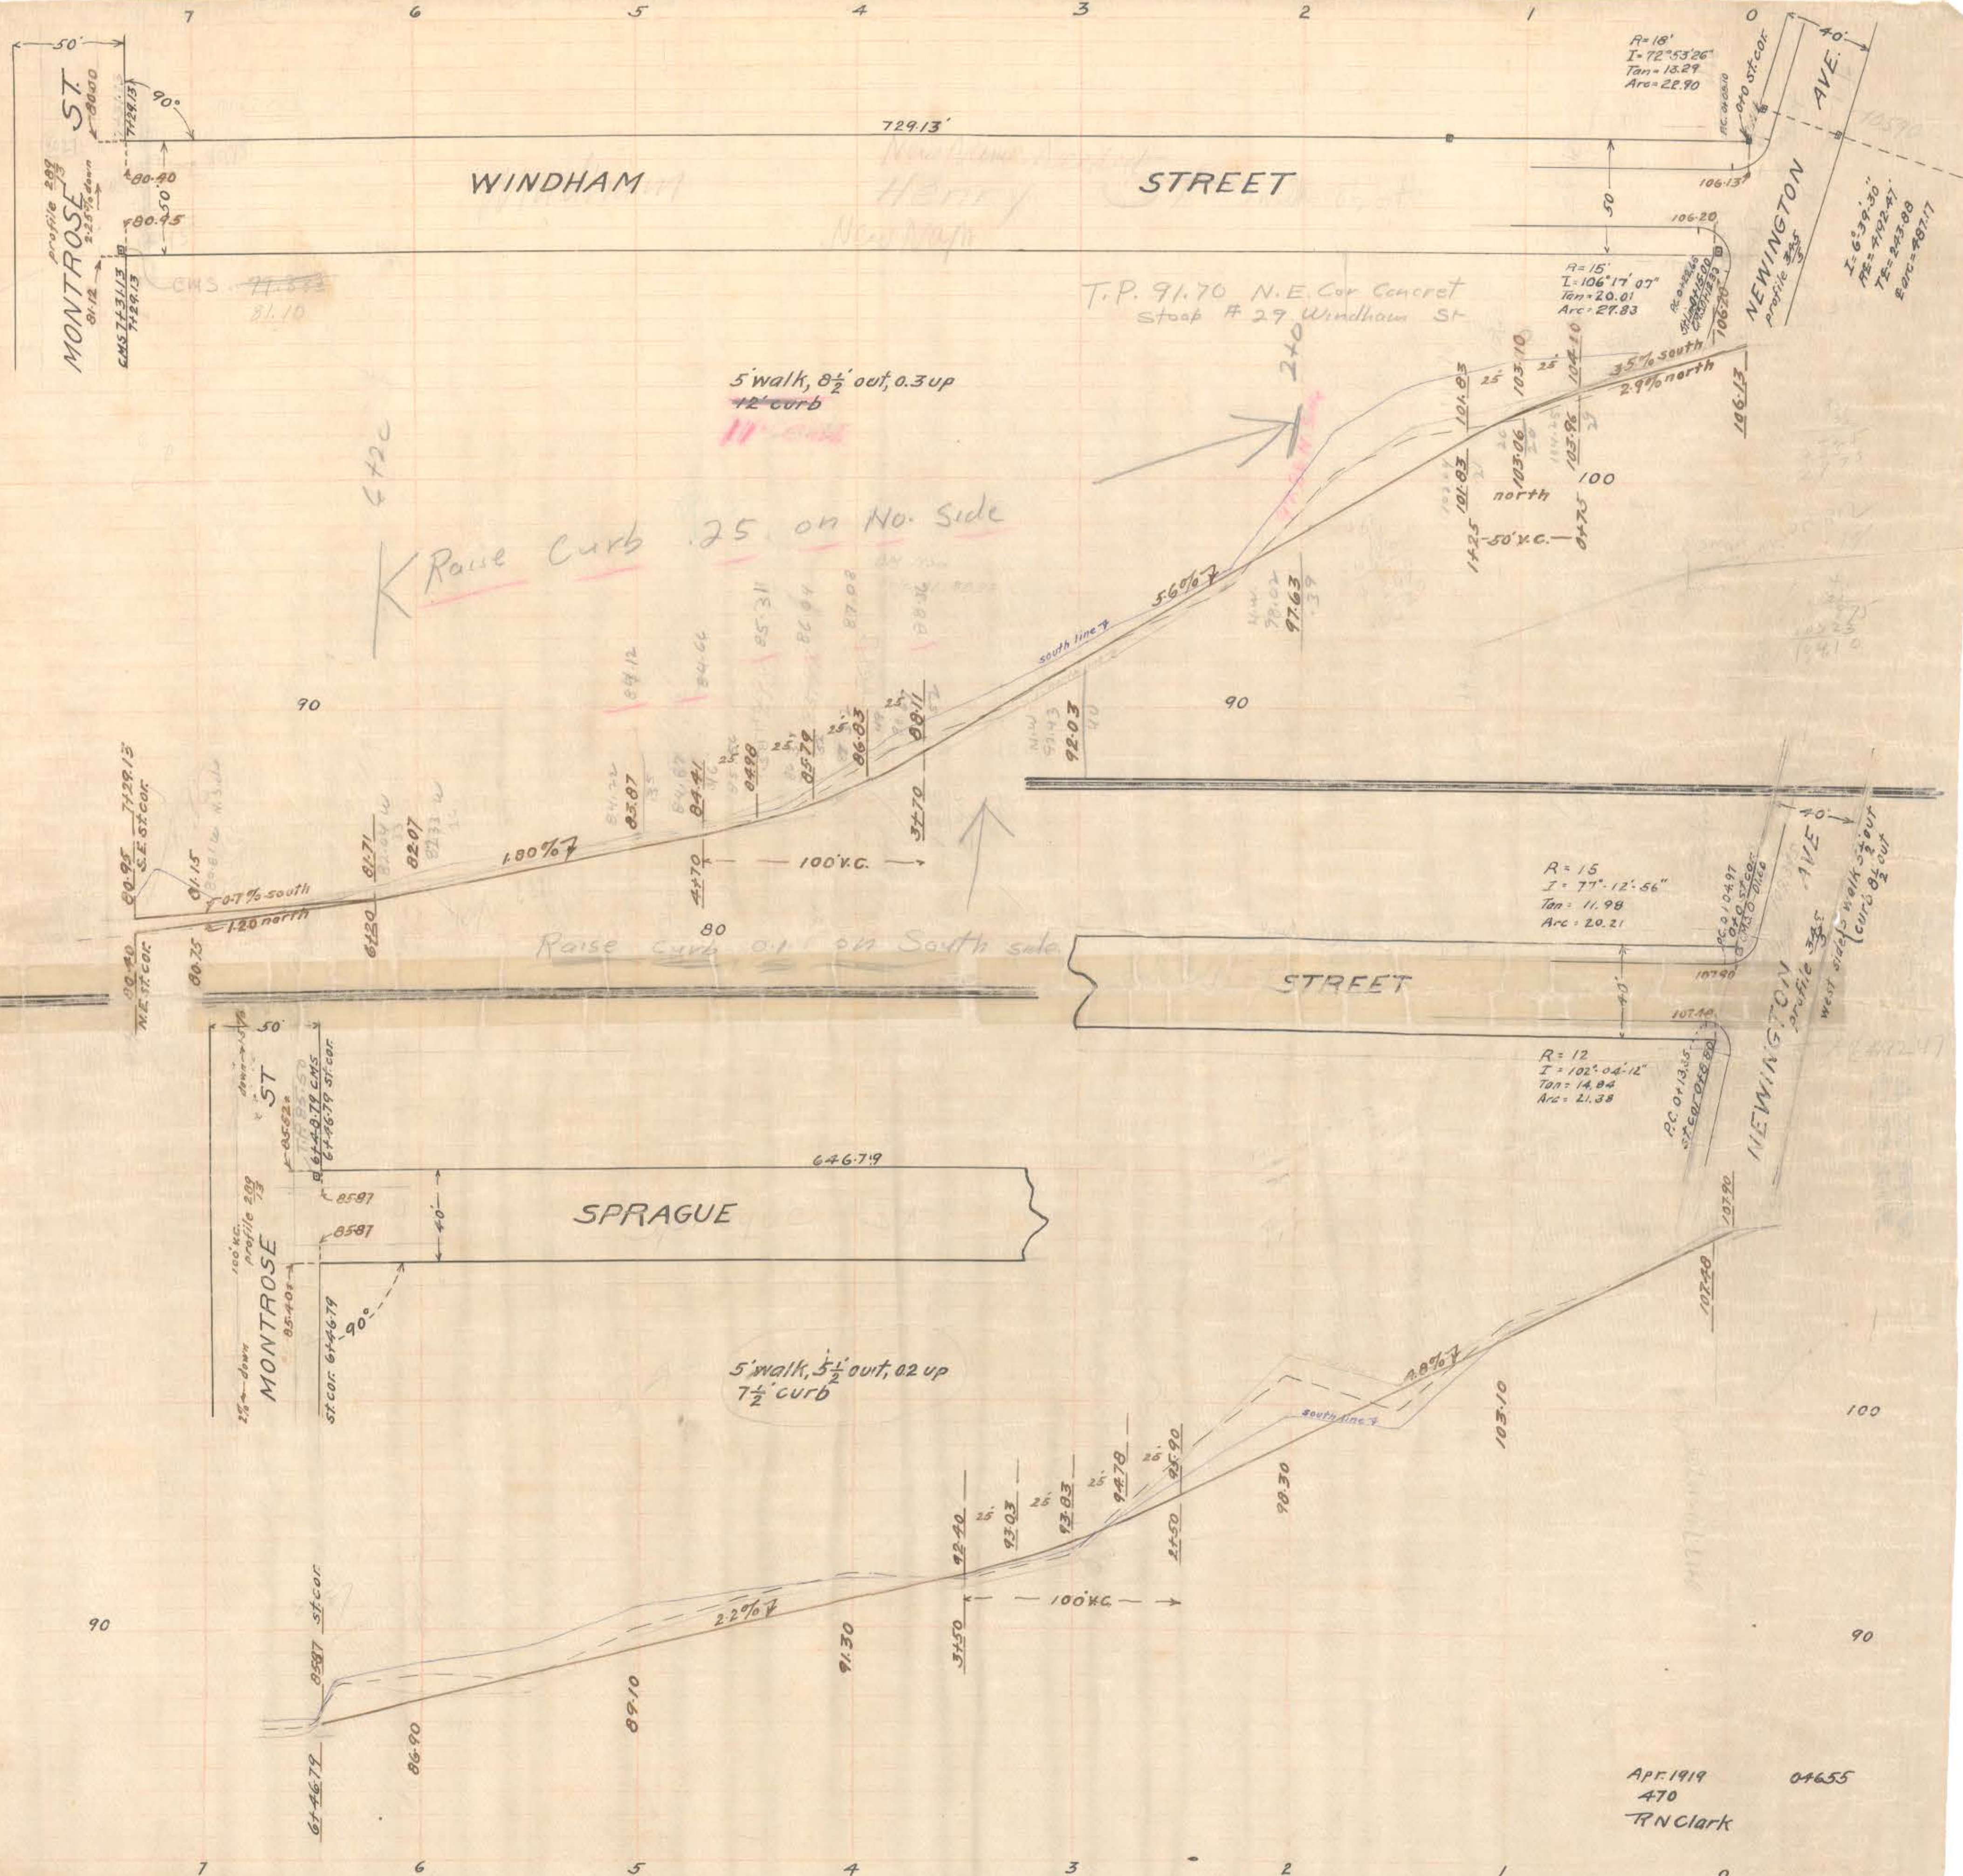

Apr. 1919
470
R N Clark

04655