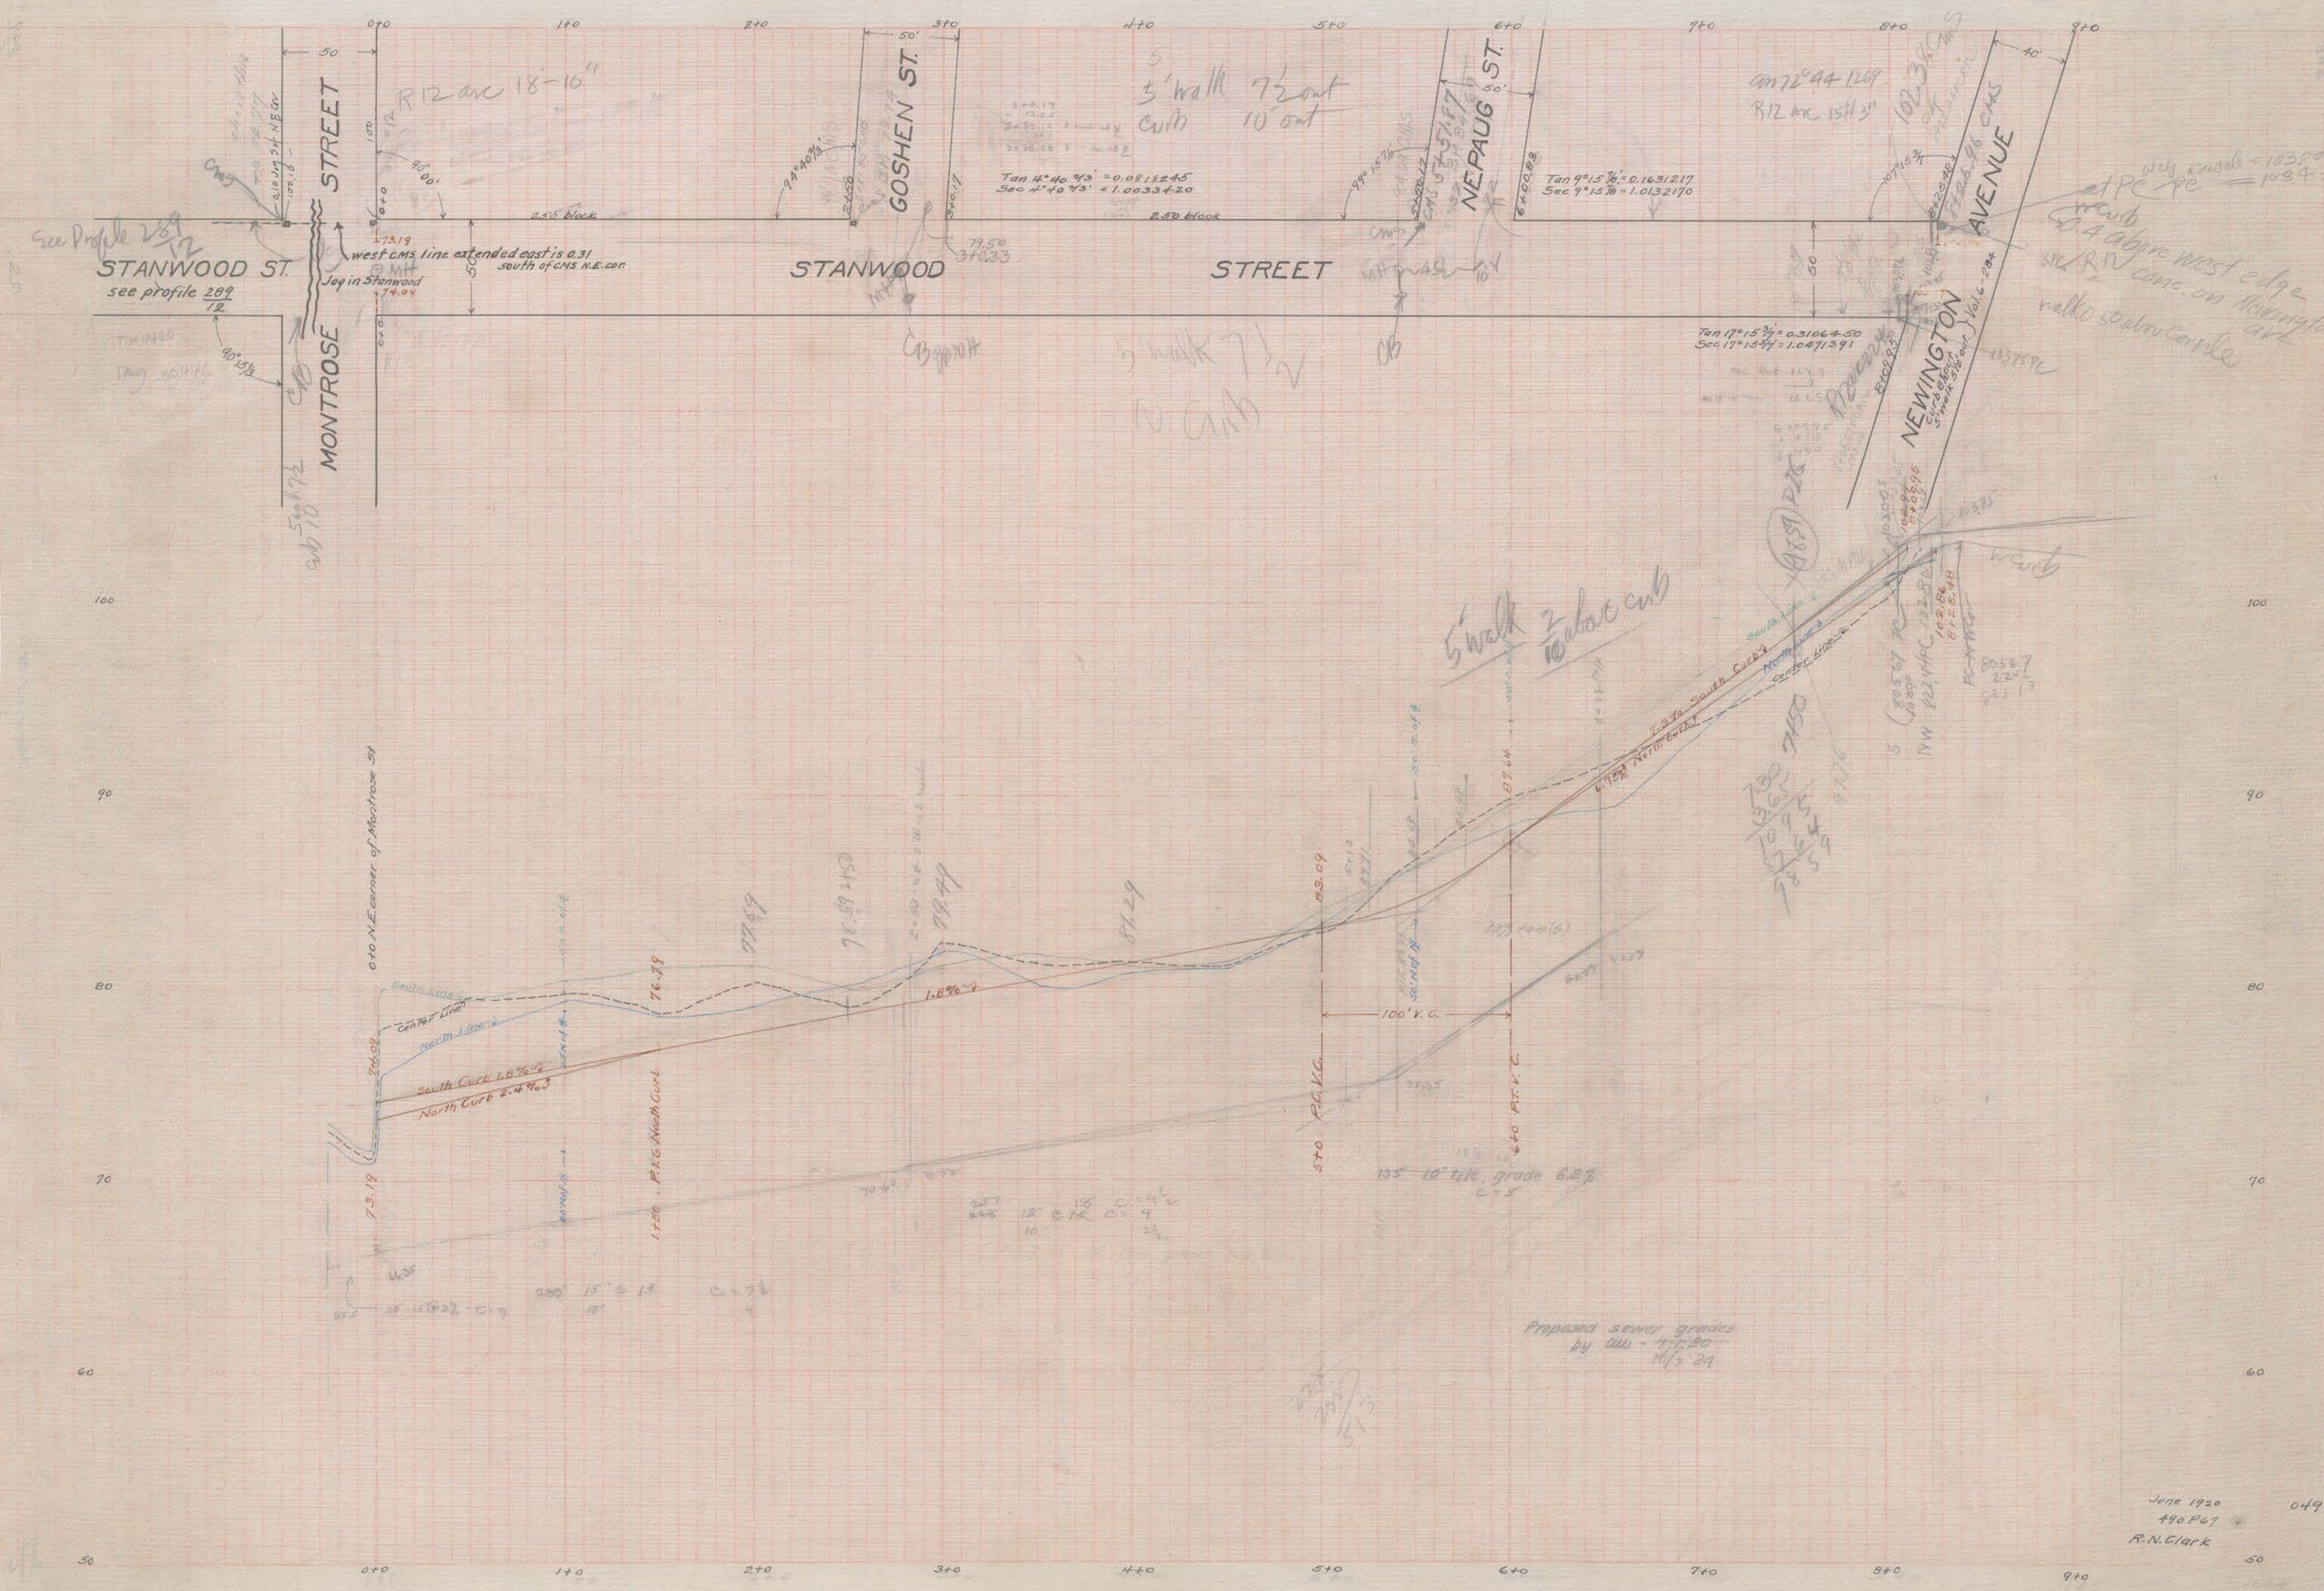
STANWOOD ST.
see profile 289/12
MONTROSE STREET
GOSHEN ST.
STANWOOD STREET
NEPAUG ST.
NEWINGTON AVENUE
west CMS line extended east is 0.31 south of CMS N.E. cor.
Jog in Stanwood
2.55 block
2.50 block
Tan 4°40 4/3' = 0.0818245
Sec 4°40 4/3' = 1.0033420
Tan 9°15 7/16 = 0.1631217
Sec 9°15 7/16 = 1.0132170
Tan 17°15 3/4 = 0.3106450
Sec 17°15 3/4 = 1.0471391
R12 arc 18'-10"
R12 arc 15ft 3"
5' walk 7½ out
curb 10 out
5' walk 7½
10 curb
5' walk 2
10 face curb
South Line
Center Line
North Line
South Curb 1.8%
North Curb 2.4%
1.8%
P.V.C.
P.V.T.
100' V.C.
135' 10" Tile, grade 6.2%
Proposed sewer grades by aw - 7-7-20 10/7-29
June 1920
490 P67
R.N. Clark