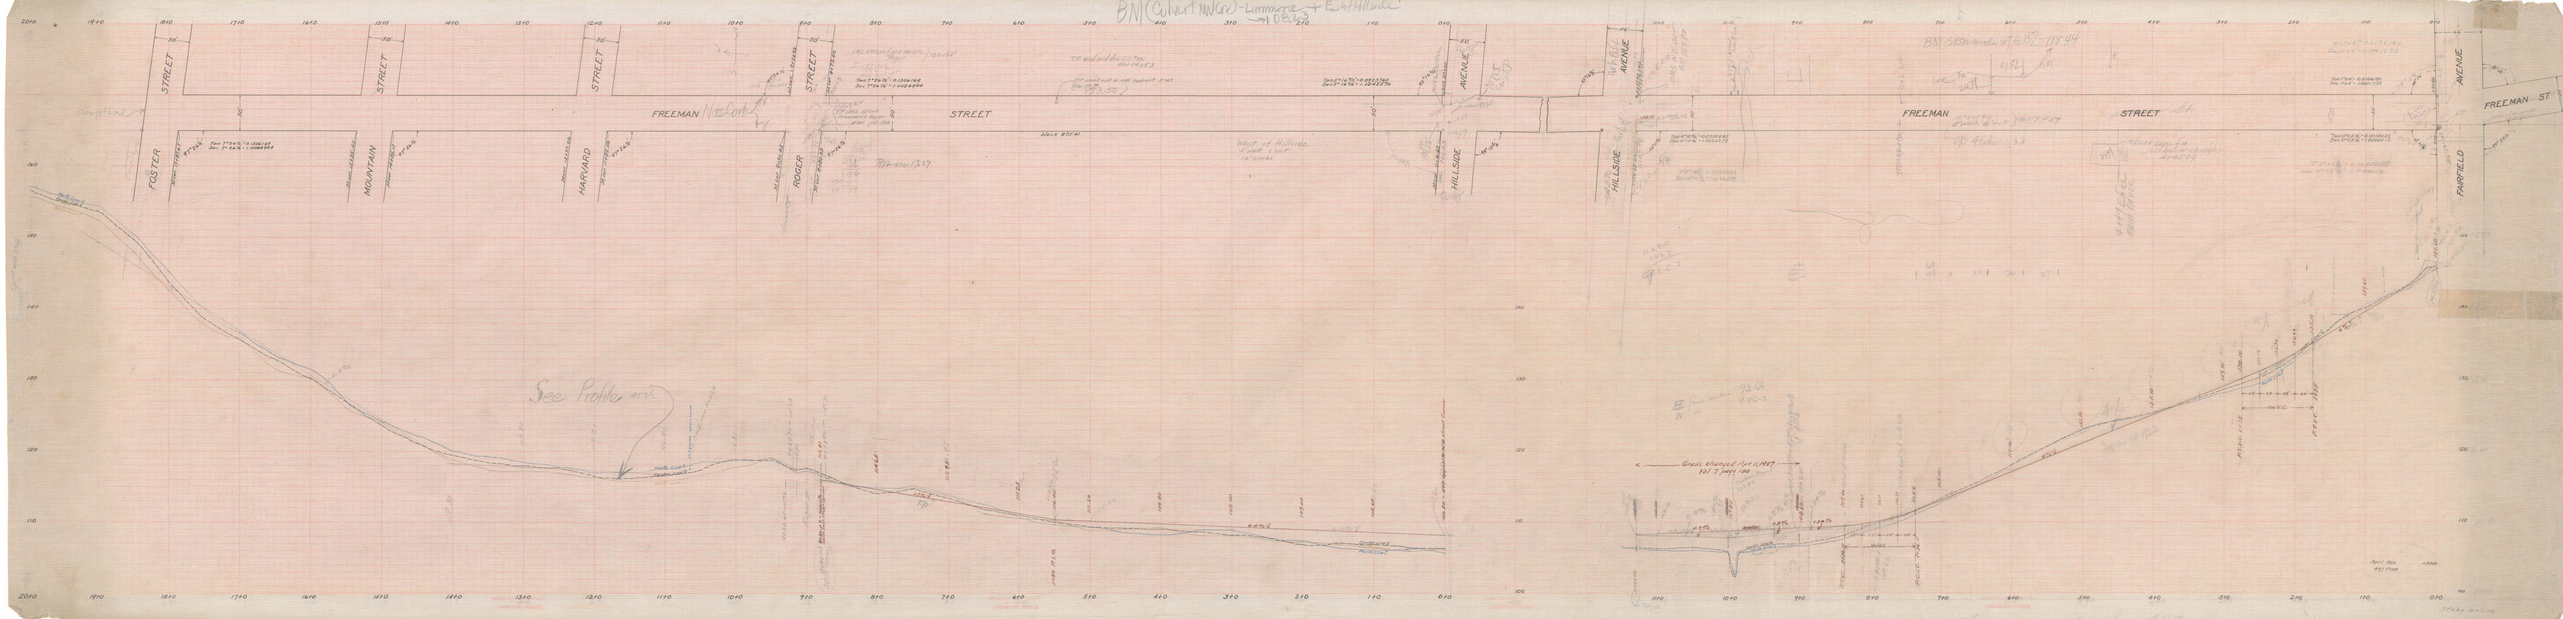
FOSTER STREET
MOUNTAIN STREET
HARVARD STREET
ROGER STREET
HILLSIDE AVENUE
FAIRFIELD AVENUE
FREEMAN STREET
FREEMAN ST
See Profile
Grade Changed Apr. 1937