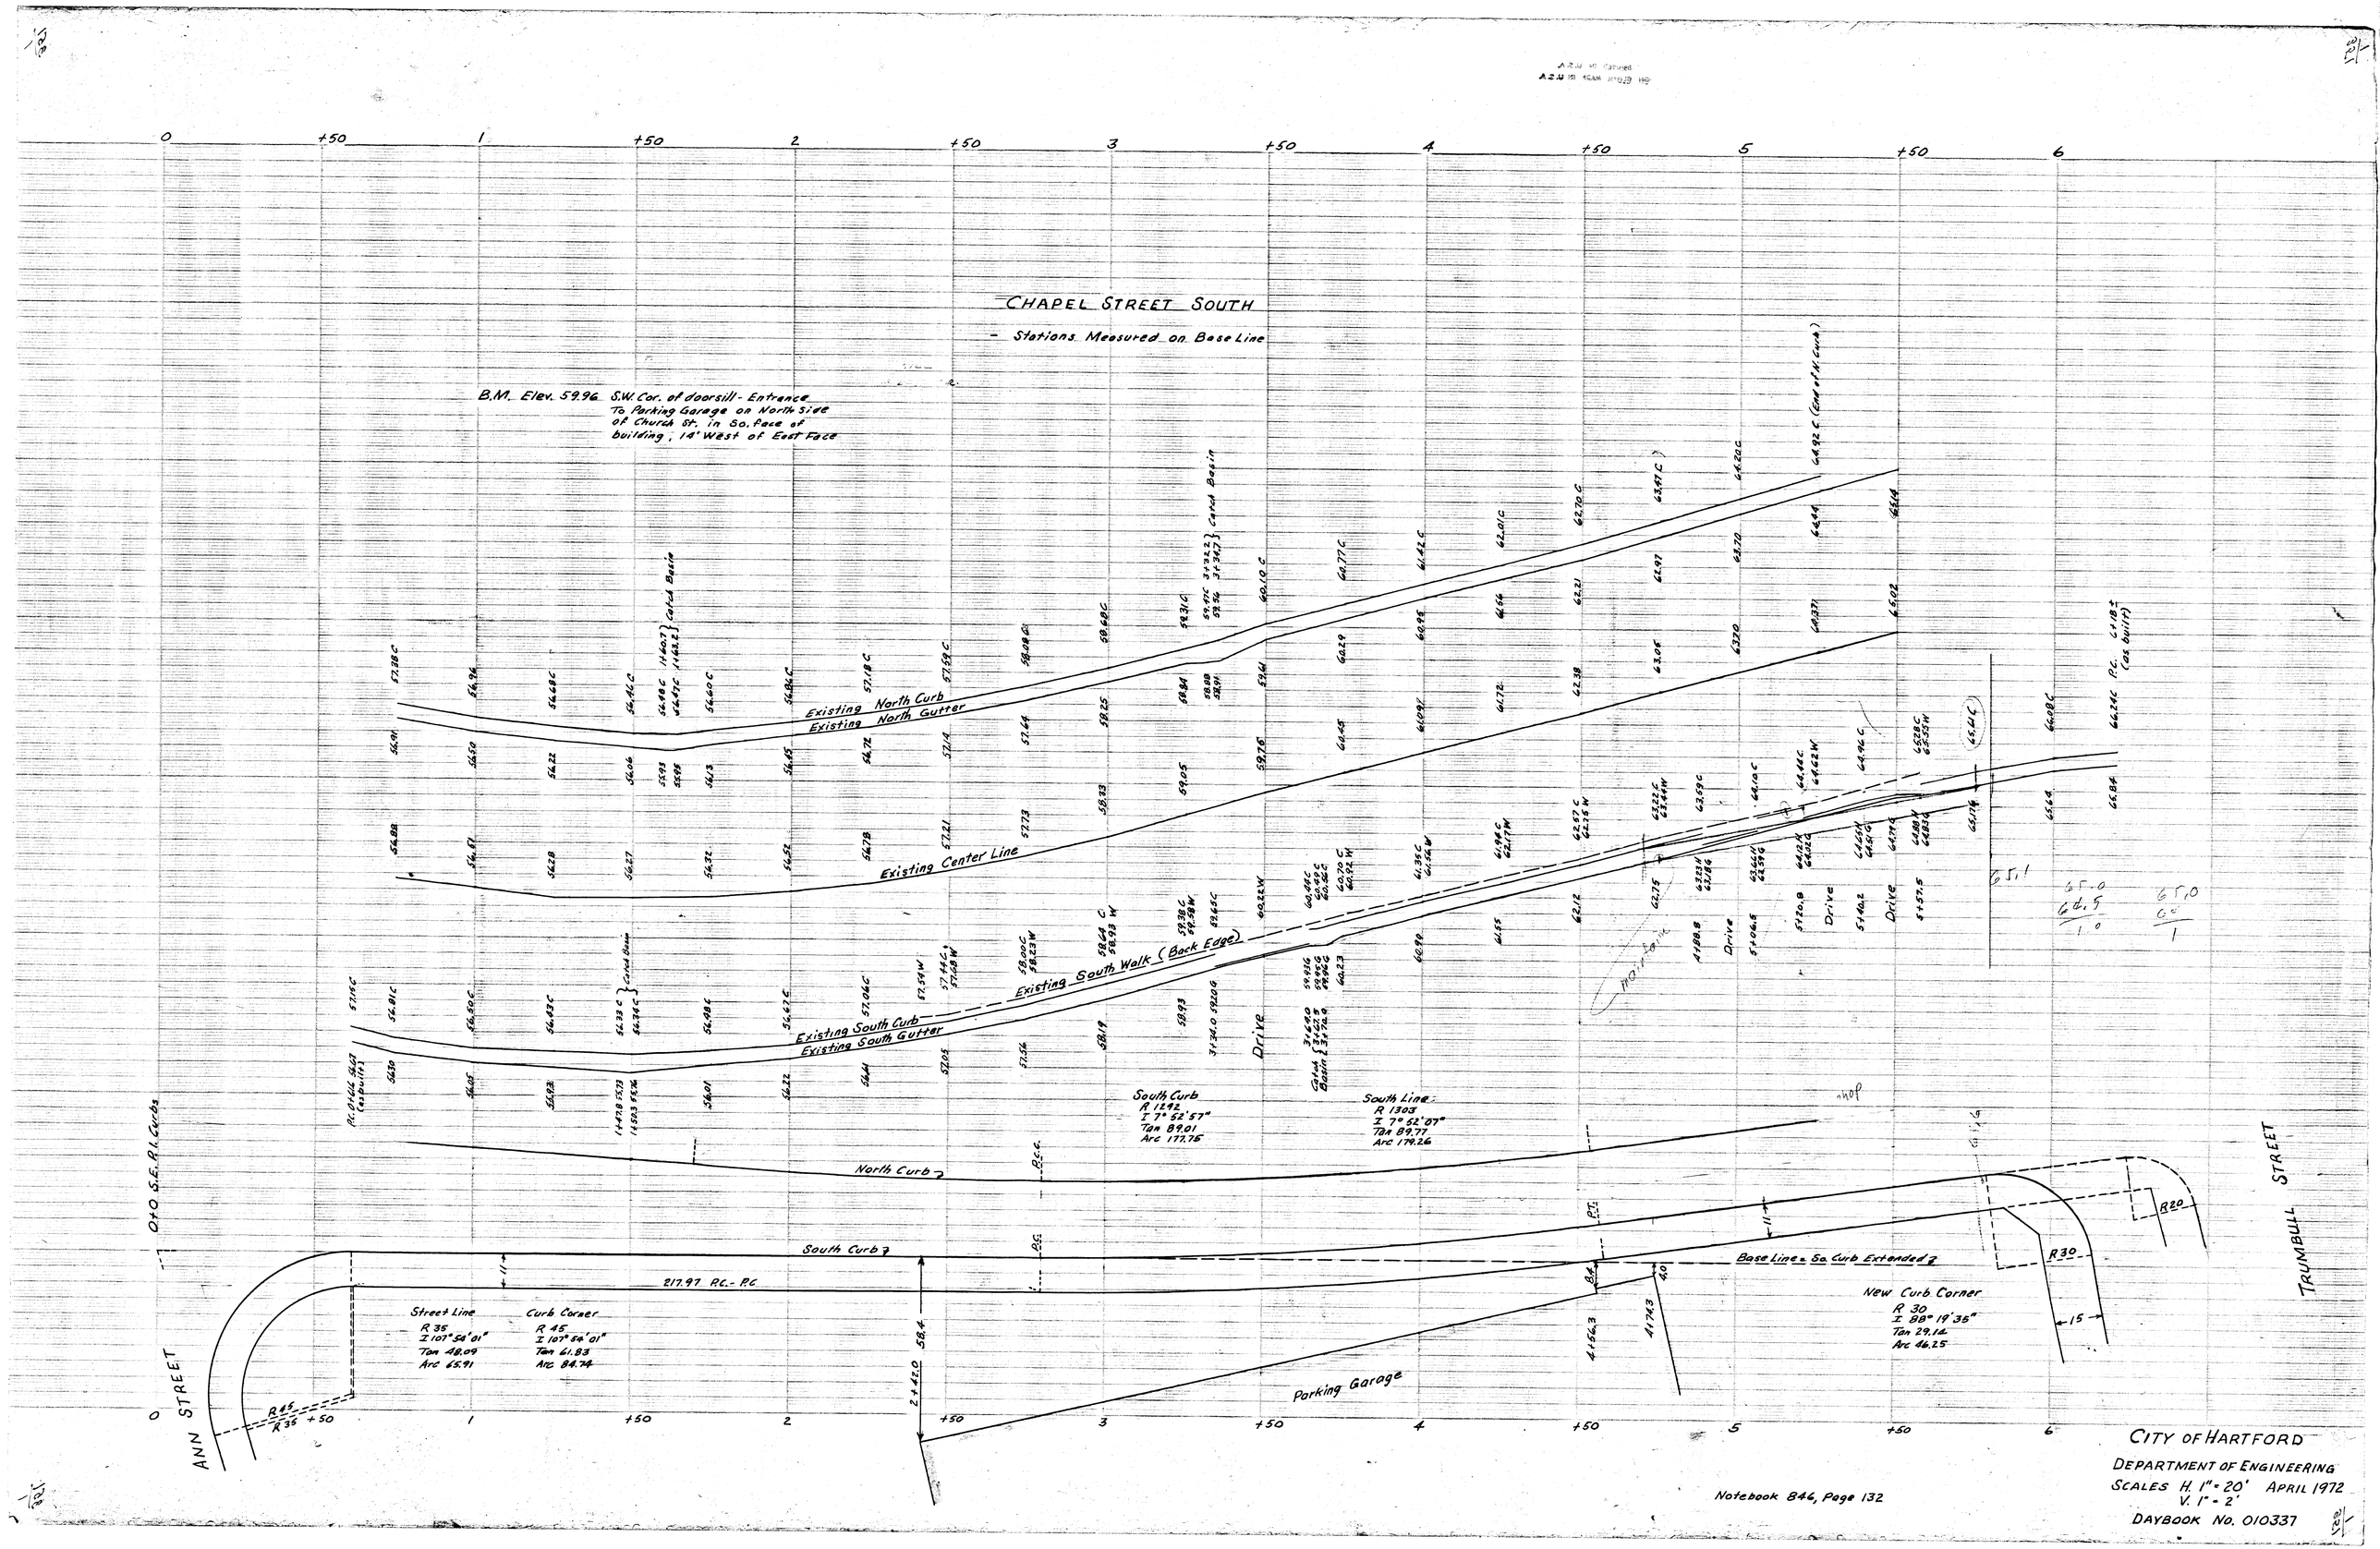

CITY OF HARTFORD

DEPARTMENT OF ENGINEERING

SCALES H. 1" = 20' V. 1" = 2'

APRIL 1972

DAYBOOK No. 010337

Notebook 846, Page 132