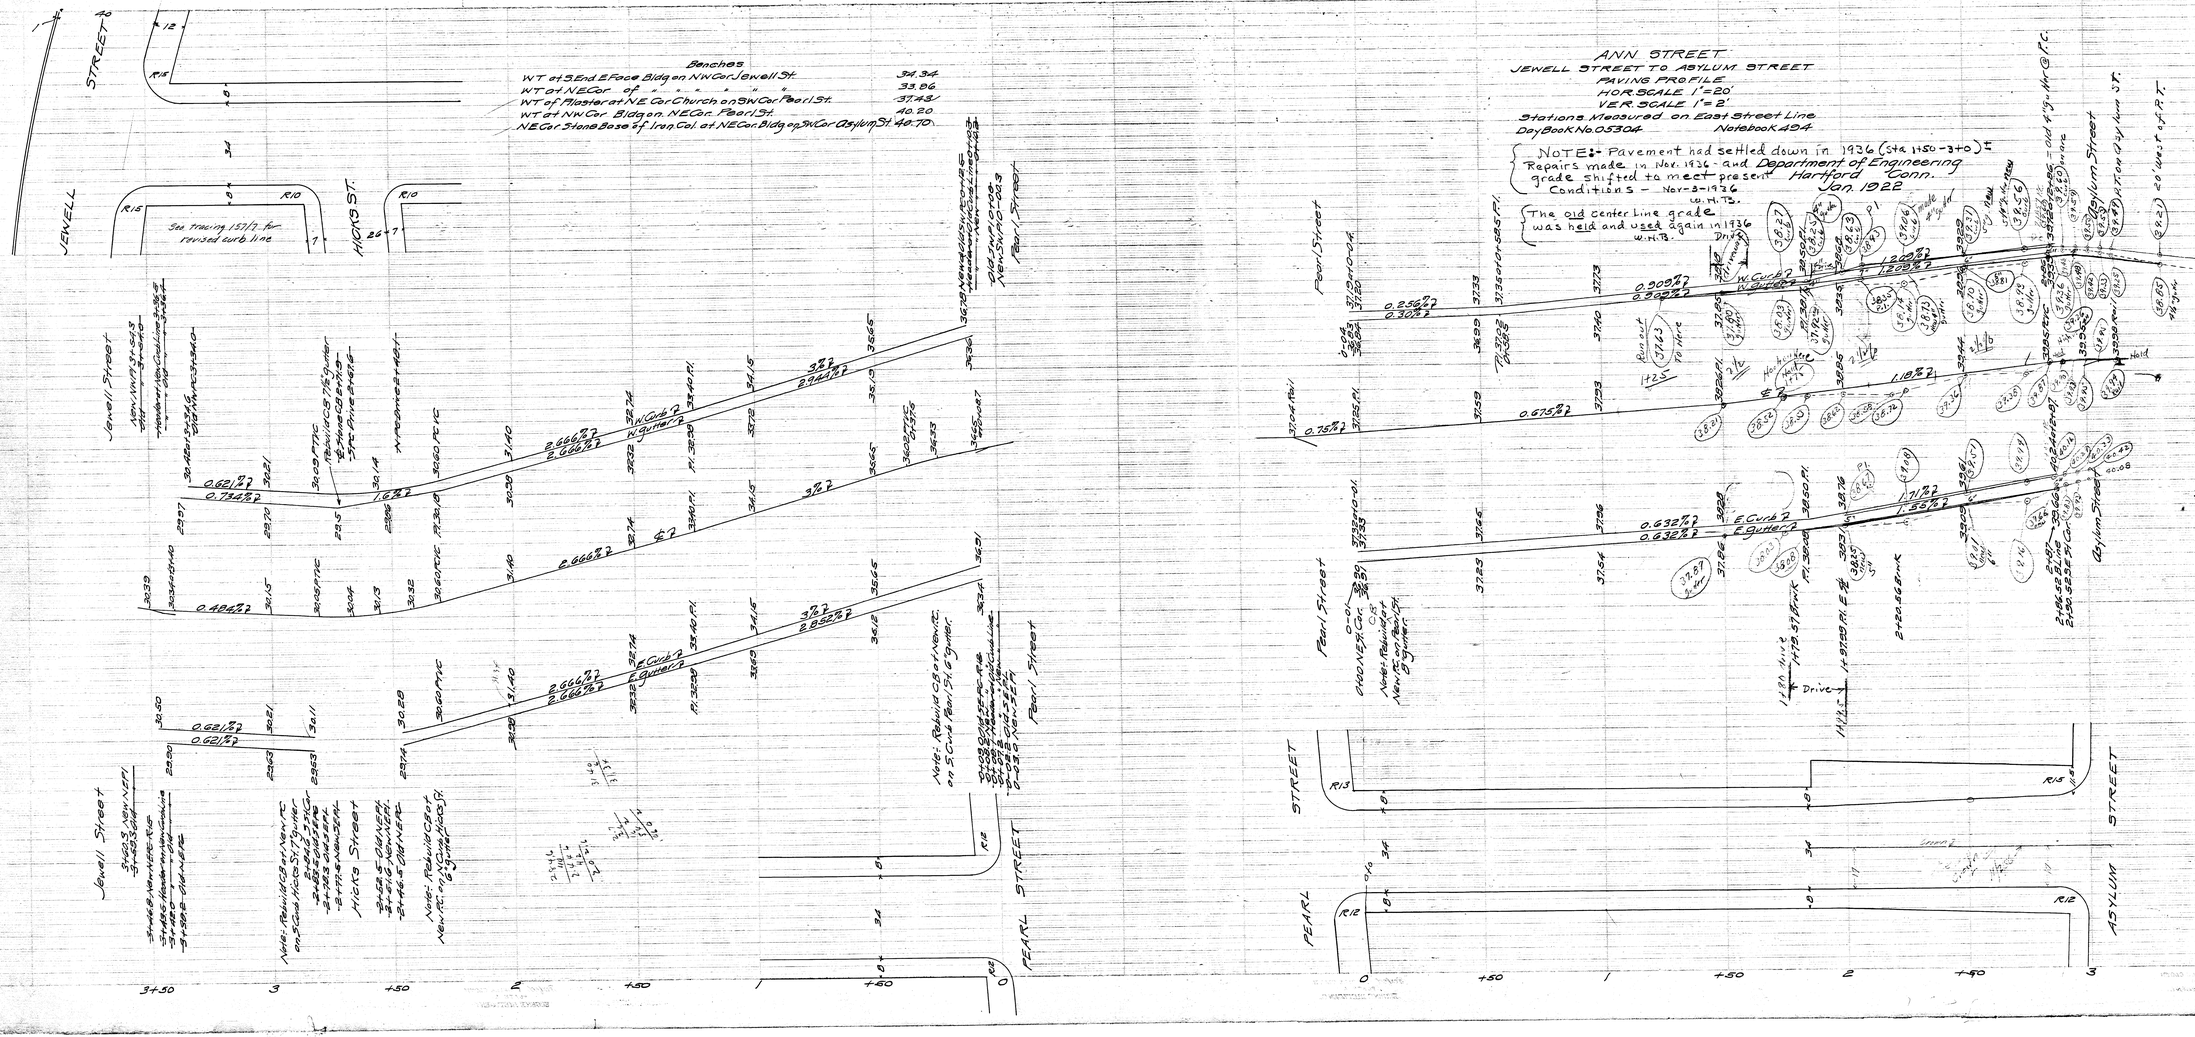
ANN STREET
JEWELL STREET TO ASYLUM STREET
HOR SCALE 1"=20'
VER SCALE 1"=2'
Stations Measured on East Street Line
Day Book No. 05304 Notebook 494
NOTE:- Pavement had settled down in 1936 (Sta. 1+50 - 3+00) ±
Repairs made in Nov. 1936 - and grade shifted to meet present conditions - Nov. 3 - 1936 W.H.B.
The old center line grade was held and used again in 1936 W.H.B.
Department of Engineering
Hartford Conn.
Jan. 1922
Benches
WT at S End E Face Bldg on NW Cor Jewell St. 34.34
WT at NE Cor " " " " " 33.86
WT of Plaster at NE Cor Church on SW Cor Pearl St. 37.43
WT at NW Cor Bldg on NE Cor Pearl St. 40.20
NE Cor Stone Base of Iron Col. at NE Cor Bldg on SW Cor Asylum St. 40.70
See tracing 1517/7 for revised curb line
Jewell Street
Hicks St.
Pearl Street
Asylum Street
JEWELL STREET
PEARL STREET
ASYLUM STREET
Note: Rebuild CB at New PC on S Curb Pearl St. & Gutter.
Note: Rebuild CB at New PC New Pr. on N Curb Hicks St. & Gutter.
Note: Rebuild CB at New PC on S Curb Hicks St. & Gutter.
Note: Rebuild CB at New PC New Pr. on N Curb Pearl St. & Gutter.
Drive
Hold
3+50
3
+50
2
+50
1
+50
0