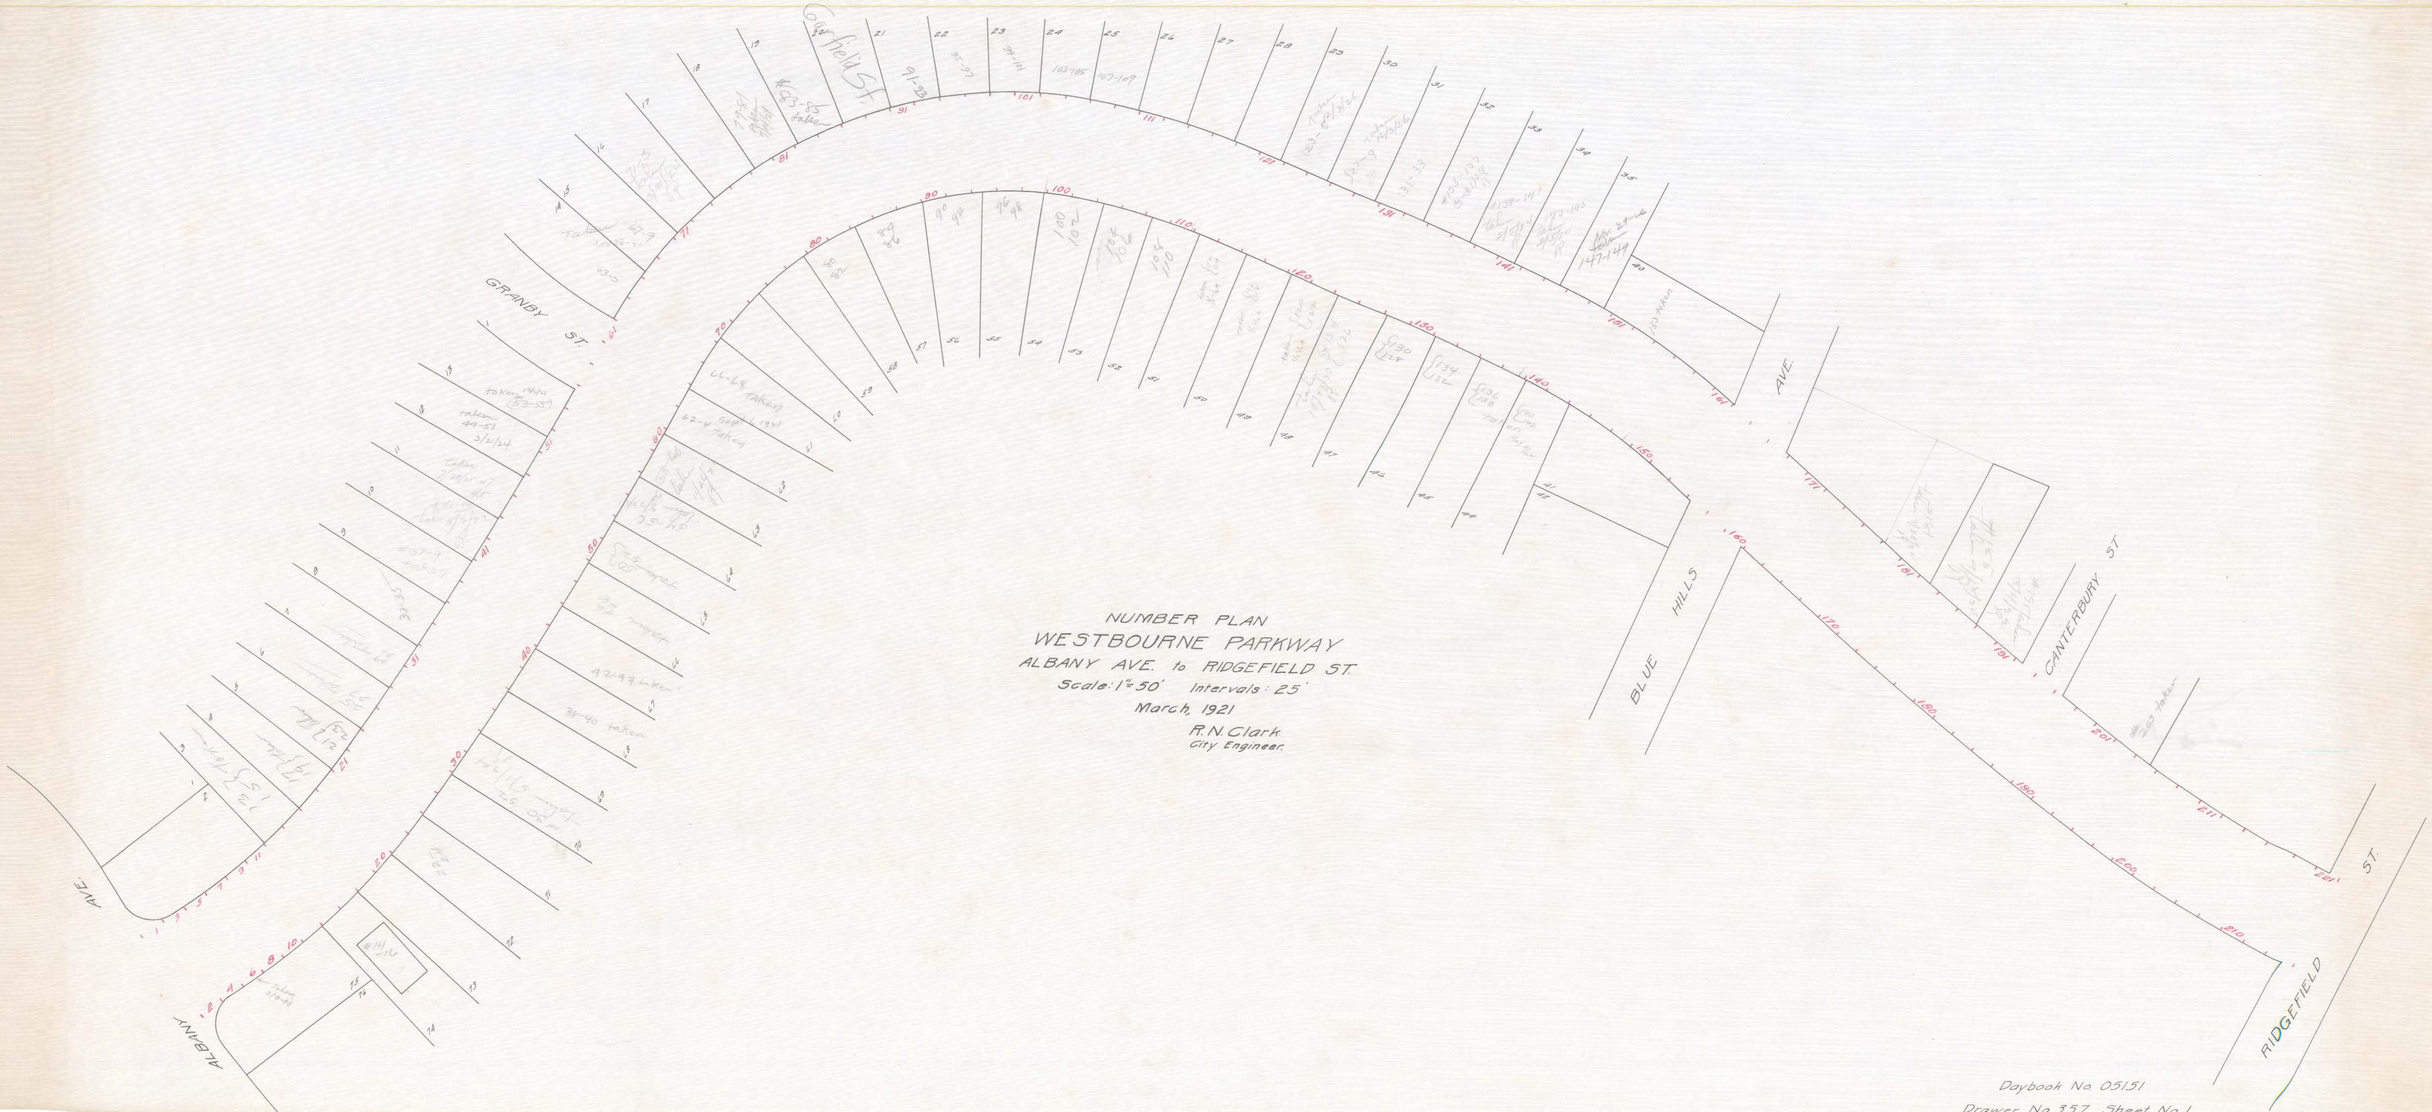

Daybook No 05151
Drawer No 357 Sheet No 1