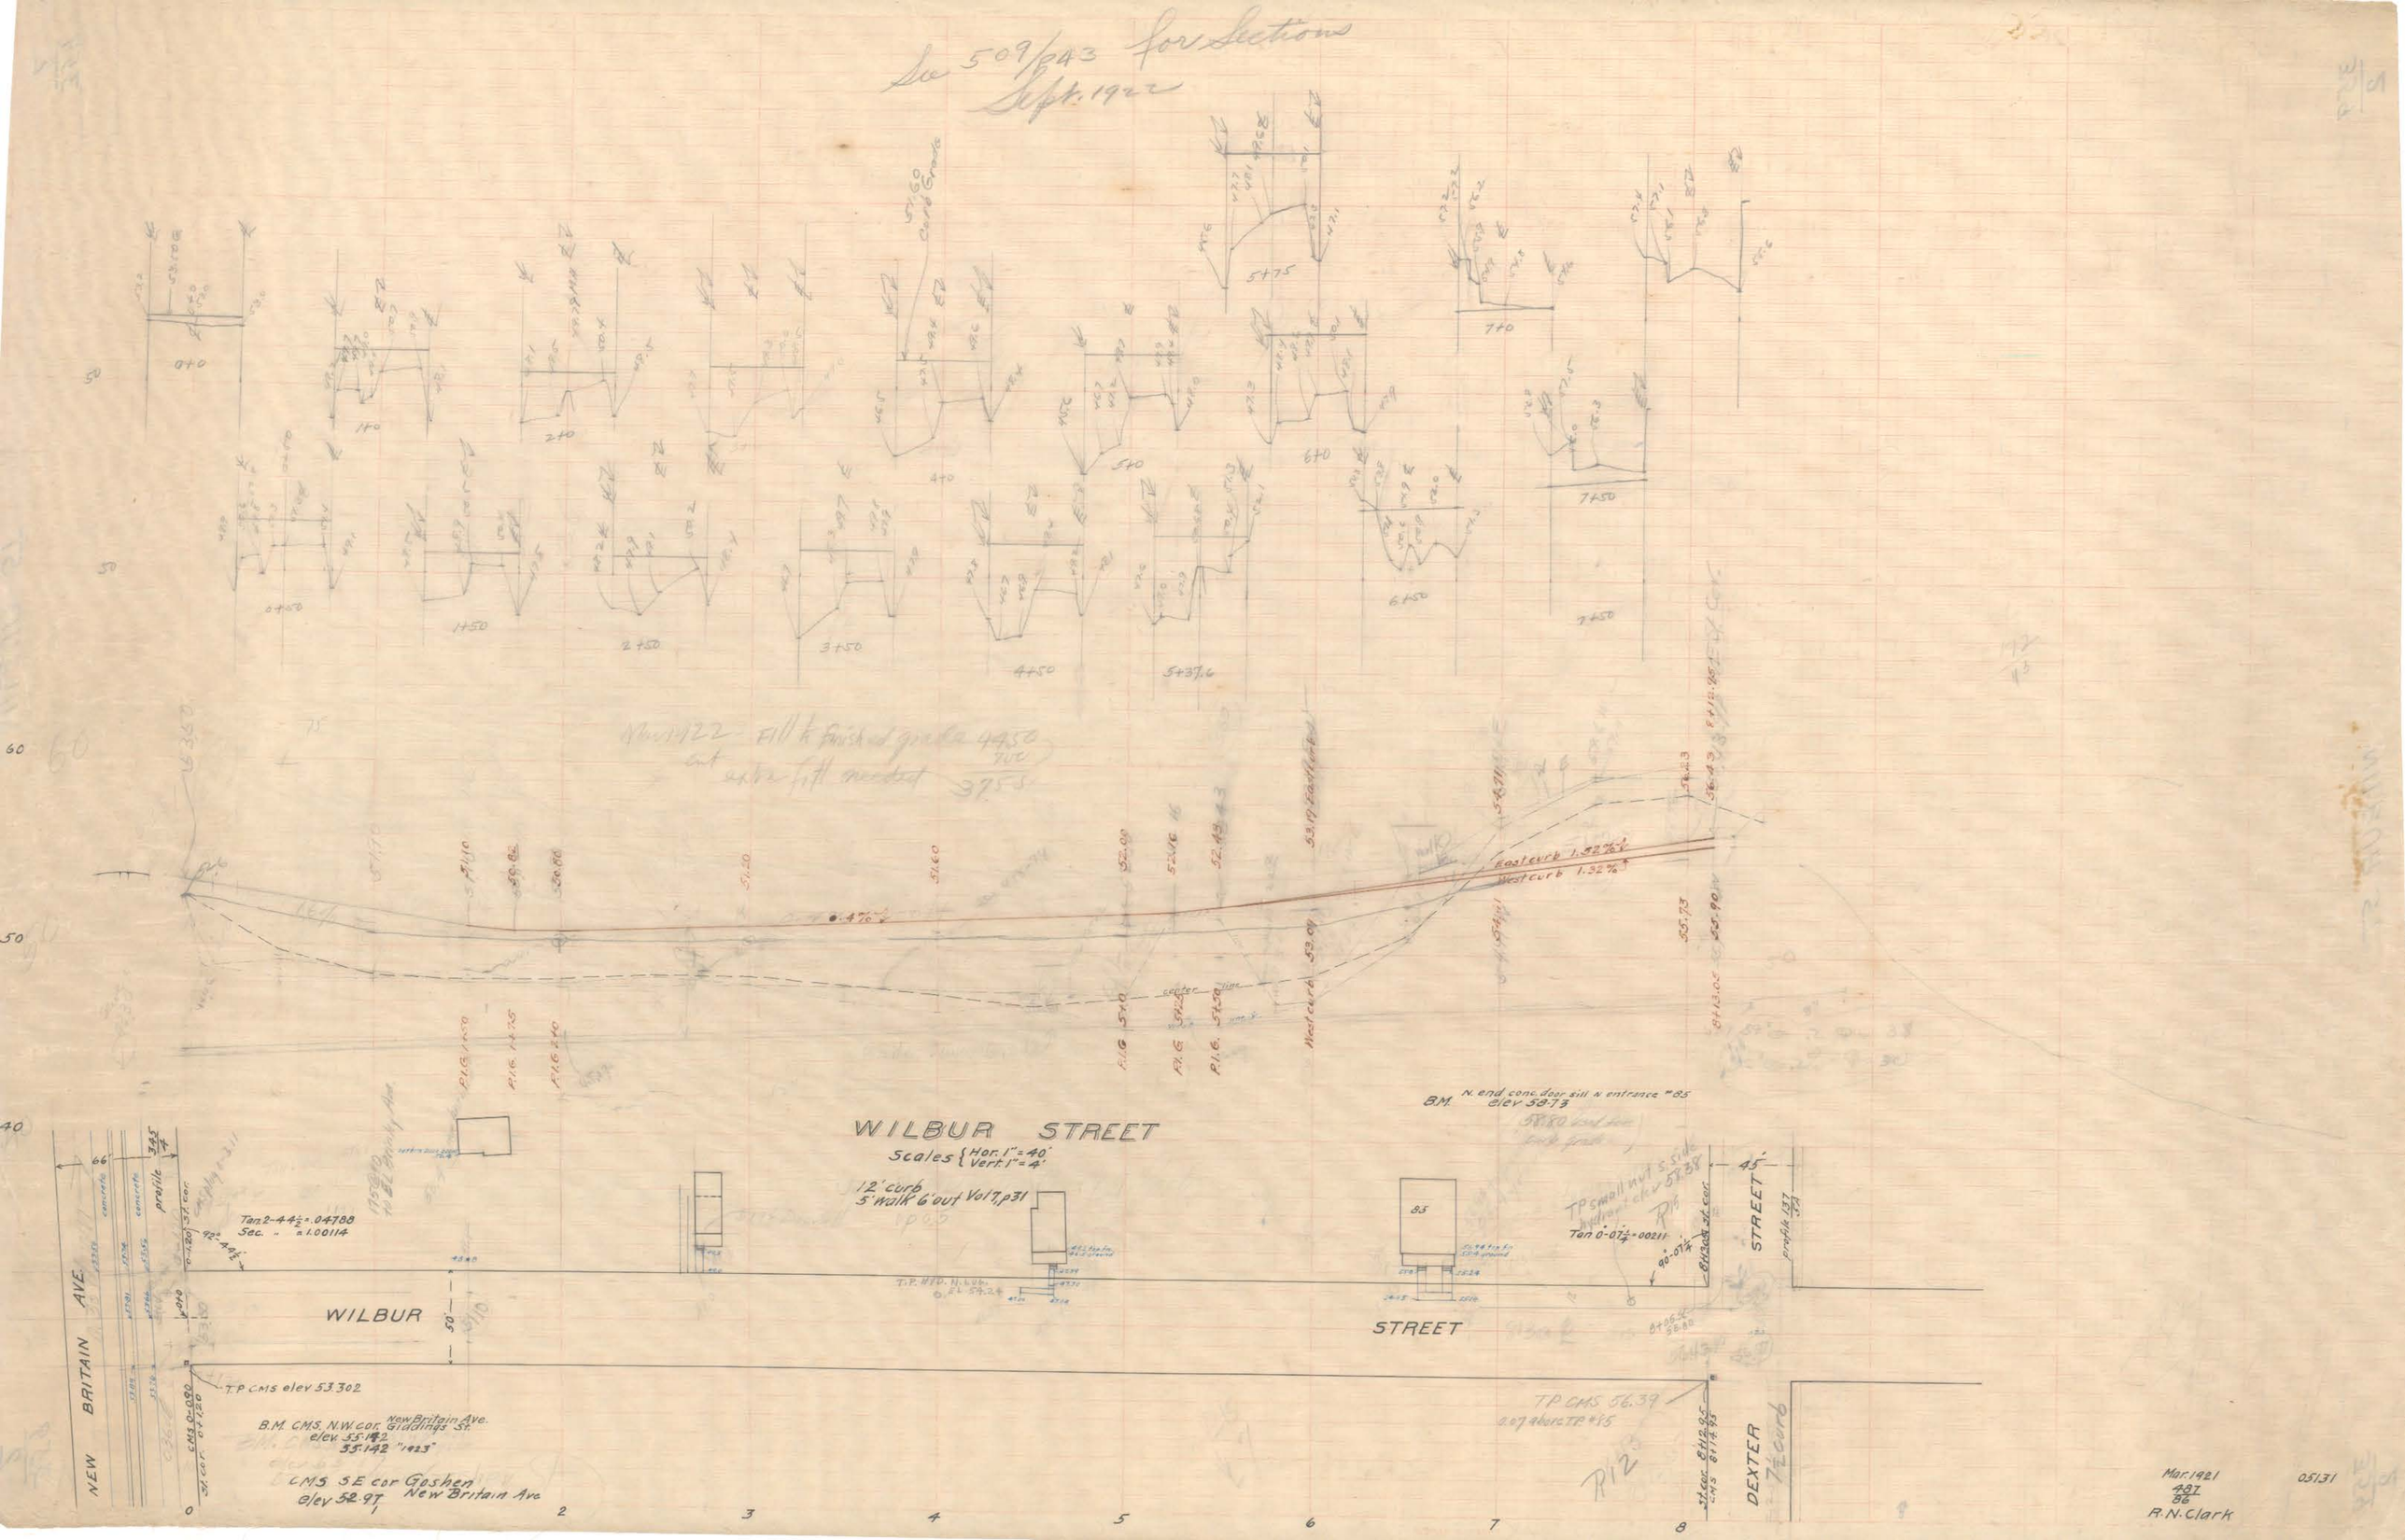See 509/p43 for sections
Sept. 1922