


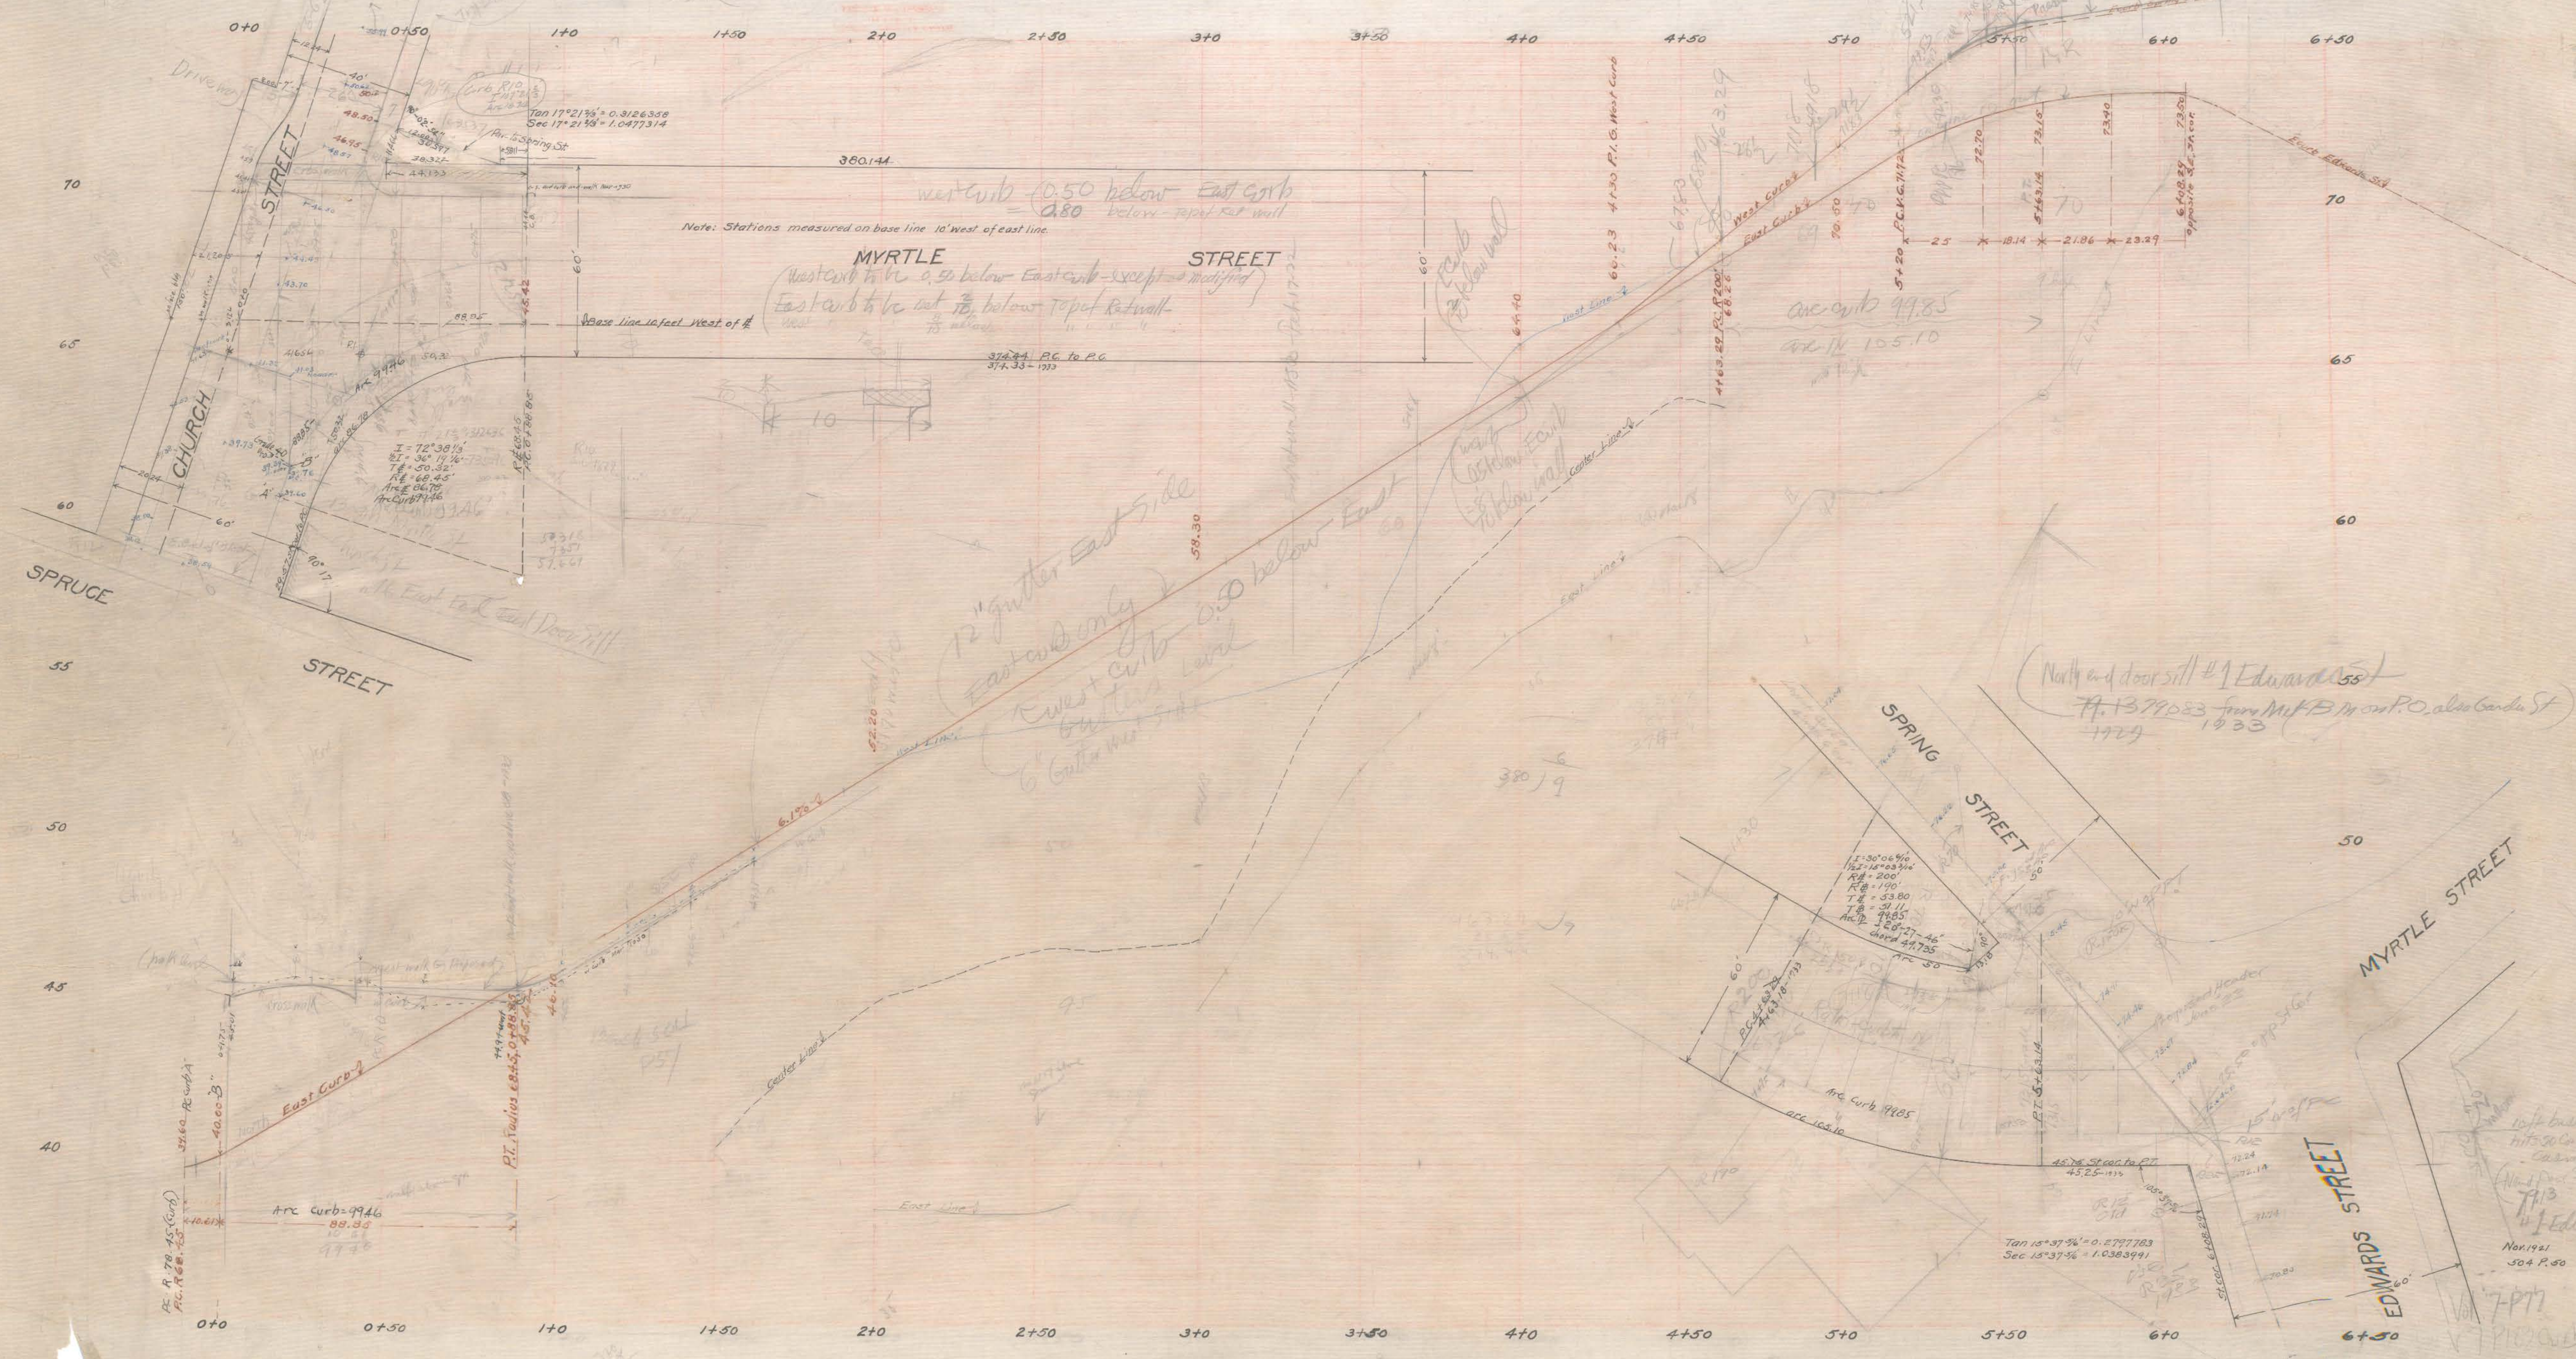

west curb 0.50 below East curb
below - top of rat wall

Note: Stations measured on base line 10' west of east line.

MYRTLE STREET
(west curb to be 0.50 below East curb - except as modified)
(East curb to be cut 10' below Top of Rat wall)

12" gutter East side
East curb only
West curb 0.50 below East curb
6" gutter west side

North end door sill #1 Edwards St
H. B. 79083 from M. B. M. on P.O. also Garden St
1929

Nov. 1921
50 + P. 50

Vol. 7 P. 77
V. 7 P. 100