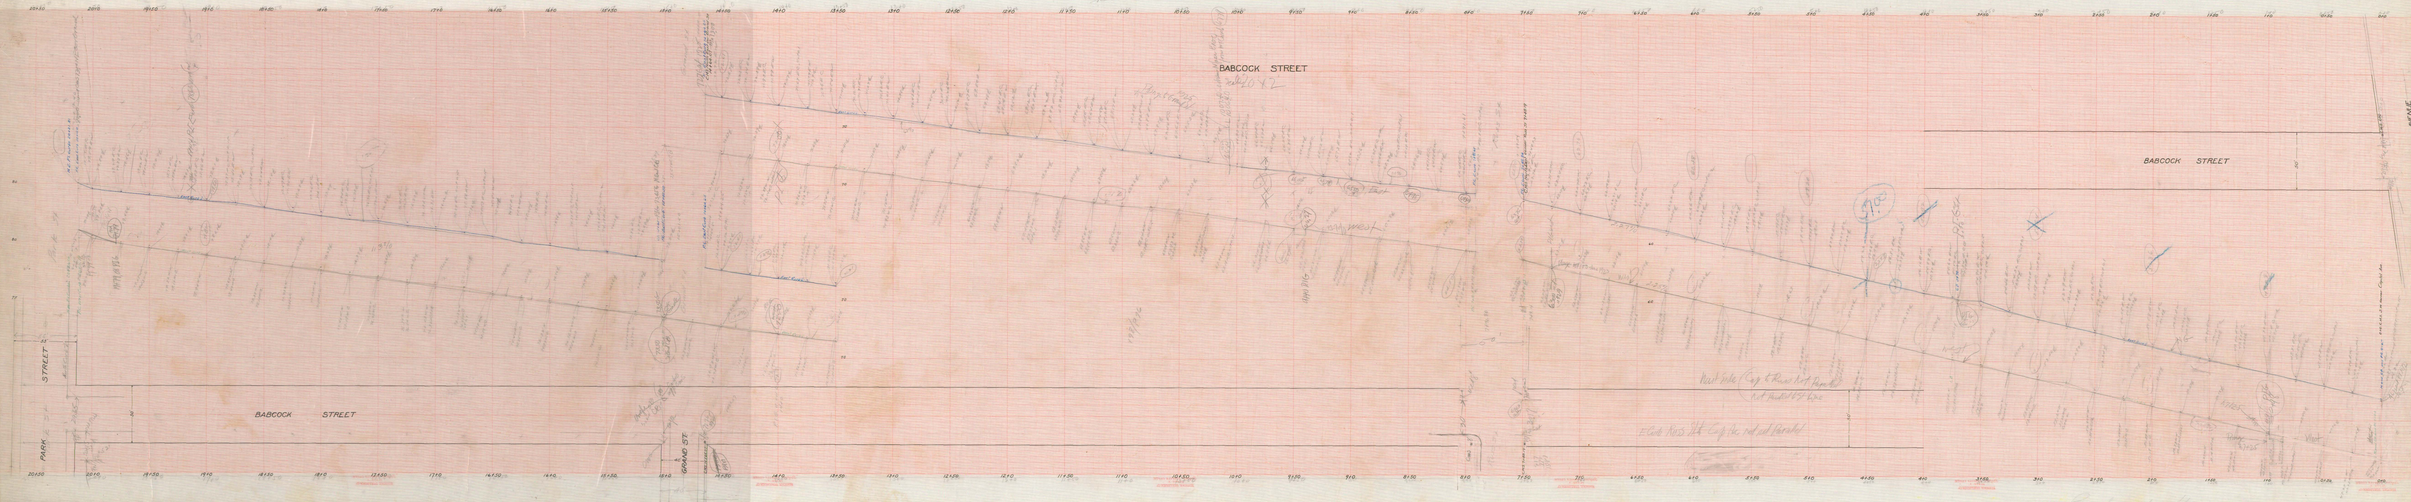
BABCOCK STREET
BABCOCK STREET
BABCOCK STREET
PARK STREET
GRAND ST
CAPITOL AVENUE