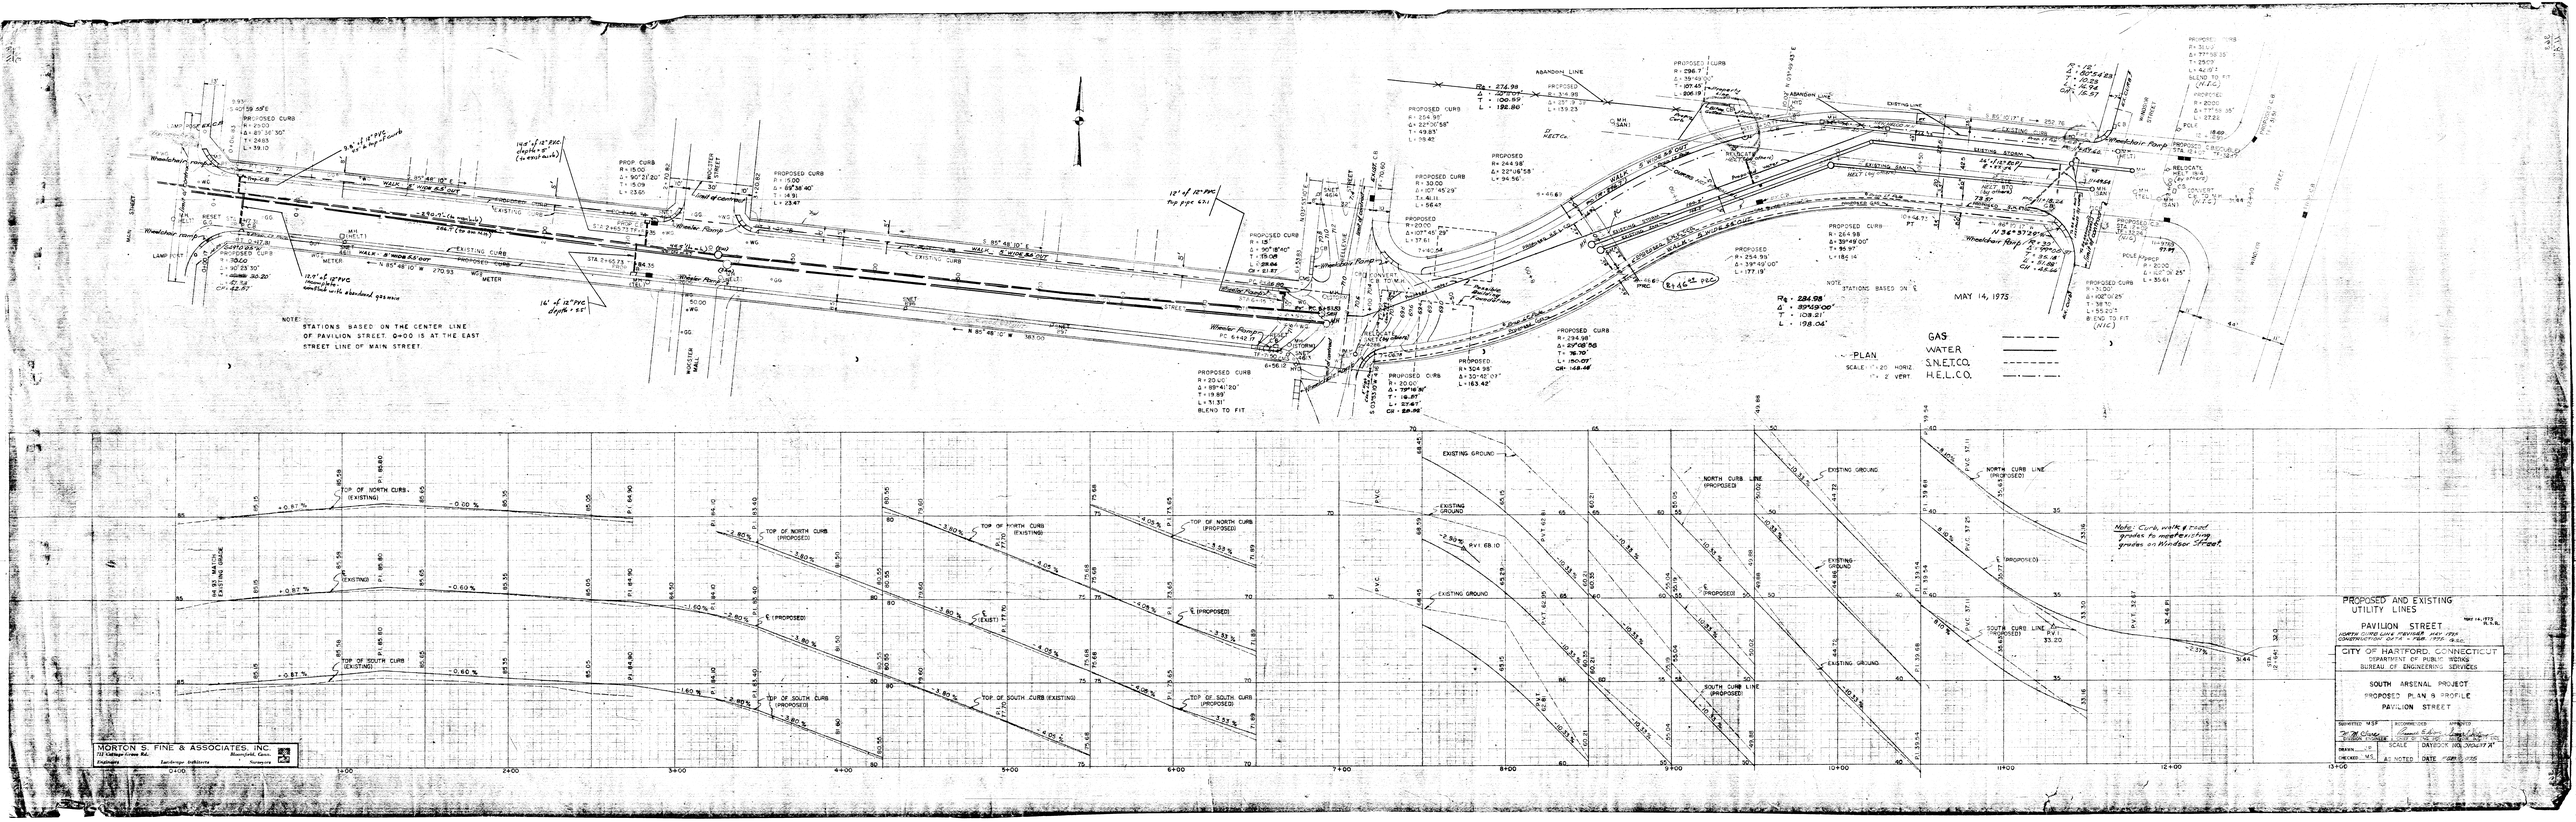
NOTE: STATIONS BASED ON THE CENTER LINE OF PAVILION STREET. 0+00 IS AT THE EAST STREET LINE OF MAIN STREET.
MAY 14, 1975
PLAN
SCALE: 1" = 20' HORIZ.
1" = 2' VERT.
GAS
WATER
S.N.E.T.CO.
H.E.L.CO.
PROPOSED AND EXISTING UTILITY LINES
PAVILION STREET
CITY OF HARTFORD, CONNECTICUT
DEPARTMENT OF PUBLIC WORKS
BUREAU OF ENGINEERING SERVICES
SOUTH ARSENAL PROJECT
PROPOSED PLAN & PROFILE
PAVILION STREET
MORTON S. FINE & ASSOCIATES, INC.