


JEFFERSON

STREET

see later revision, curb layout - trac. 210/44

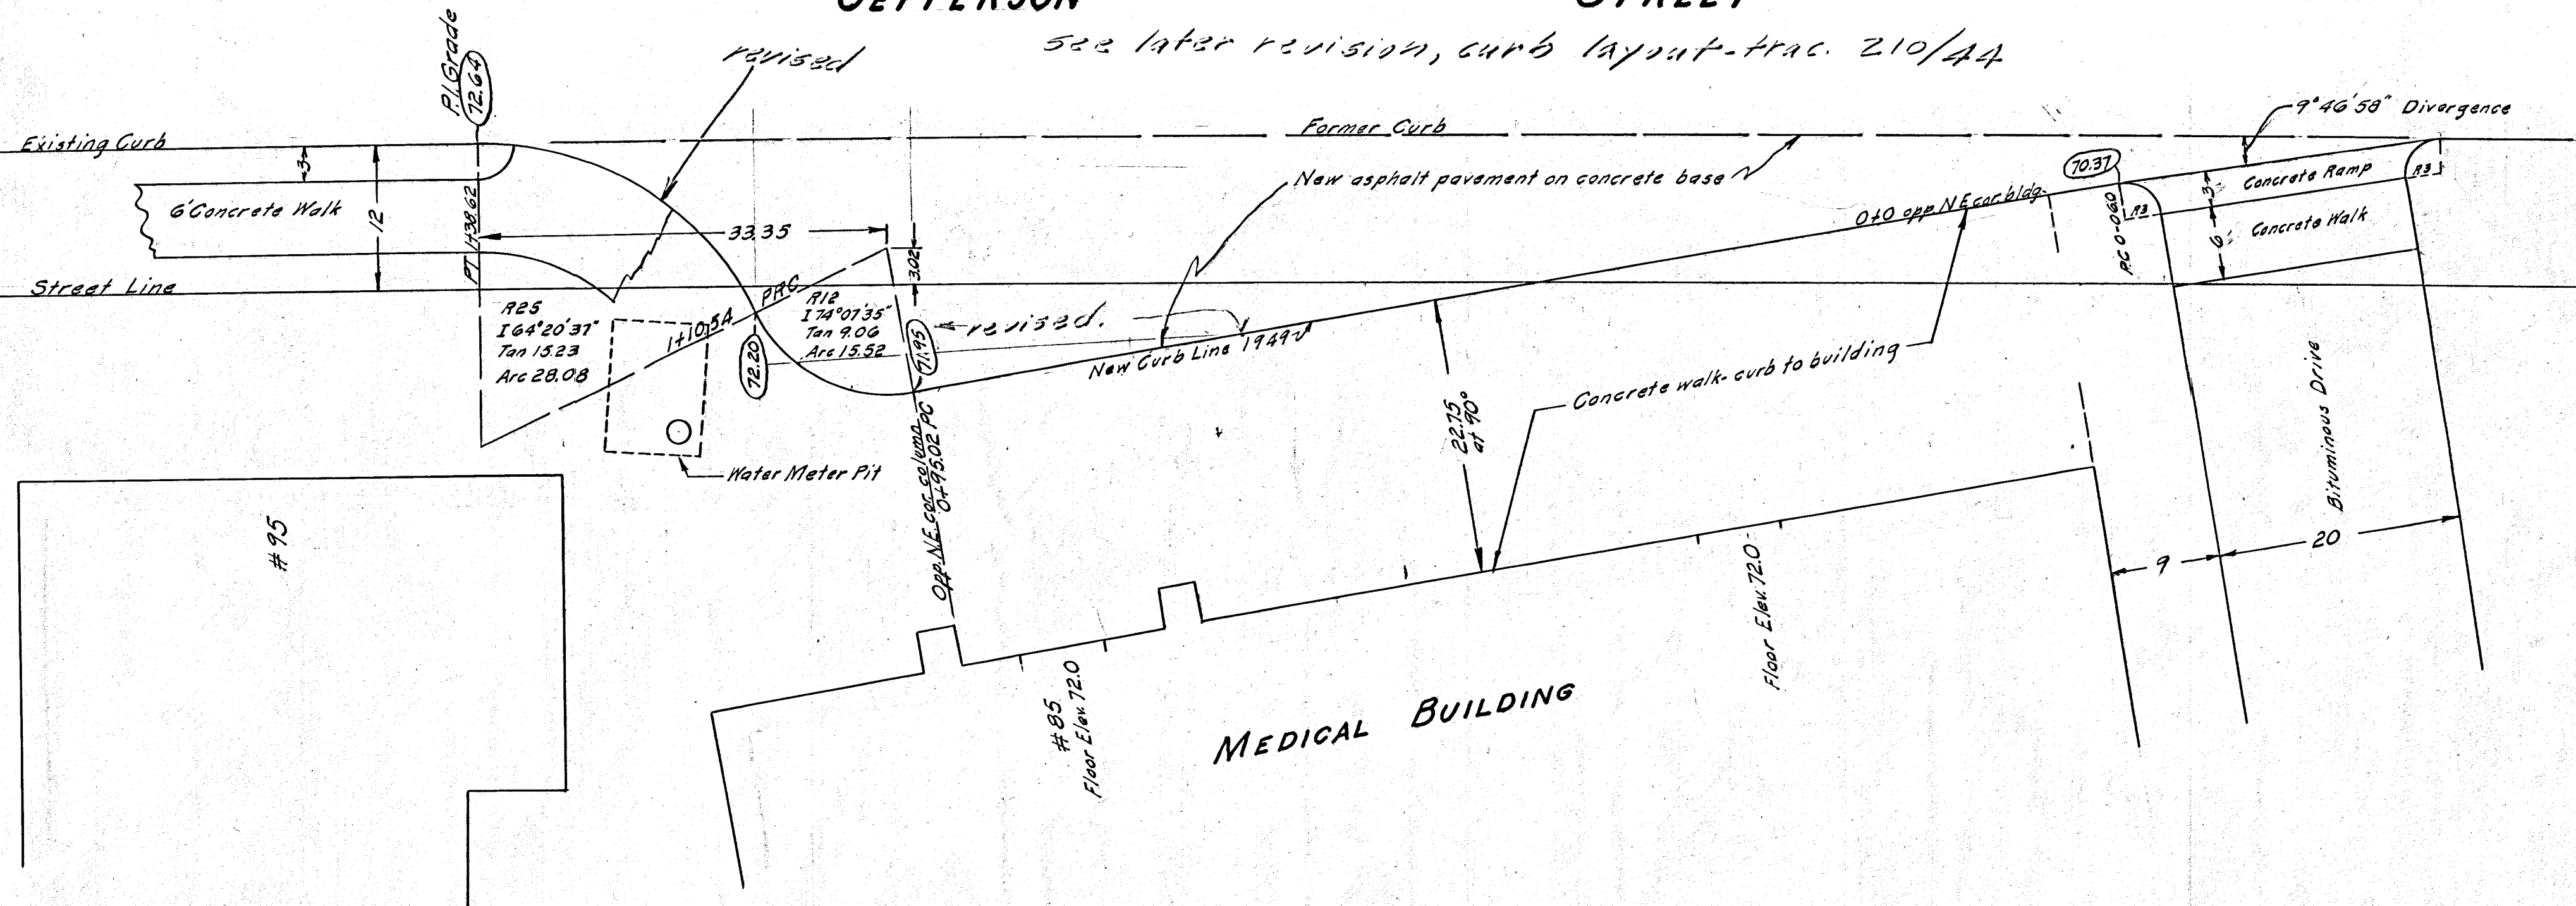

NOTES-779, P.133

see agreement
Apr. 20, 1949 (Public Works
Director's Office)

CITY OF HARTFORD
DEPARTMENT OF ENGINEERING
SCALE - 1" = 10' SEPTEMBER 1949