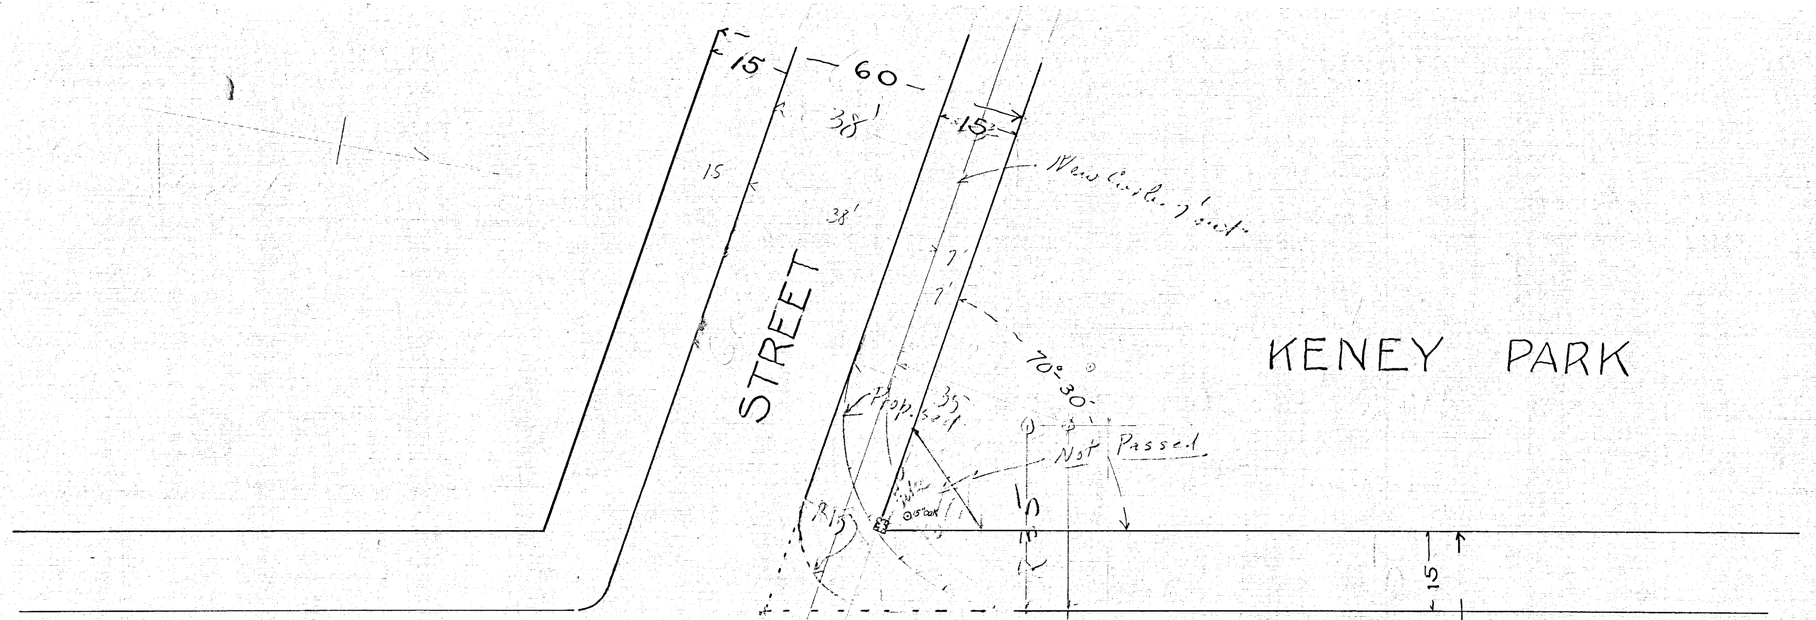

Daybook No. 06258

Scale 1" = 20'

1927