

N.Y. N.H. & H. R.R. CO.
VALLEY BRANCH

NOTE: East Line 99 Feet West
of Center Line of Railroad.




CURVE DATA
I = 14° 55' 07"
R = 2009.08
D = 2° 51' 07"
T = 263.05
LC = 523.10

ELIZABETH B. KELSEY

ALFRED L. TURGEON

AIRPORT ROAD

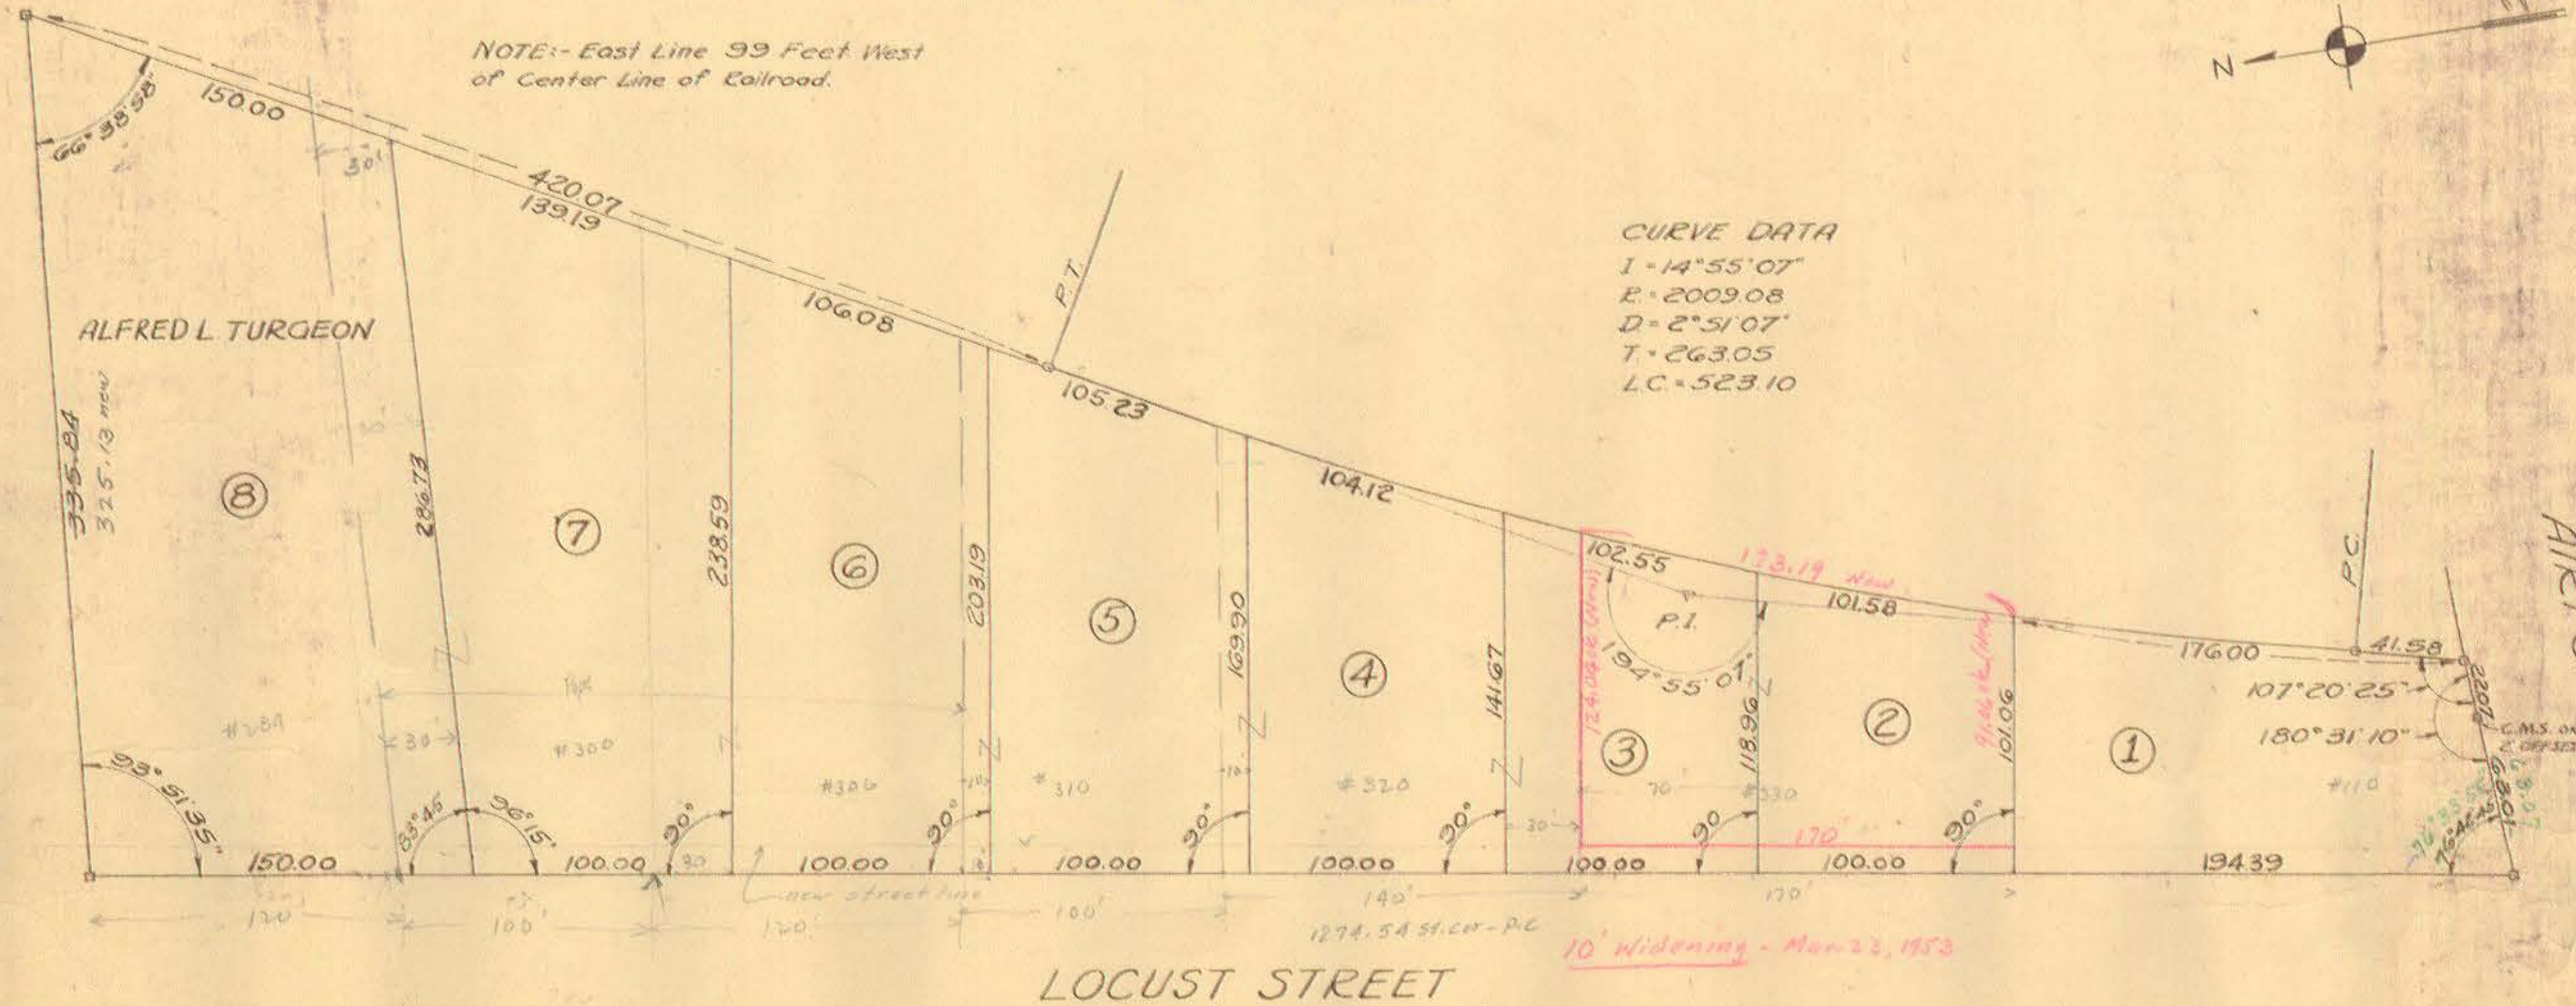

LOCUST STREET

PLAN OF LAND
belonging to
ISAAC NASSAU
HARTFORD, CONN.

SUBDIVISION MADE
FEBRUARY 18, 1952

Scale, 1 in. = 50 feet - May 15, 1946

Benjamin Bialick
Land Surveyor