


North line of property is 2.00 south of and parallel to south line of Raymond St.
538.38

City of Hartford

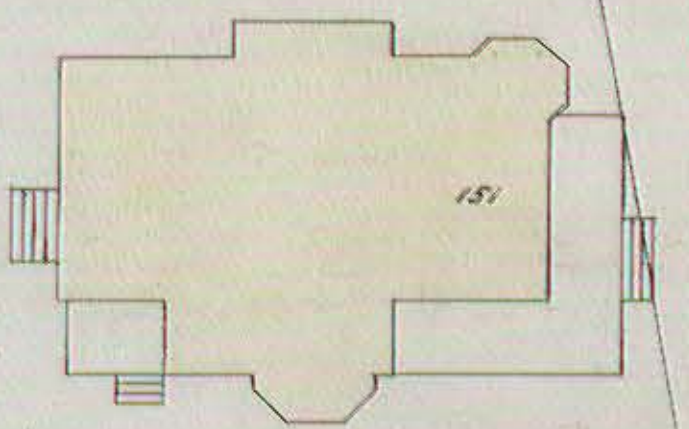

551.77

STREET

VINE

Direction of Flow

Building Line

Yard Line

Telephone Ditch

12" Water Main

80" Fire Water

6" Gas Main

H.E. Co. Ditch

Nov 1931
07382
Notes 575-P126

North Line Greenfield St 9

128.72-145.75 to N. Greenfield St. stop

72.11

90° 01' 15"

90° 03' 05"