




Edward S. McCann

M. Shapiro & Son
Const. Co. Inc

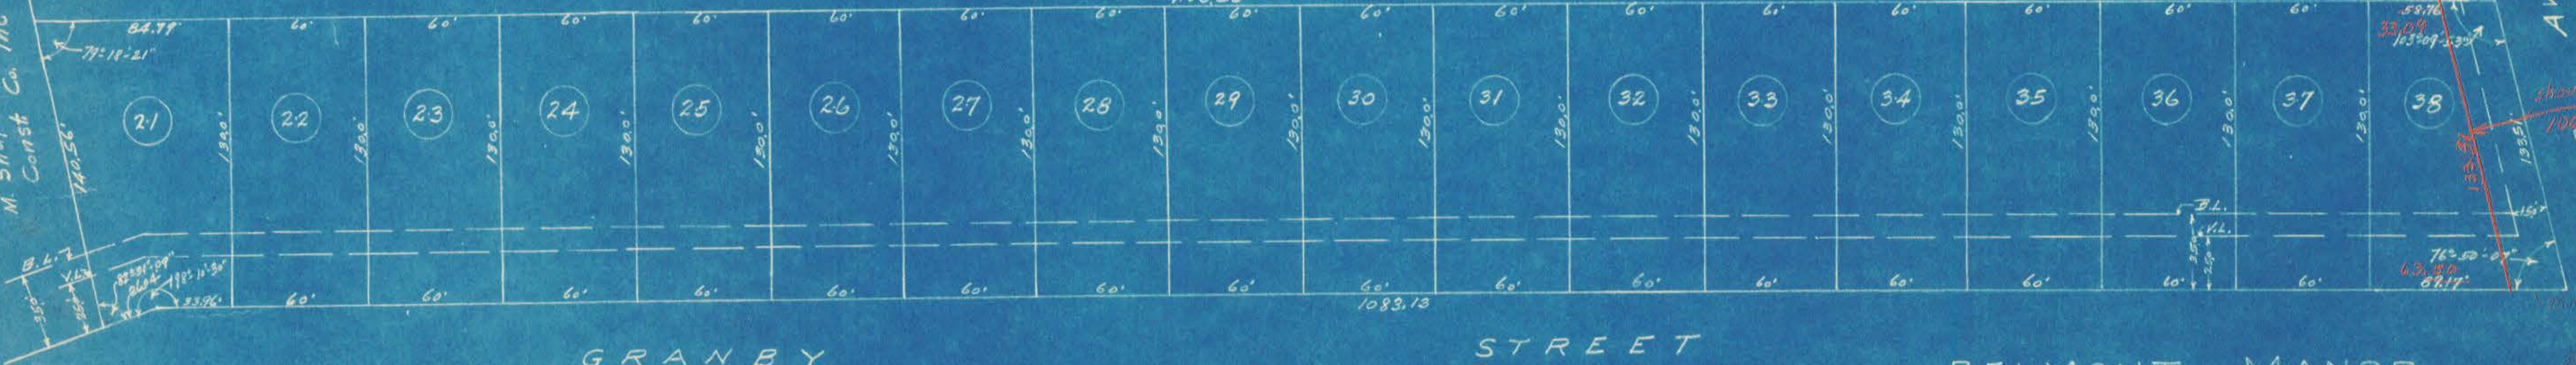

GRANBY

STREET

BELMONT MANOR

PROPERTY OF
BELMONT INCORPORATED
GRANBY STREET

I hereby certify that this map is substantially correct.
F. Perry Close
Civil Engineer

HARTFORD
SCALE 1" = 40'

CONNECTICUT
MAR. 1953

F. PERRY CLOSE
CIVIL AND CONSULTING ENGINEER
HARTFORD, CONN.

AVE.
TOWER
street line
of May 25, 1953
should be
100' wide