

181
311


181
311



North $\frac{1}{2}$ Data
R = 927.93'
 $\Delta = 9^\circ 56' 27''$
L = 161.00'
T = 80.70'

South $\frac{1}{2}$ Data
R = 983.93'
 $\Delta = 6^\circ 19' 51''$
L = 108.72'
T = 54.41'

R = 983.93'
R = 927.93'

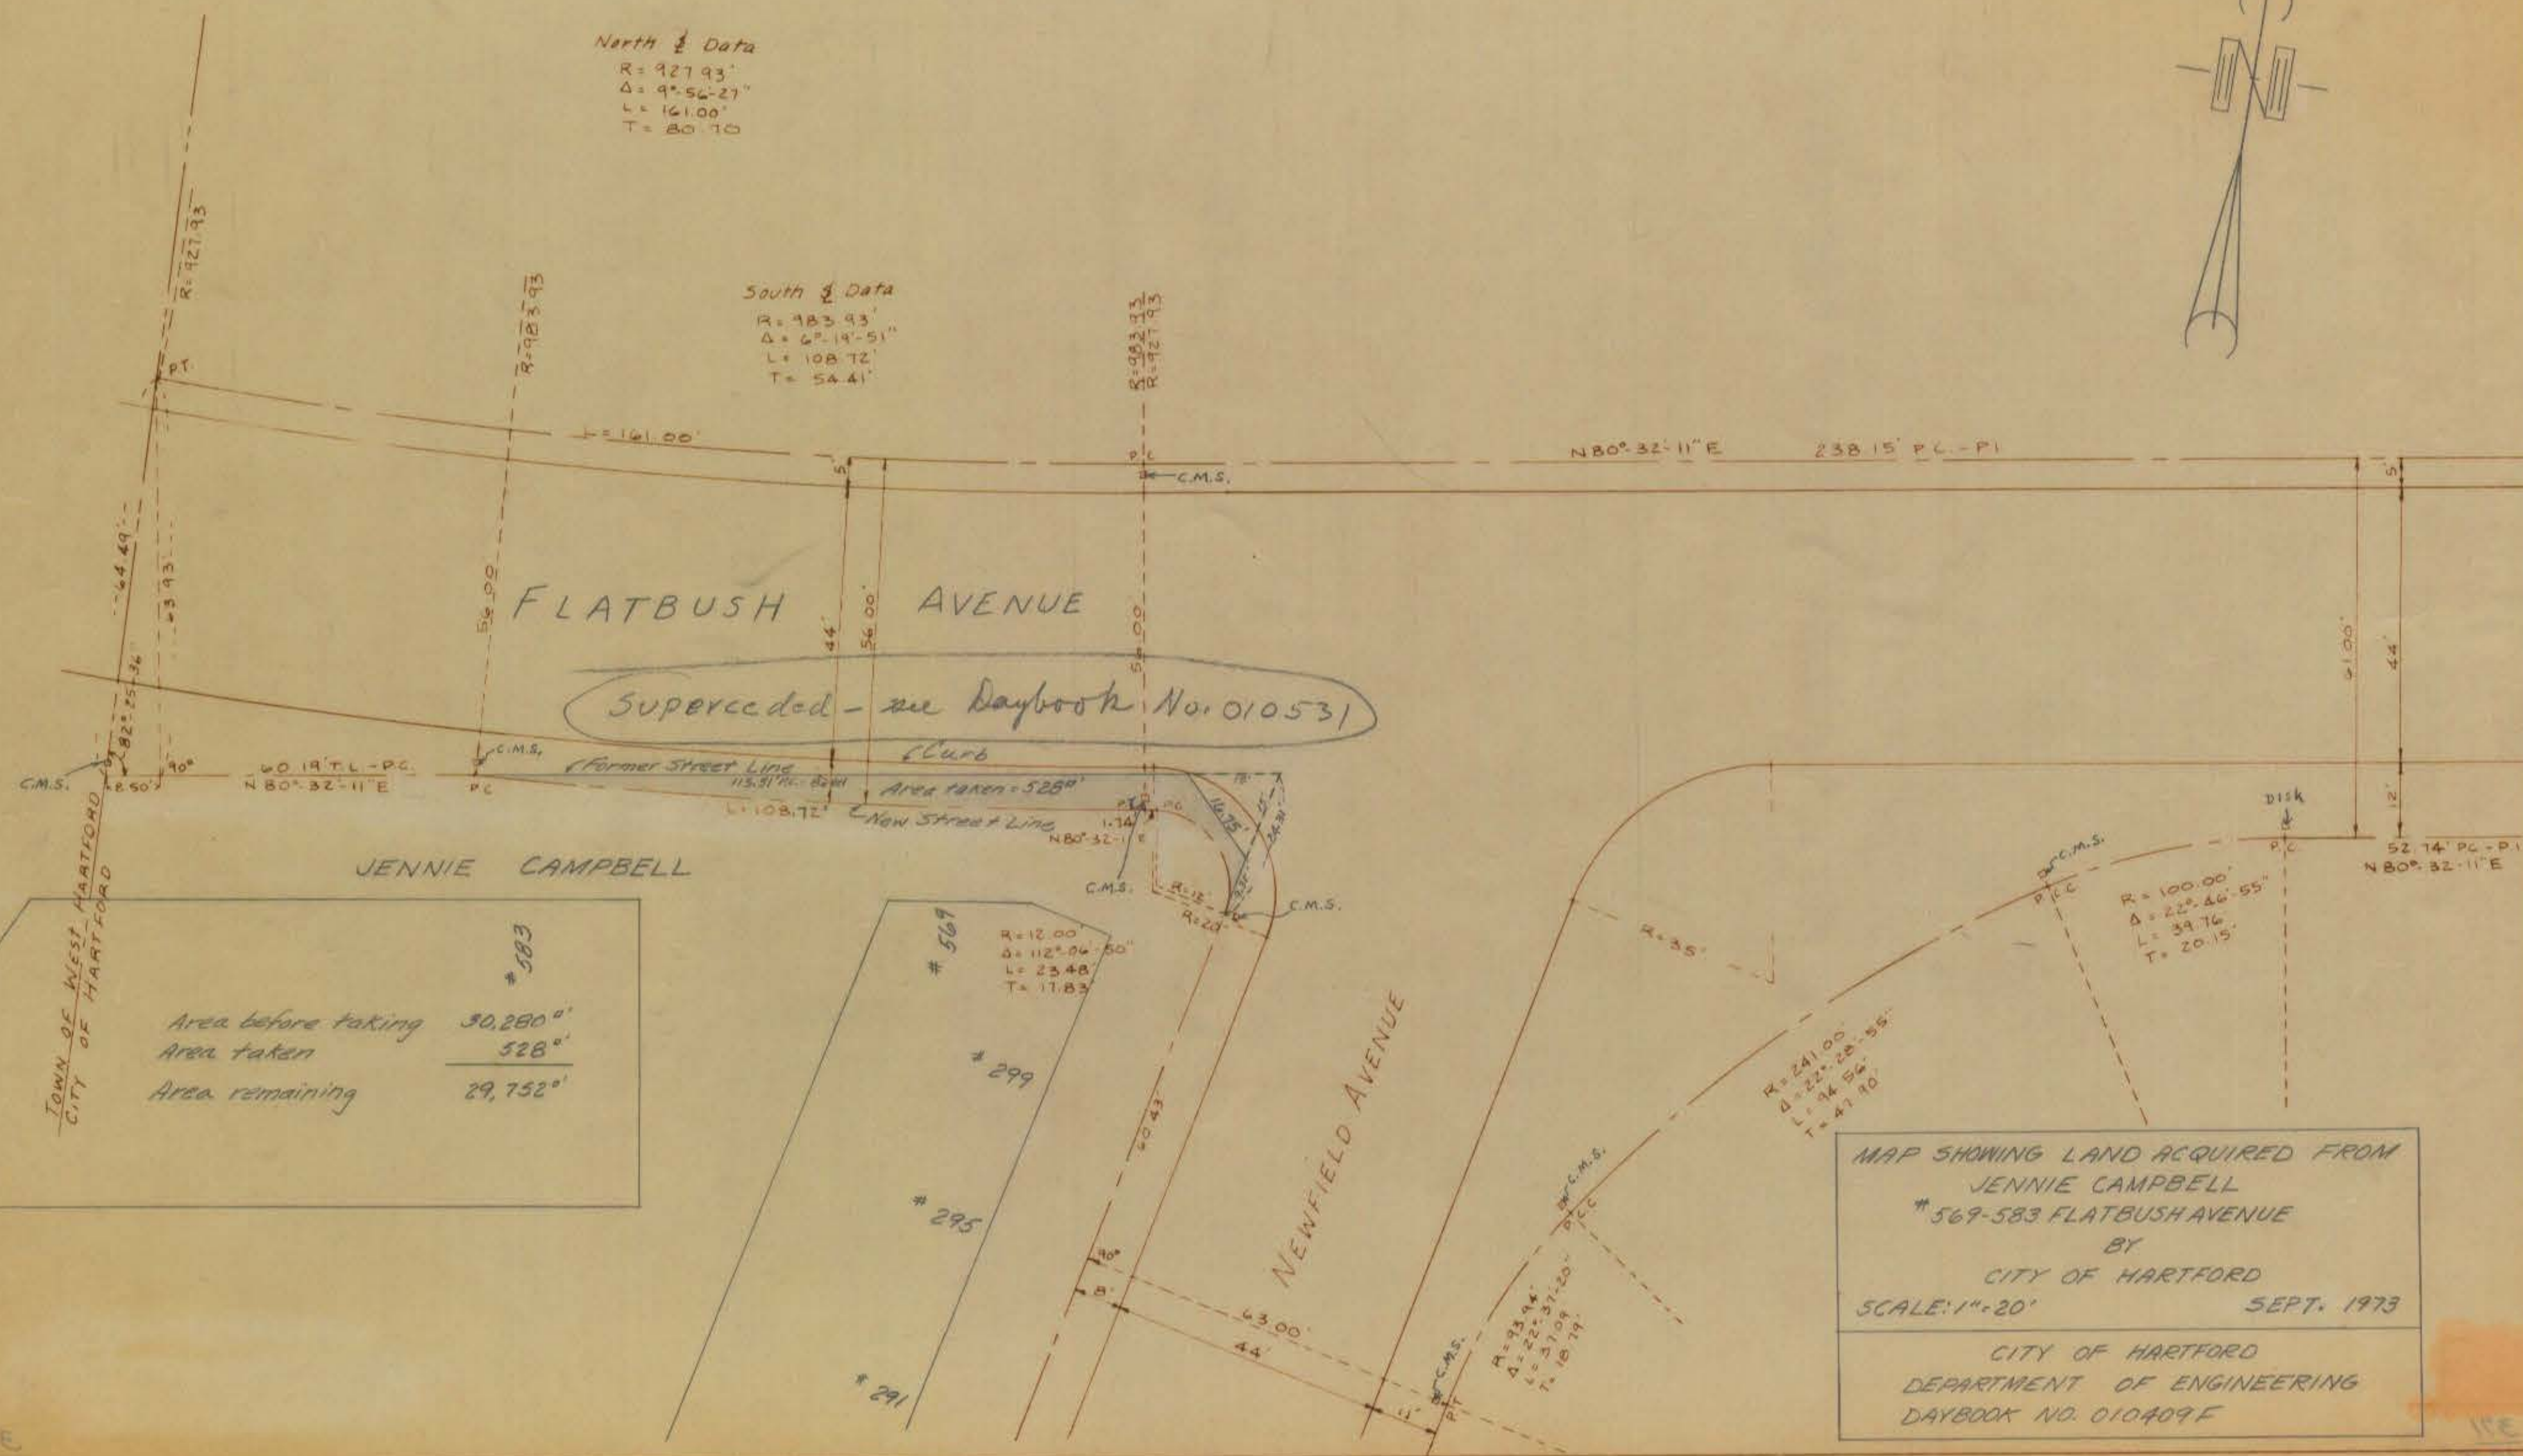

JENNIE CAMPBELL

#583

Area before taking	30,280.0'
Area taken	528.0'
Area remaining	29,752.0'

R = 12.00'
 $\Delta = 112^\circ 06' 50''$
L = 23.48'
T = 17.83'

#569

#299

#295

#291

NEWFIELD AVENUE

MAP SHOWING LAND ACQUIRED FROM
JENNIE CAMPBELL
#569-583 FLATBUSH AVENUE
BY
CITY OF HARTFORD
SCALE: 1" = 20' SEPT. 1973
CITY OF HARTFORD
DEPARTMENT OF ENGINEERING
DAYBOOK NO. 010409F