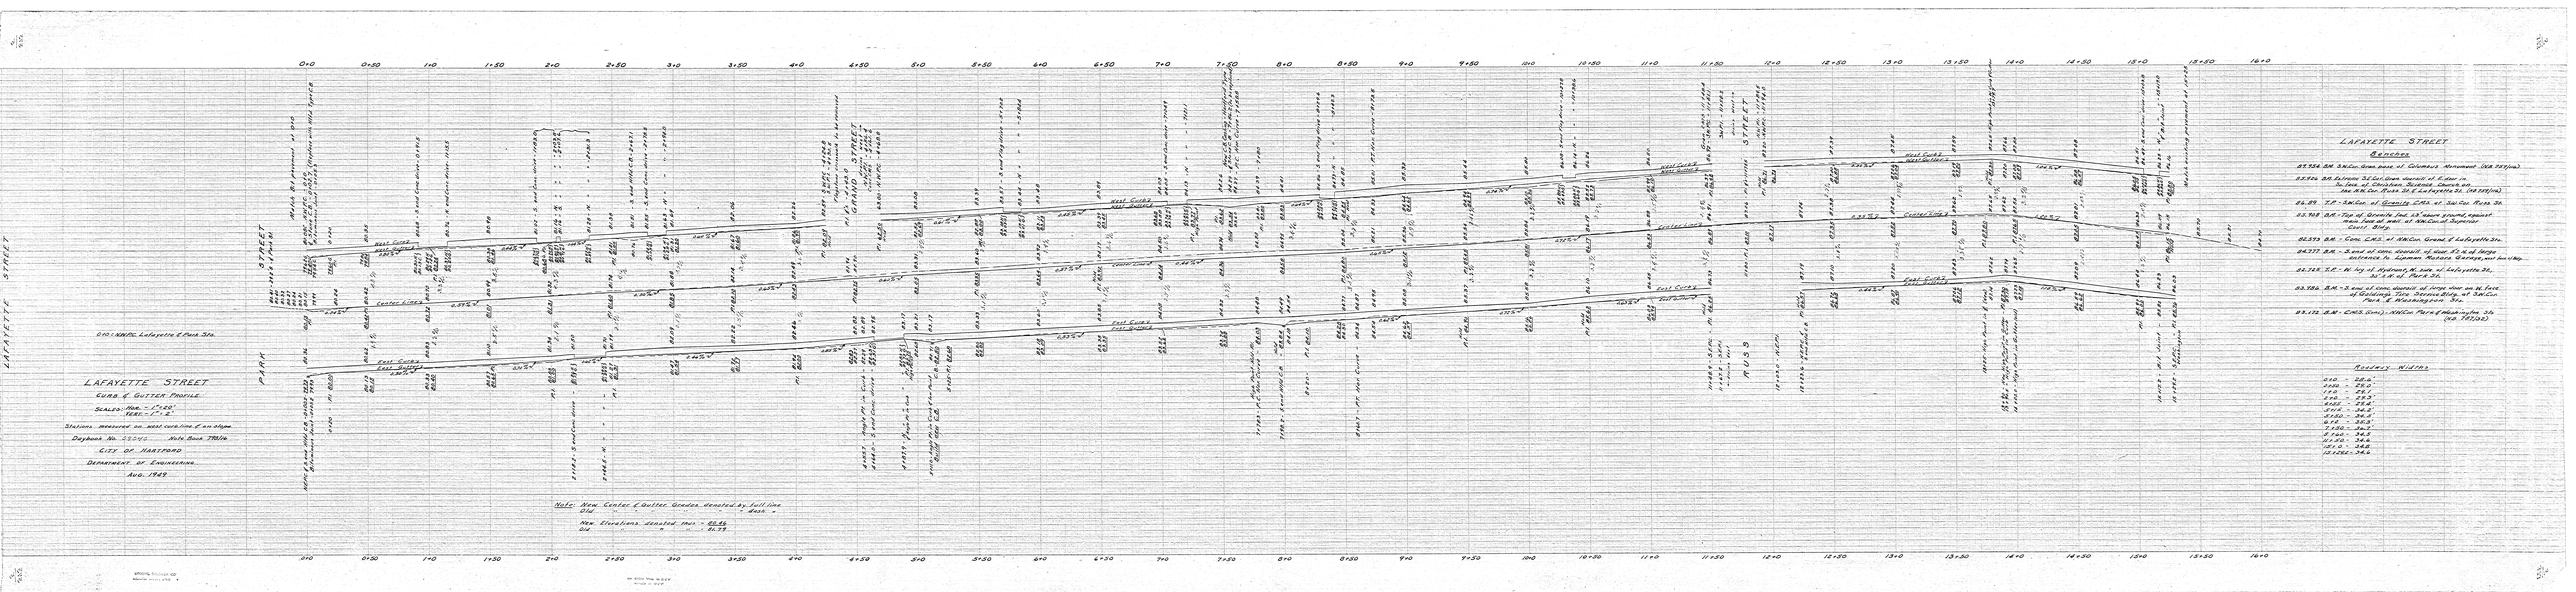
LAFAYETTE STREET
Curb & Gutter Profile
Scales: Hor. - 1" = 20'
Vert. - 1" = 2'
Stations measured on west curb line of an slope
Daybook No. 23245 Note Book 7716
City of Hartford
Department of Engineering
Aug. 1949
0+0 N.W. Cor. Lafayette & Park Sts.
PARK STREET
RUSS STREET
West Curb
West Gutter
Center Line
East Curb
East Gutter
Note: New Center & Gutter Grades denoted by full line
Old " " " " dash "
New Elevations denoted thus - 60.46
Old " " " " 60.79
LAFAYETTE STREET
Benches
Roadway Widths
0+0 - 26.6
1+50 - 29.0
2+50 - 29.5
3+50 - 29.5
4+50 - 29.4
5+50 - 34.2
6+50 - 34.3
7+50 - 34.3
8+50 - 34.3
9+50 - 34.4
10+50 - 34.4
11+50 - 34.4
12+50 - 34.6