
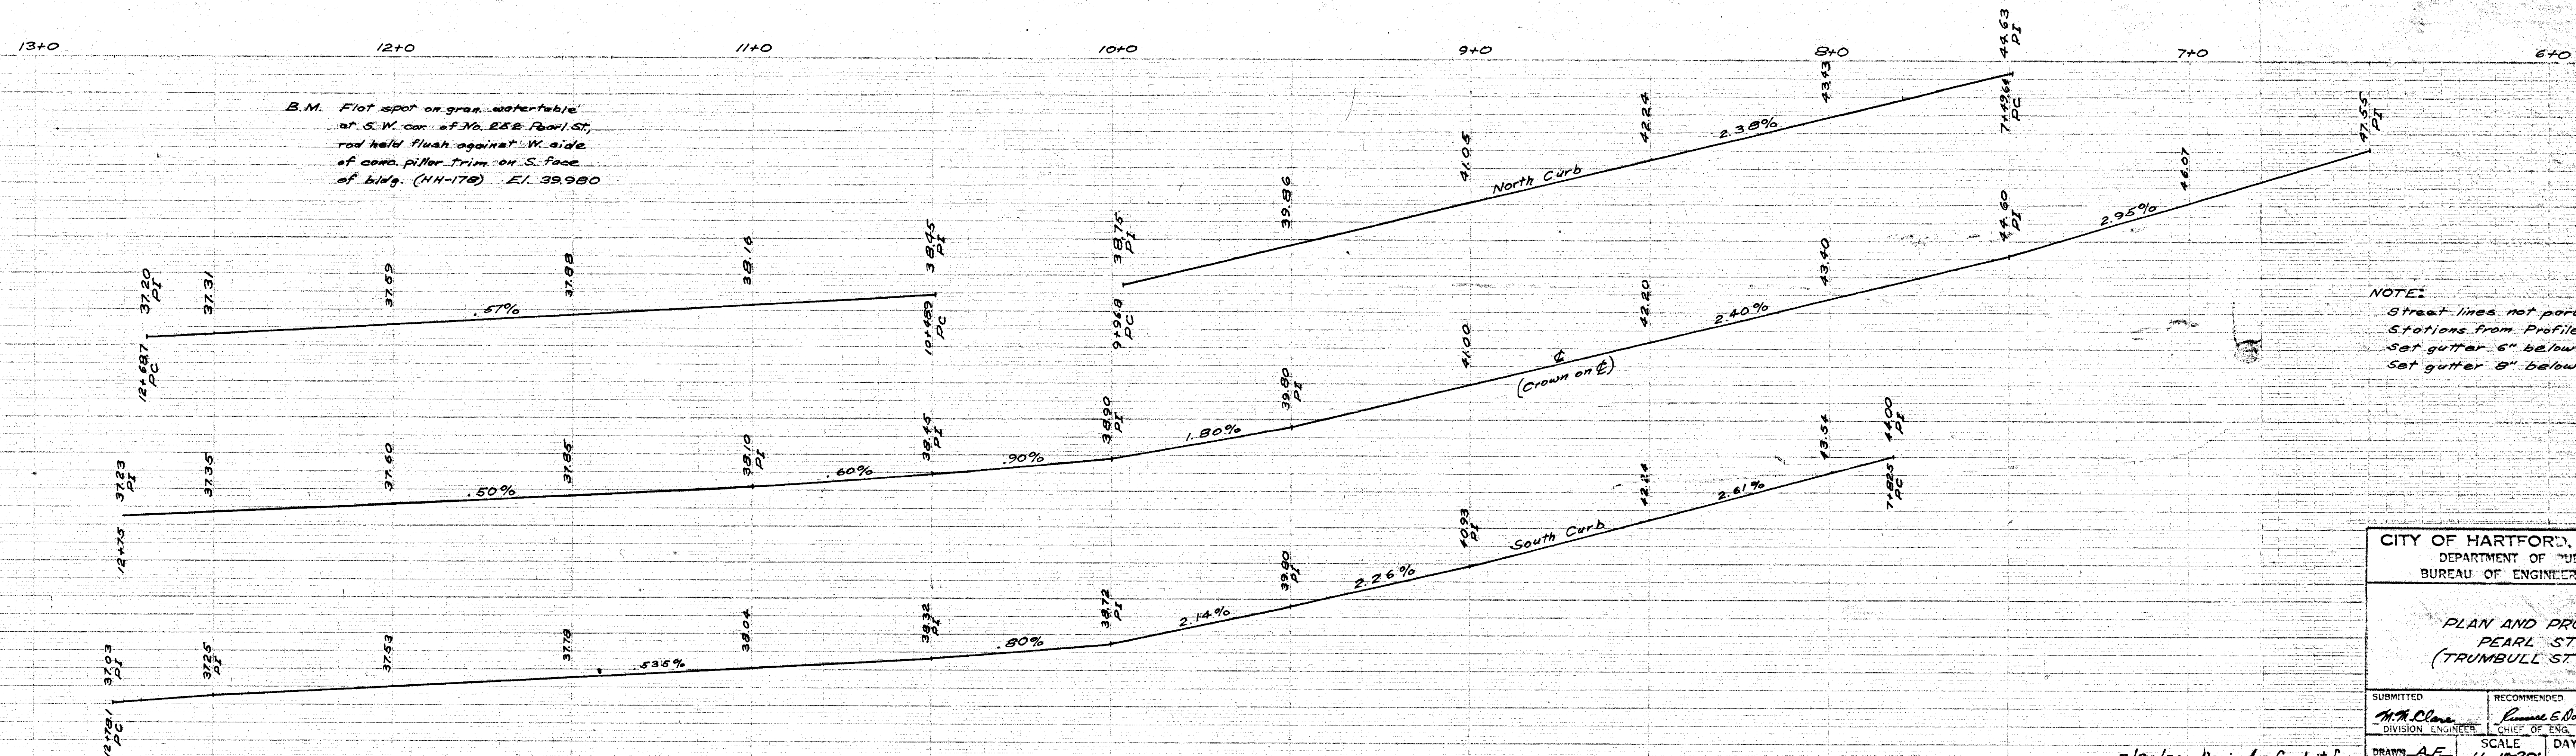


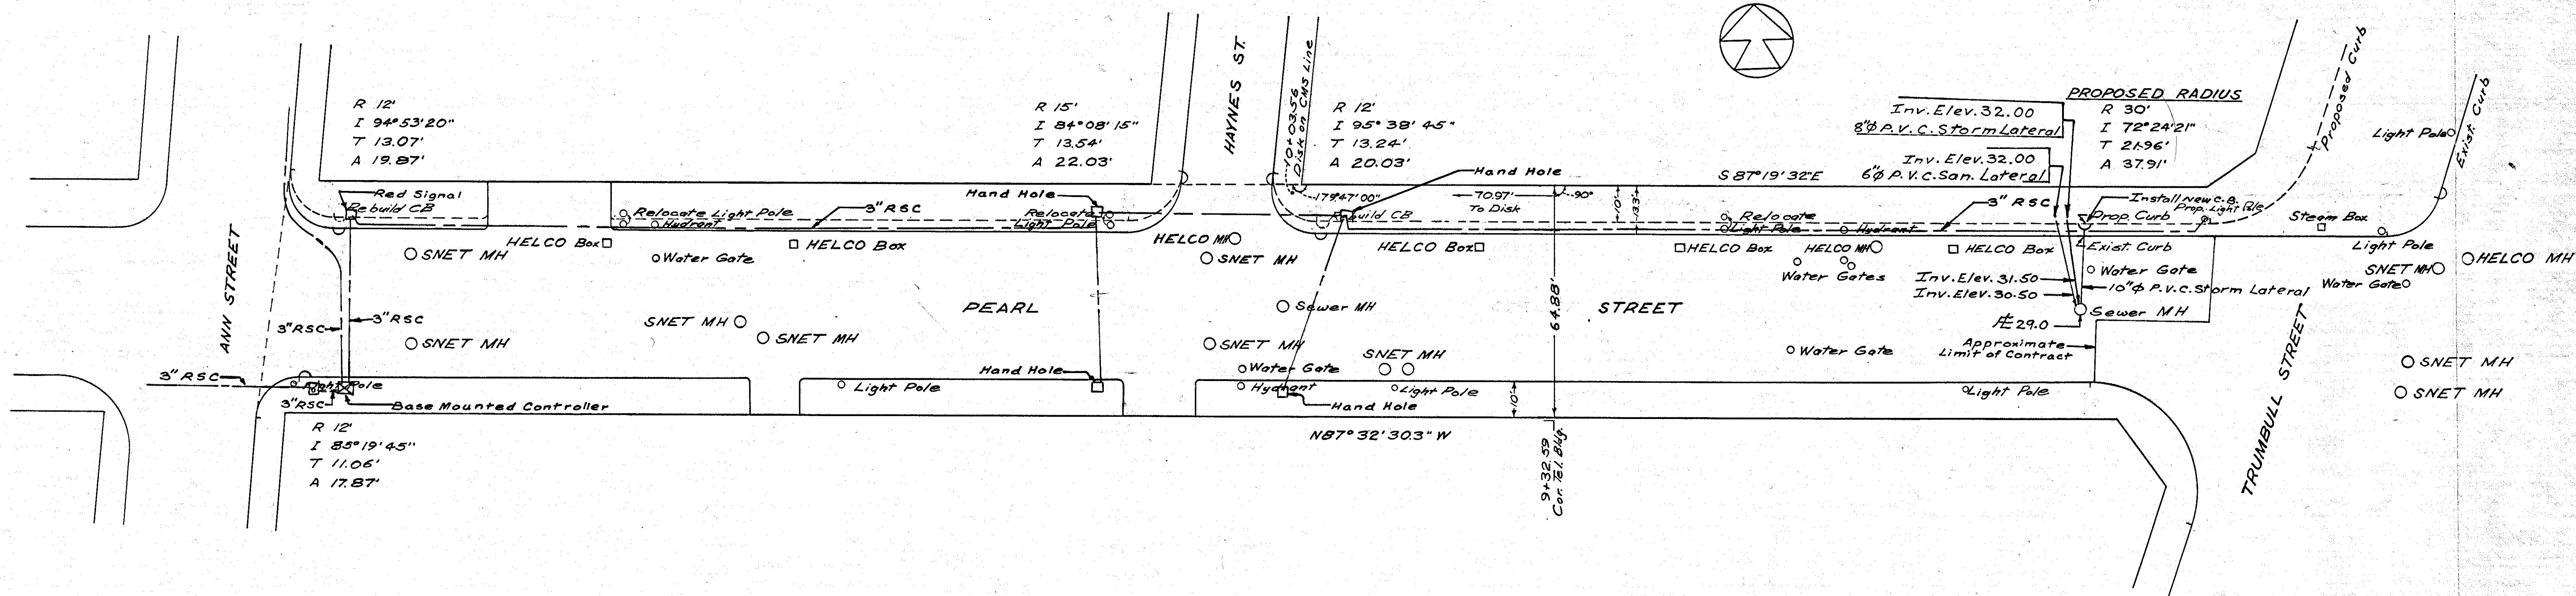

B.M. Flat spot on grass, water table
at S.W. cor. of No. 258 Pearl St.
rod held flush against W. side
of concrete pillar from on S. face
of bldg. (NN-178) E.L. 39.980

NOTE:
Street lines not parallel.
Stations from Profile 53/B.
Set gutter 6" below curb grade.
Set gutter 8" below curb grade at C.B.'s.

CITY OF HARTFORD, CONNECTICUT
DEPARTMENT OF PUBLIC WORKS
BUREAU OF ENGINEERING SERVICES

PLAN AND PROFILE OF
PEARL STREET
(TRUMBULL ST TO ANN ST)

SUBMITTED M. H. Clave	RECOMMENDED James E. Boag	APPROVED George L. Hopper
DIVISION ENGINEER	CHIEF OF ENG. DIV.	CHIEF OF ENG. DIV.
DRAWN A.F.	SCALE 1"=20'	DAY BOOK NO. 010391
CHECKED M.M.C.	V. 1"=2'	DATE APRIL 1973

7/30/74 - Revised - Conduit for
Traffic Signals
8/26/74 - Revised