# ALBANY AVENUE

HIGH STREET TO EDWARDS STREET
CURB PROFILE FOR ROADWAY WIDENING
HOR. SCALE 1"=20'
VER. SCALE 1"=2'
Stations Measured on South Curb Line
North Side Shown in Green, South in Black
New Grades Shown in Red
Daybook No. 02433 Notebook 514

Department of Engineering
Hartford Conn.
Jan. 1923

BENCHES
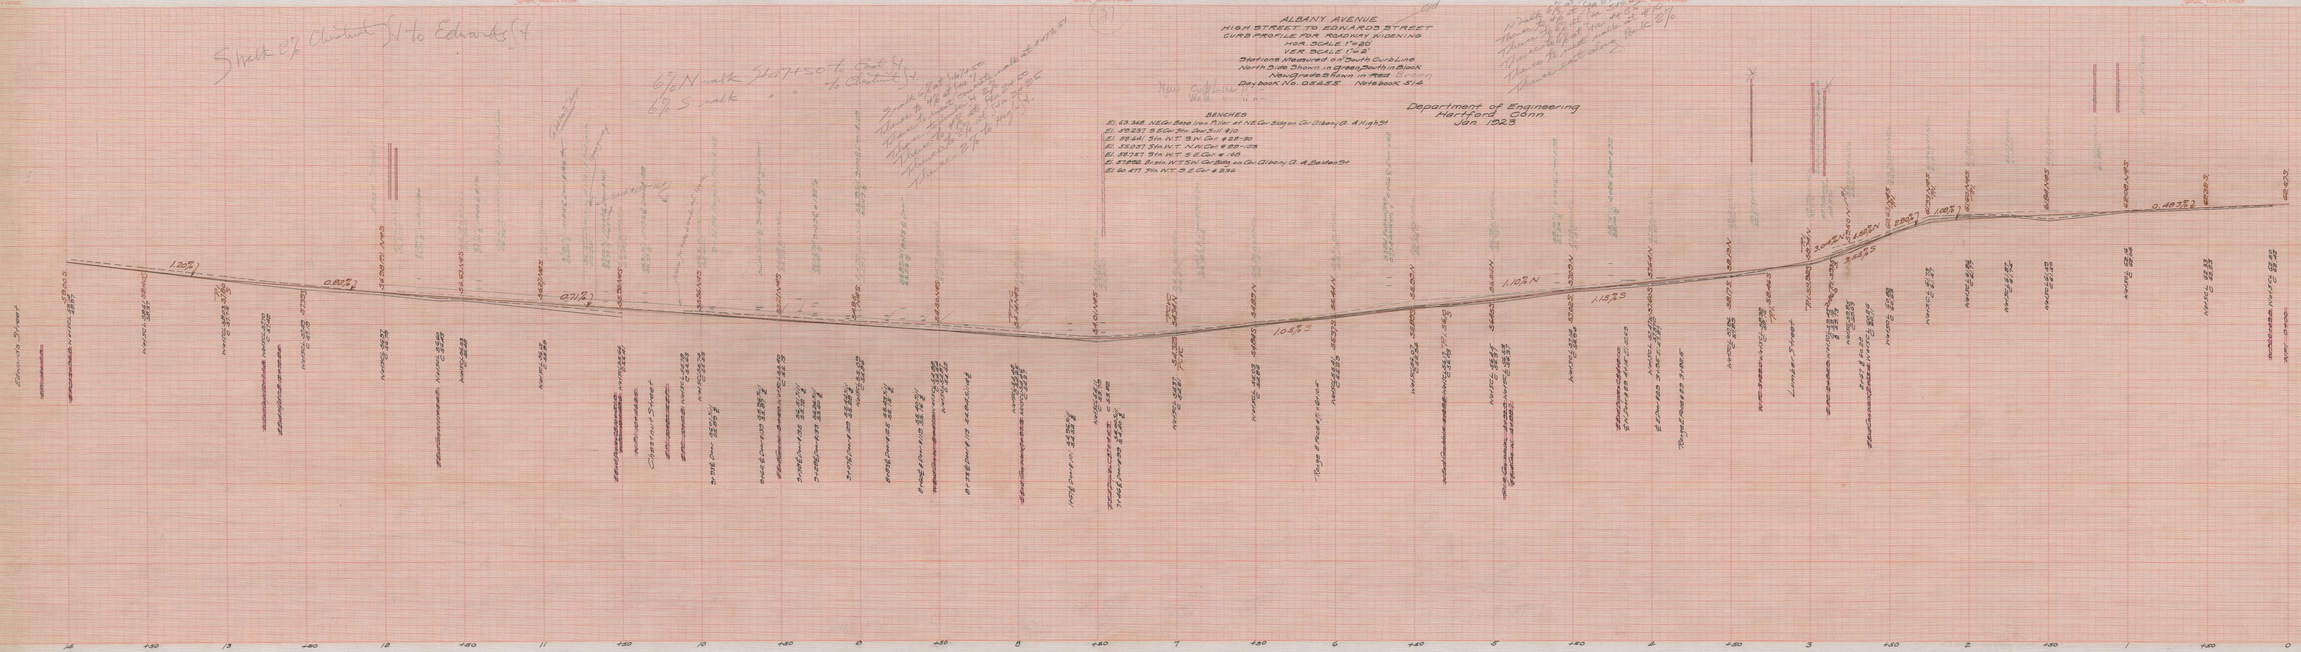
El. 53.348 N.E. Cor. Base Iron Pillar at N.E. Cor. Bldg. on Cor. Albany & High St.
El. 49.237 S.E. Cor. 7th Cor. Sill #30
El. 38.641 5th N.T. S.W. Cor. # 22-30
El. 38.037 5th N.T. N.W. Cor. # 82-103
El. 38.327 9th N.T. S.E. Cor. # 149
El. 51.886 Brass in N.T. S.W. Cor. Bldg. on Cor. Albany & Baldwin St.
El. 64.477 7th N.T. S.E. Cor. # 236