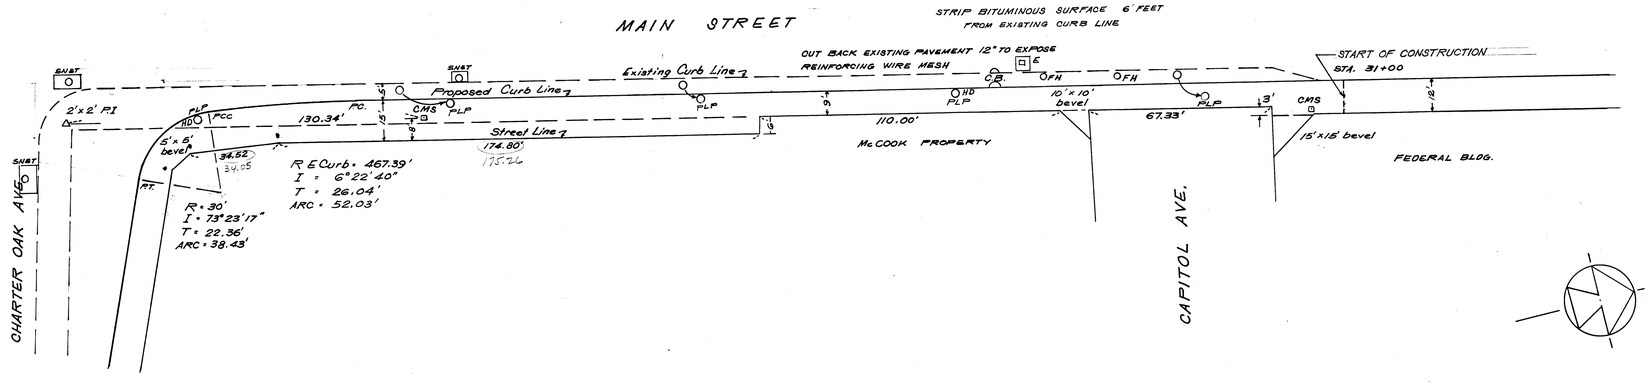

LEGEND

H - - Helco Man Hole
E - - Elec. Box
S - - Sewer Man Hole
T - - SNET Man Hole
GG - - Gas Gate
WB - - Water Bureau
FH - - Fire Hydrant
FB - - Fire Box
LP - - Light Pole
PLP - - Proposed Light Pole
CB - - Catch Basin

NOTE:
Where size of radius is indicated new radius curb shall be installed.
Exact location of utility structures will be determined in the field.

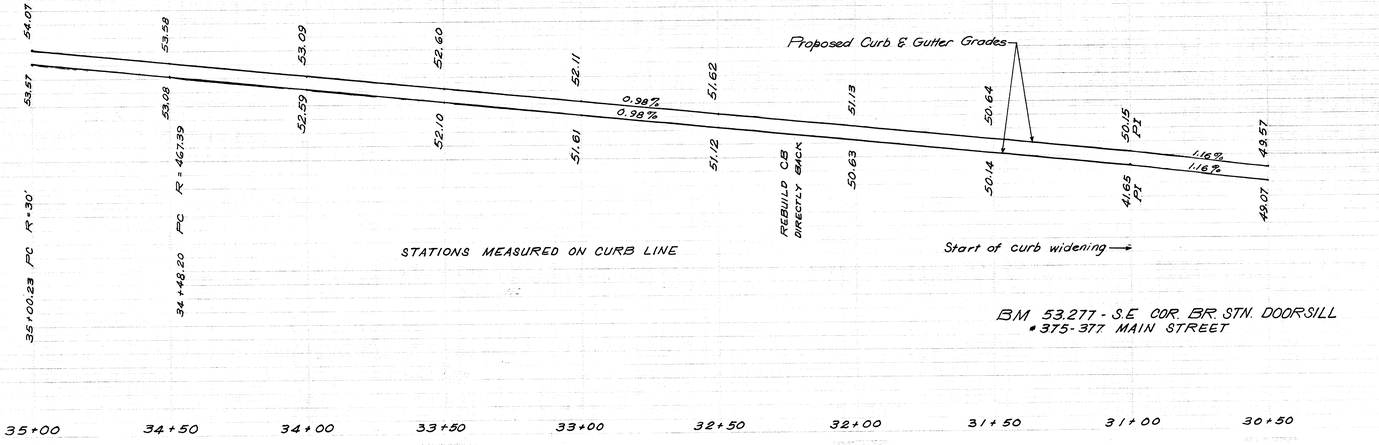

BM 53.277 - S.E. COR. BR. STN. DOORSILL #375-377 MAIN STREET

SHEET 5 OF 6
HARTFORD REDEVELOPMENT PROJECT
CONN. R-77

CITY OF HARTFORD, CONNECTICUT
DEPARTMENT OF ENGINEERING

MAIN STREET
PLAN AND PROFILE

SCALES: HOR: 1"=20'; VER: 1"=2'

SUBMITTED:	RECOMMENDED:	APPROVED:
W.H. Clark	[illegible]	[illegible]
DIVISION ENGINEER	ASST. CITY ENG.	CITY ENGINEER

PREPARED BY: GSC
CHECKED BY: MHC
DAYBOOK No. 010364
DATE: Oct. 1972