


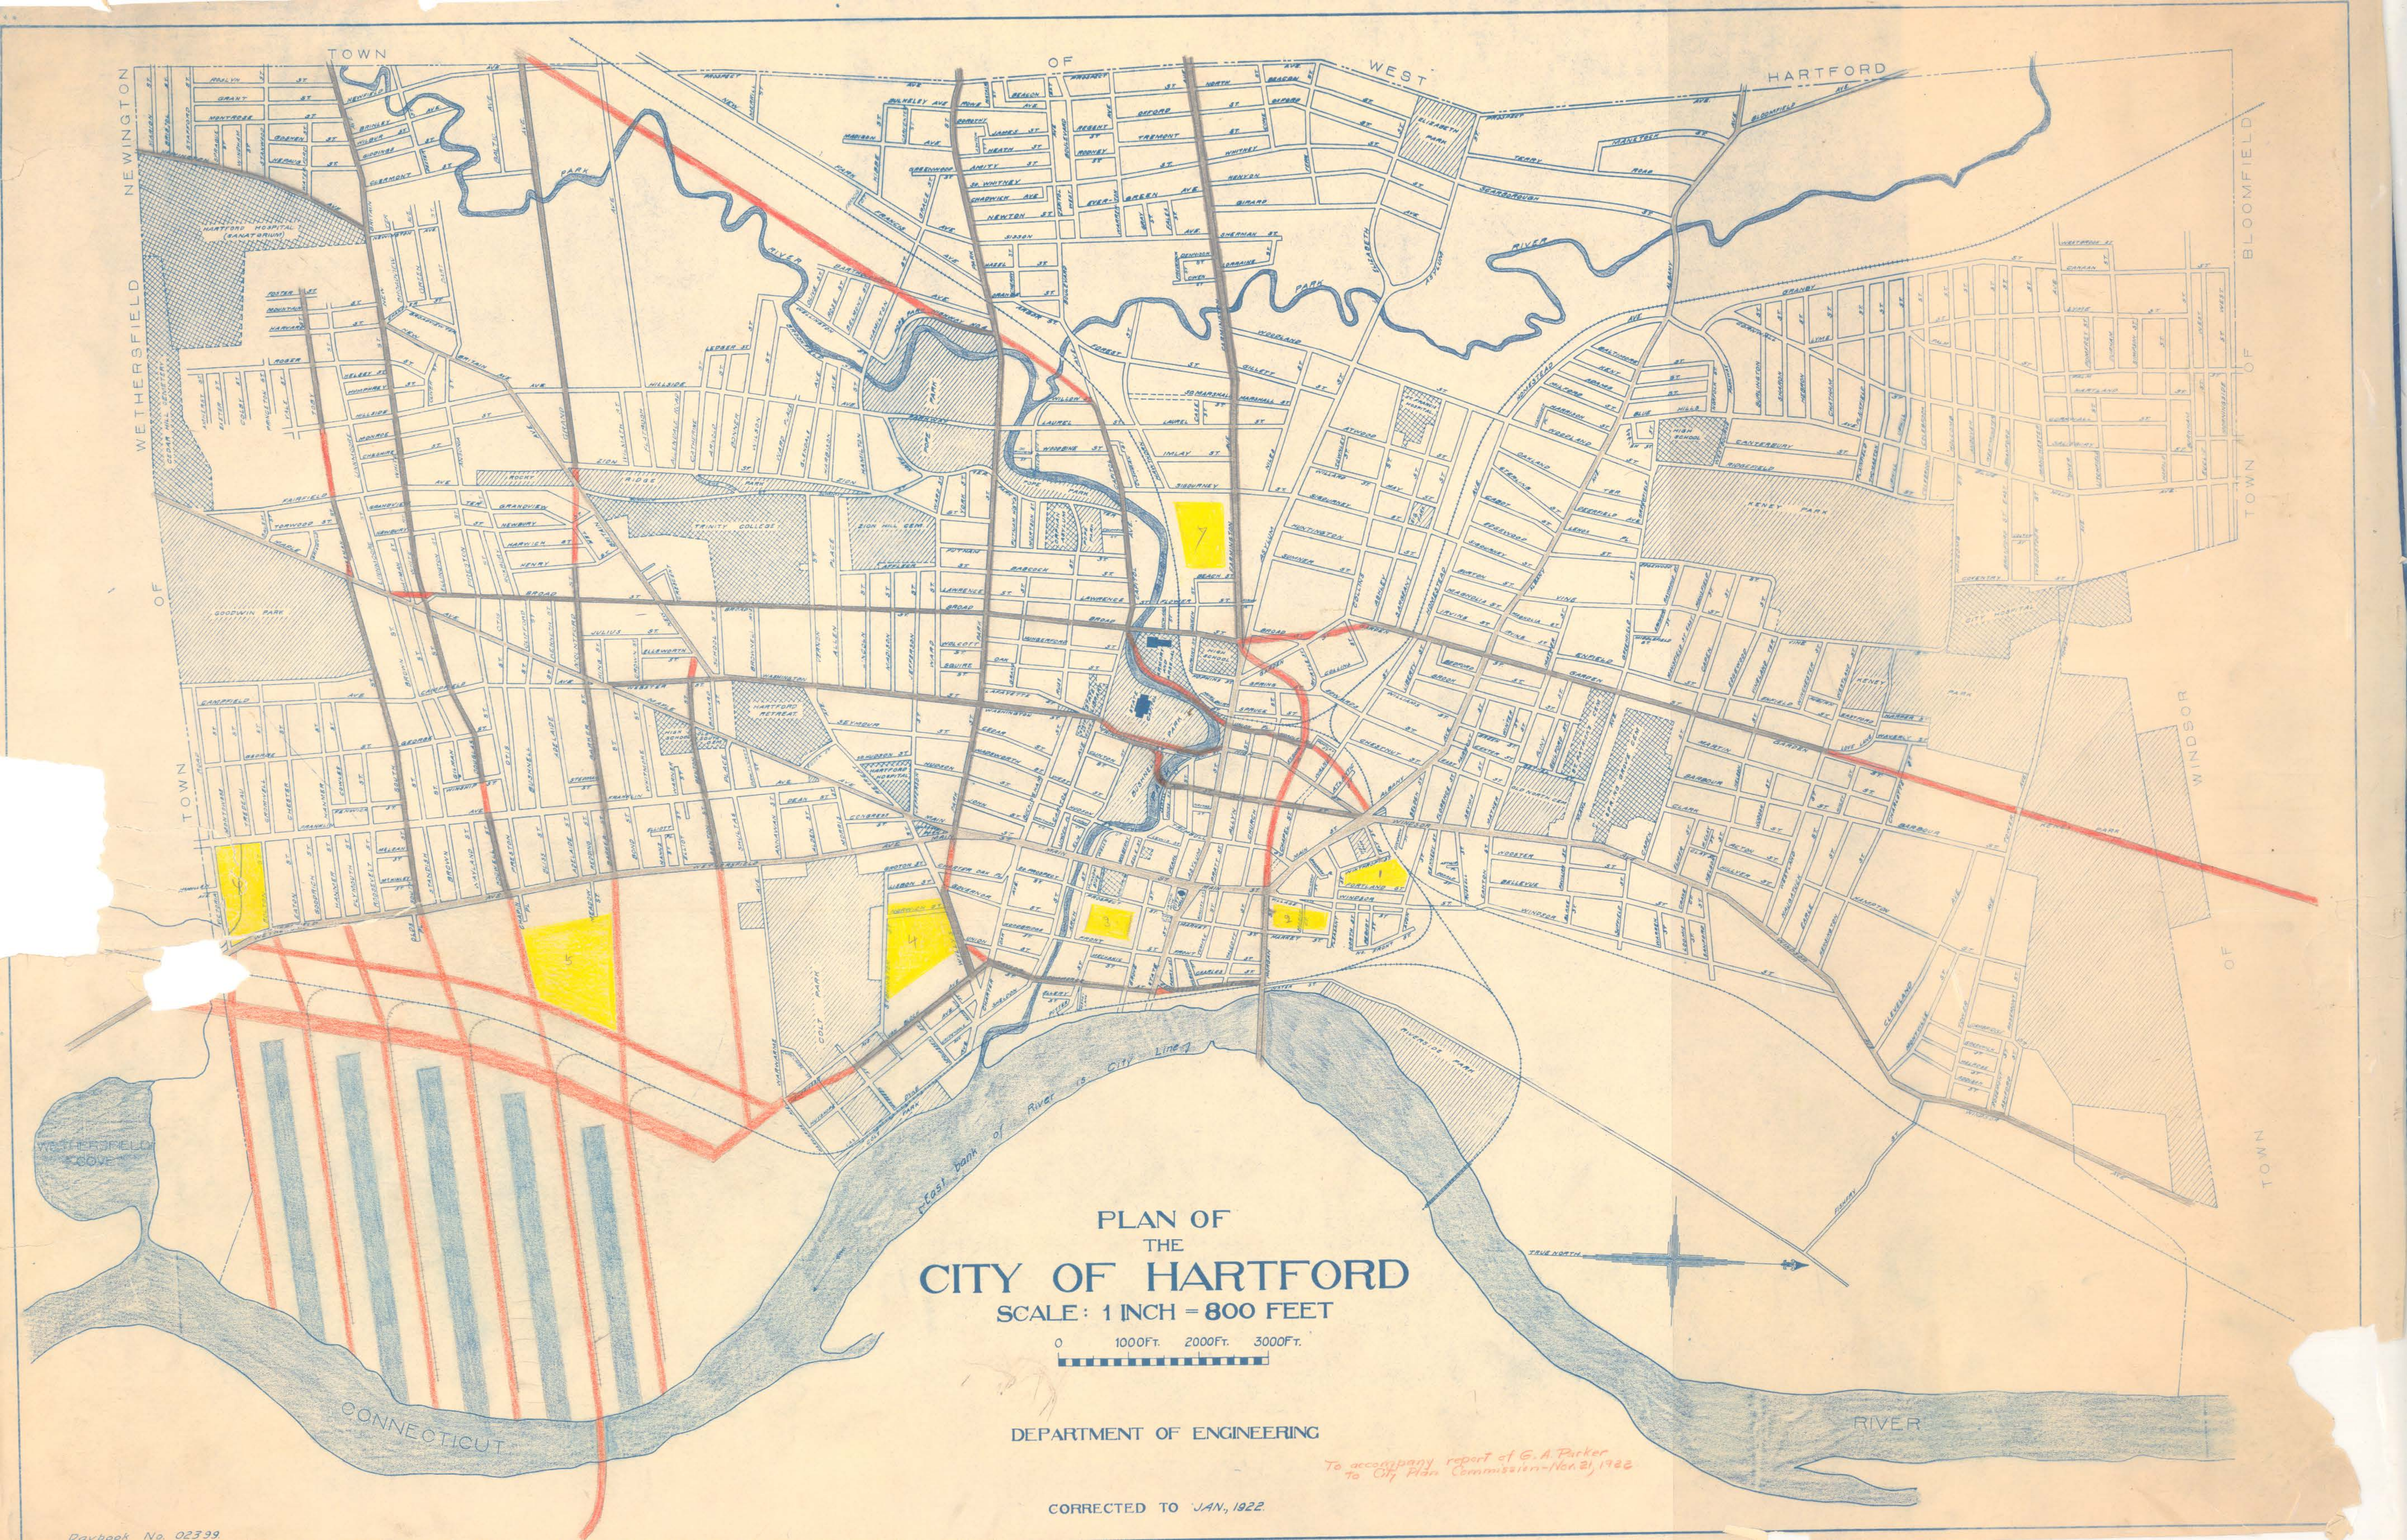

PLAN OF
THE
CITY OF HARTFORD

SCALE: 1 INCH = 800 FEET

0 1000Ft. 2000Ft. 3000Ft.

DEPARTMENT OF ENGINEERING

CORRECTED TO JAN., 1922

To accompany report of G. A. Parker
to City Plan Commission - Nov. 21, 1922