
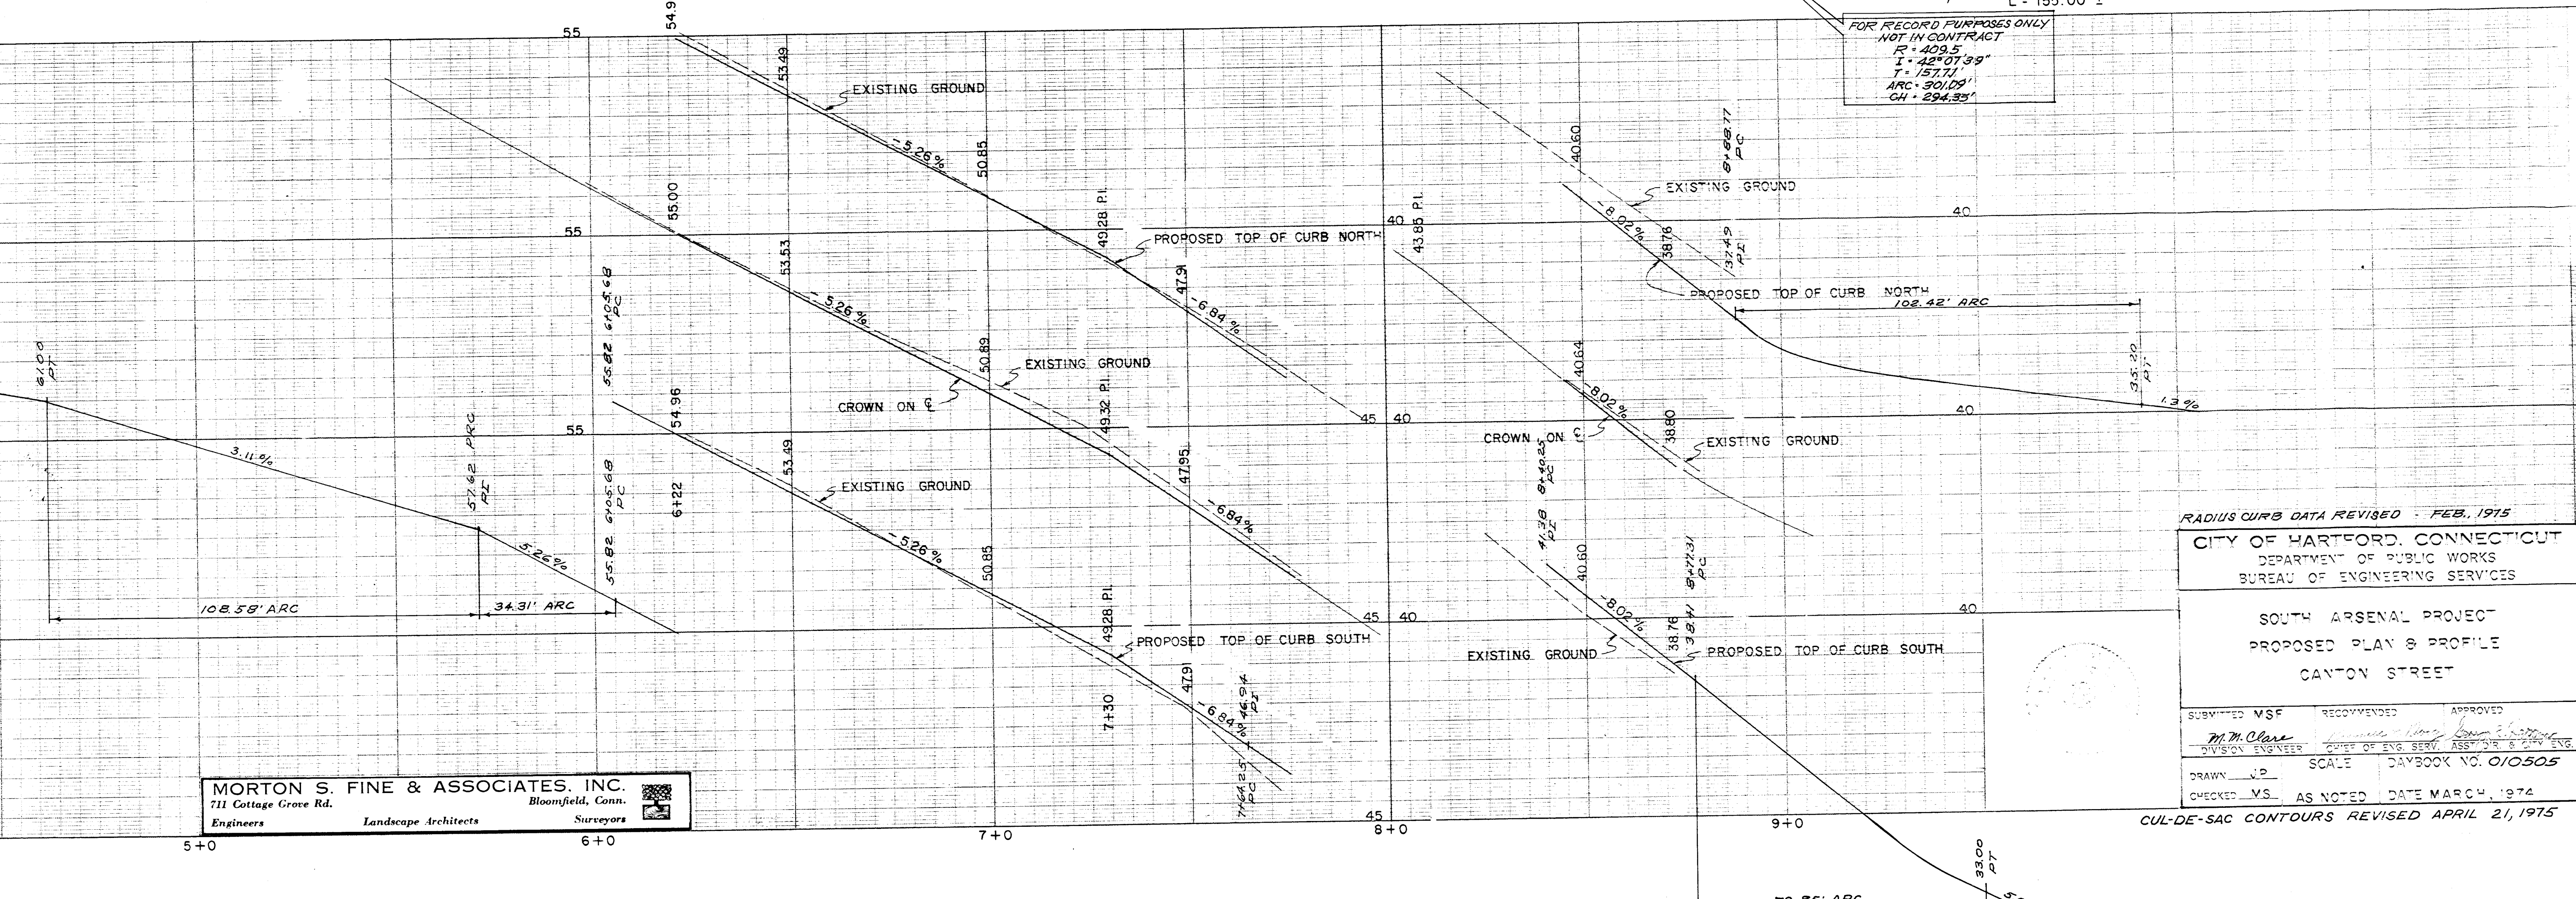


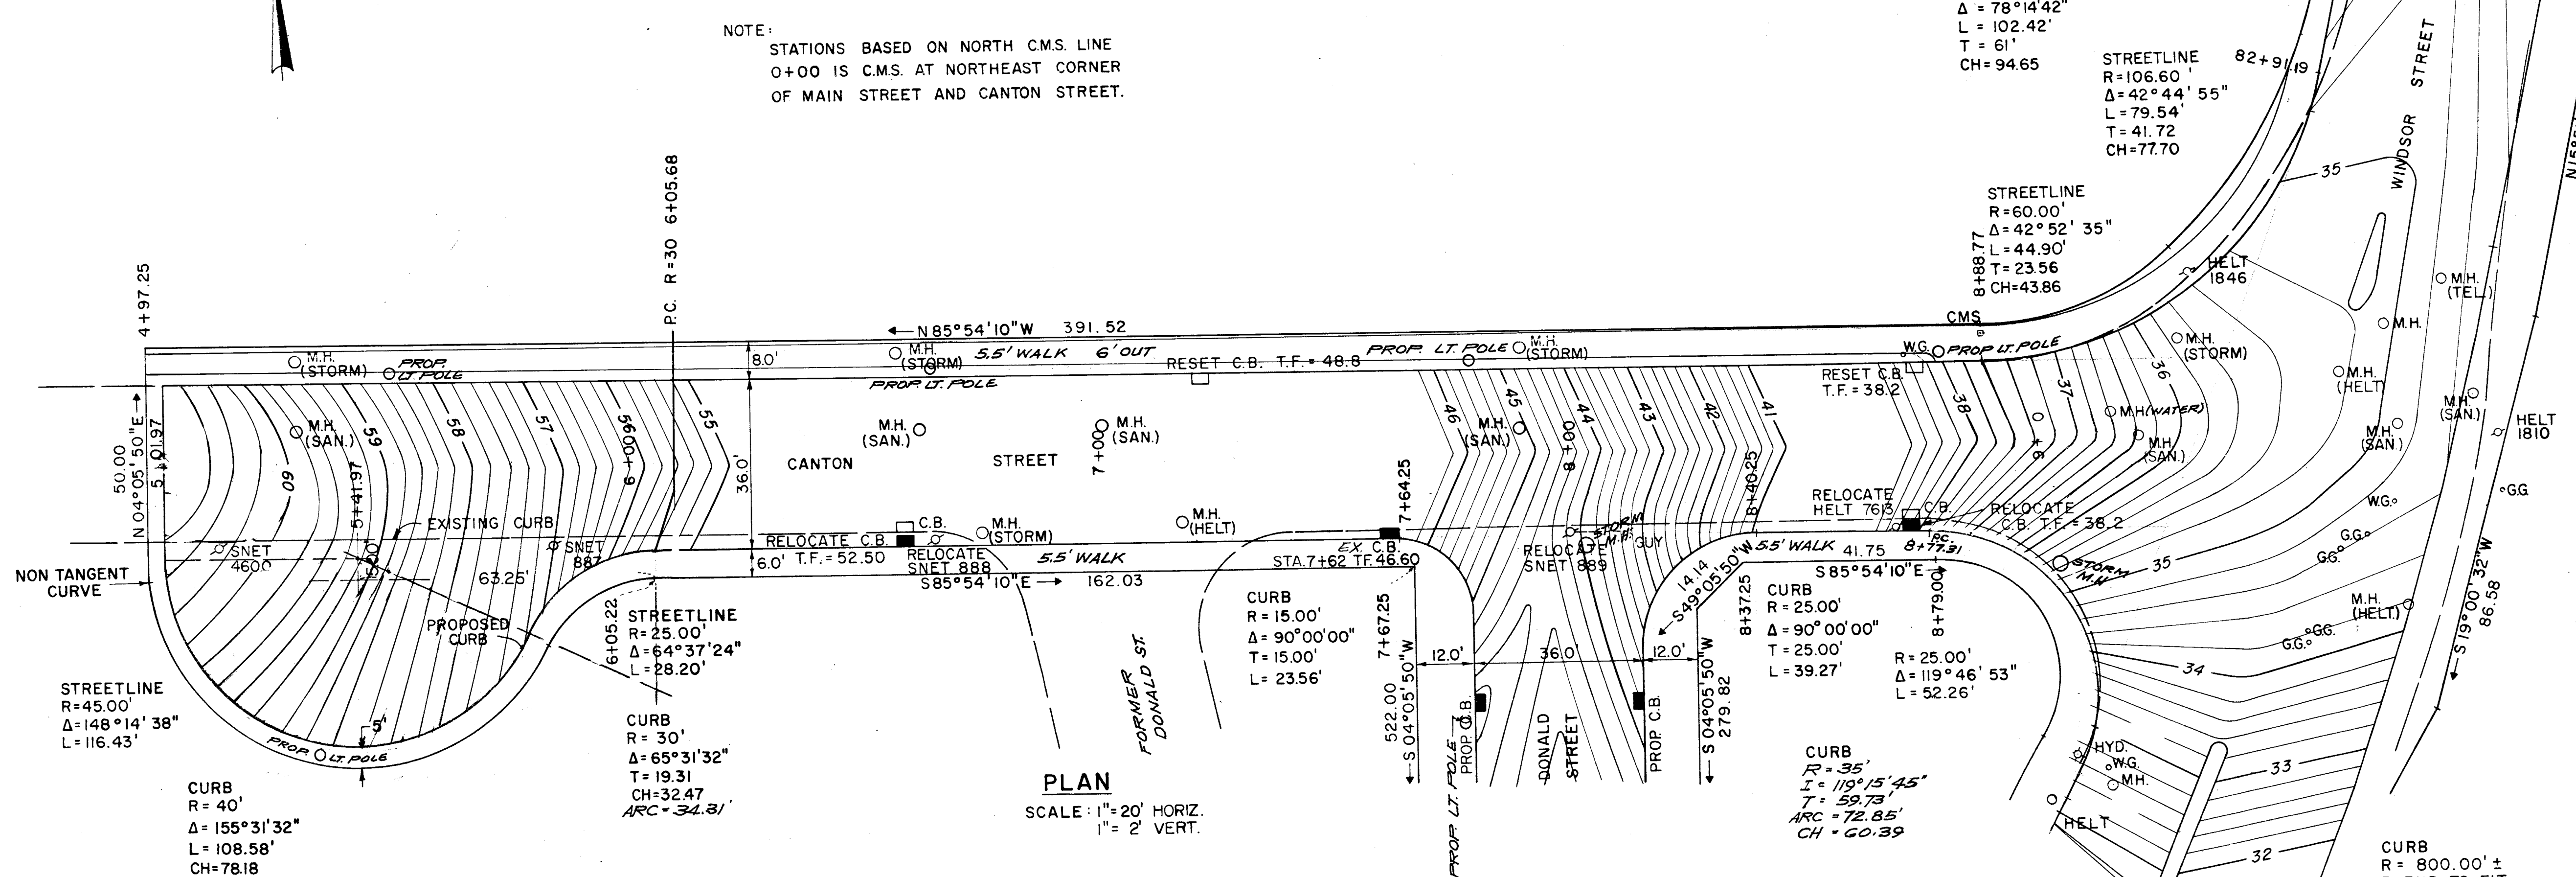

MORTON S. FINE & ASSOCIATES, INC.
711 Cottage Grove Rd. Bloomfield, Conn.
Engineers Landscape Architects Surveyors

RADIO CURB DATA REVISED : FEB., 1975		
CITY OF HARTFORD, CONNECTICUT		
DEPARTMENT OF PUBLIC WORKS		
BUREAU OF ENGINEERING SERVICES		
SOUTH ARSENAL PROJECT		
PROPOSED PLAN & PROFILE		
CANTON STREET		
SUBMITTED MSF	RECOMMENDED	APPROVED
<i>M. M. Case</i> DIST. ENGINEER	<i>Francis H. Hodge</i> CHIEF OF ENG. SERV.	<i>James E. Hodge</i> ASST. DIR. & CH. EN.
DRAWN <u>VP</u>	SCALE	DAYBOOK NO. <i>010505</i>
CHECKED <u>VS.</u>	AS NOTED	DATE MARCH 4, 1974
RE SAC CONSTRUCTIONS REVISED APRIL 21, 1975		