
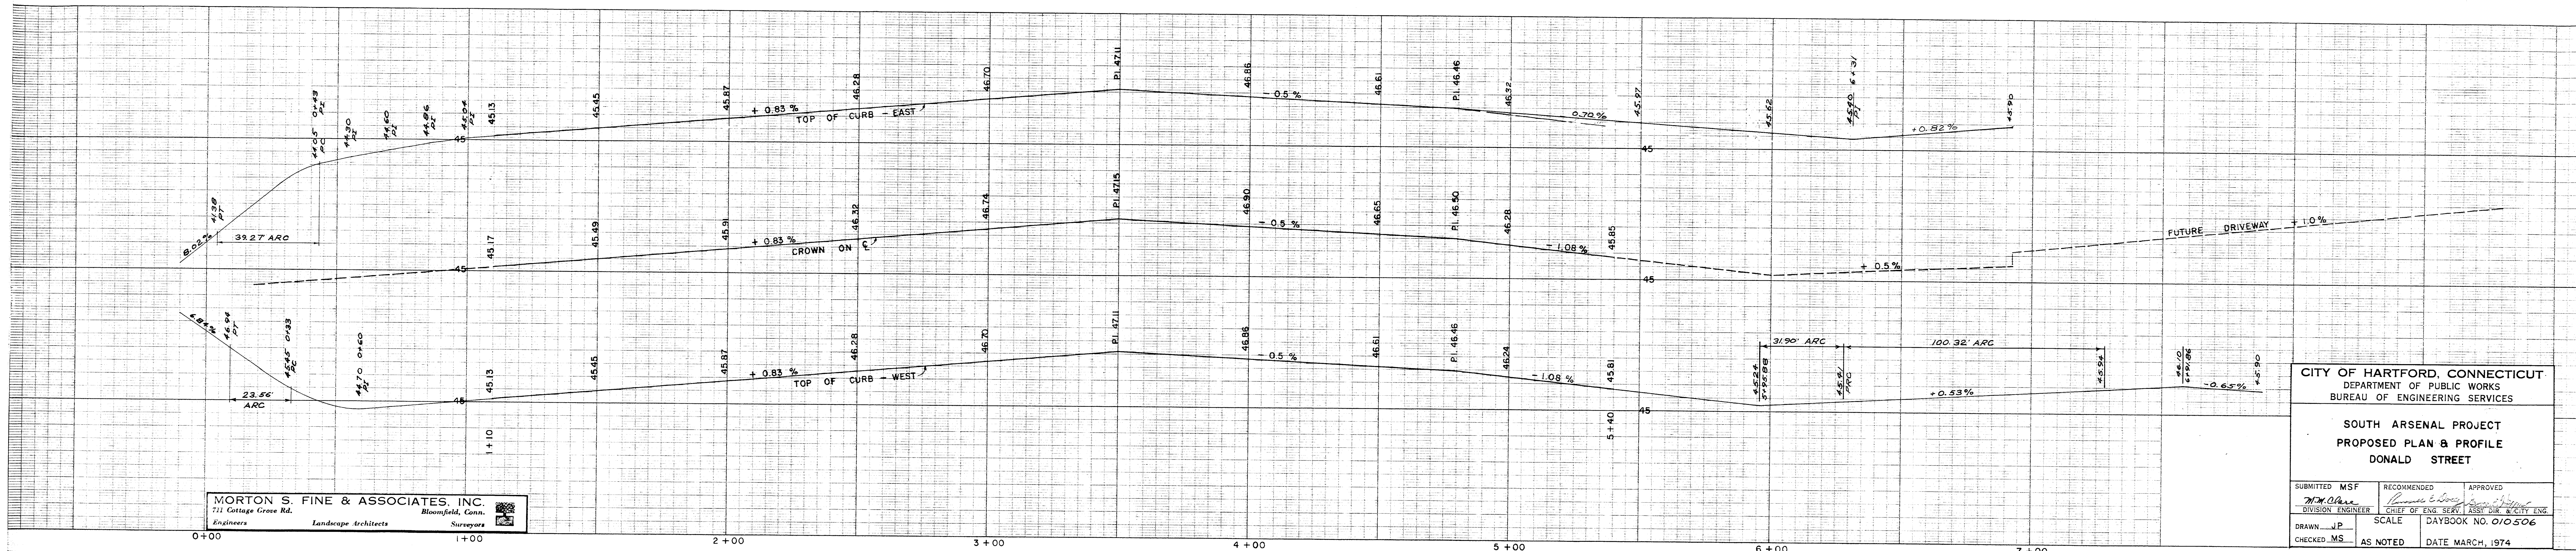


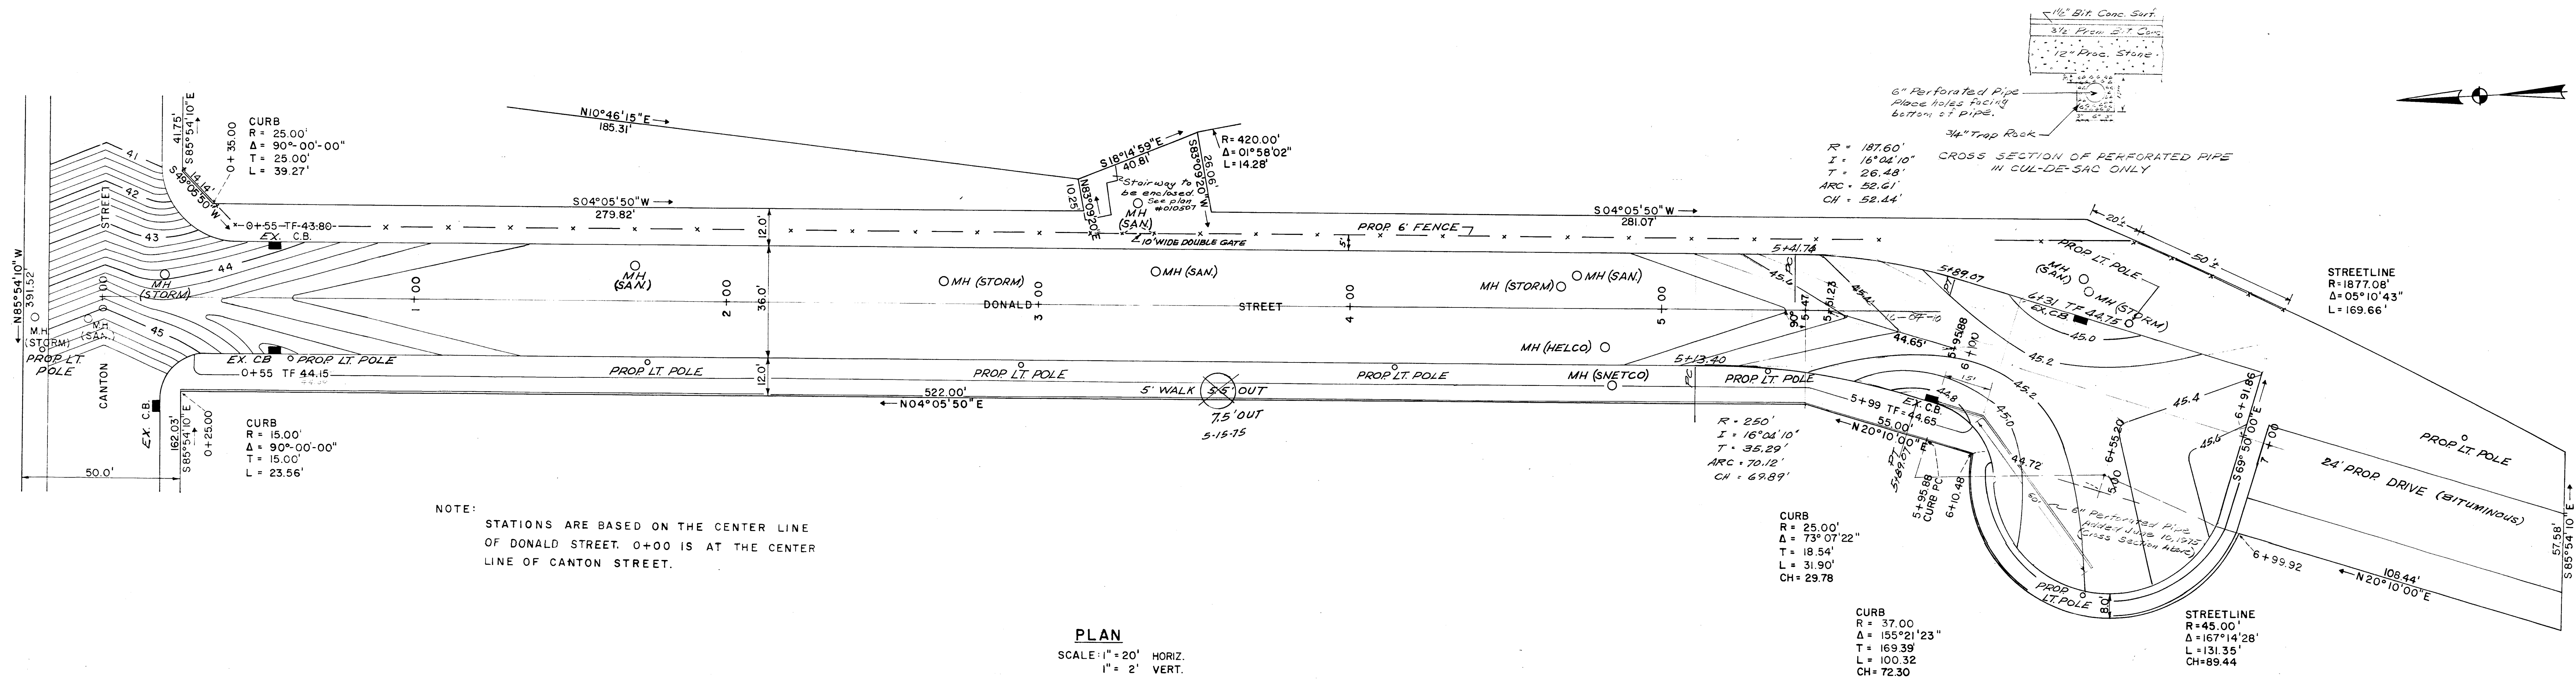

MORTON S. FINE & ASSOCIATES, INC.
711 Cottage Grove Rd.
Bloomfield, Conn.
Engineers Landscape Architects Surveyors

CITY OF HARTFORD, CONNECTICUT
DEPARTMENT OF PUBLIC WORKS
BUREAU OF ENGINEERING SERVICES

SOUTH ARSENAL PROJECT
PROPOSED PLAN & PROFILE
DONALD STREET

SUBMITTED MSF	RECOMMENDED	APPROVED
DIVISION ENGINEER	CHIEF OF ENG. SERV.	ASSY. DIR. & CITY ENG.
DRAWN J.P.	SCALE	DAYBOOK NO. 010506
CHECKED MS	AS NOTED	DATE MARCH, 1974

CONSTRUCTION DATA REV. FEB. 1975
CUL-DE-SAC REVISED MARCH 1975