



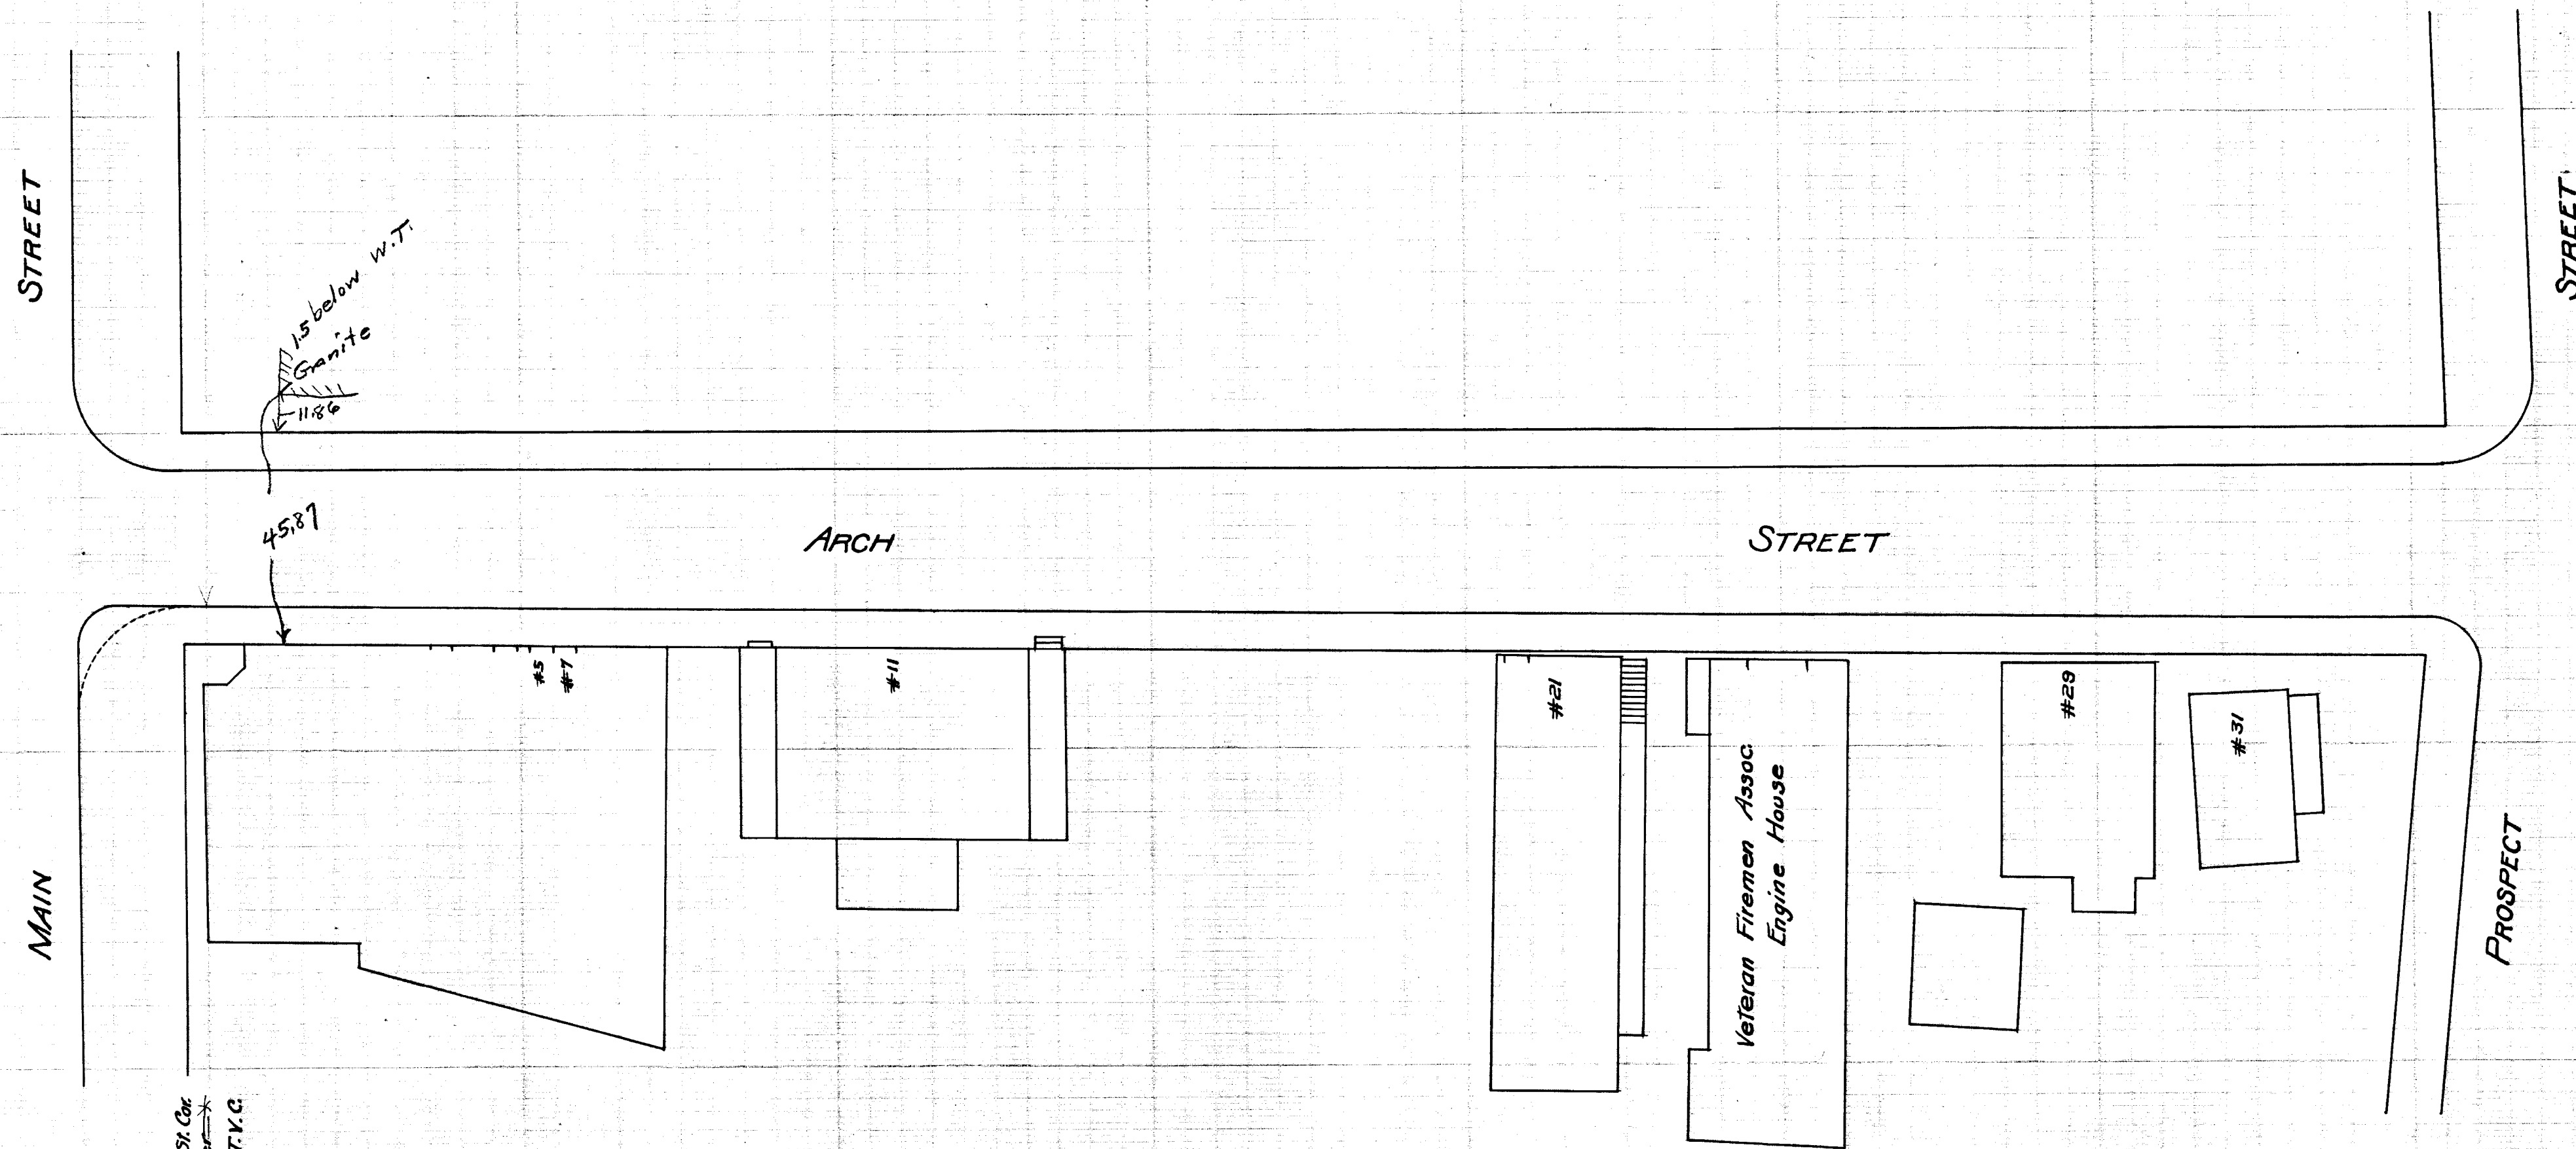

Est. fill to subgrade
of comp. paving = 395 cu yds
HLS
Oct 21 1925

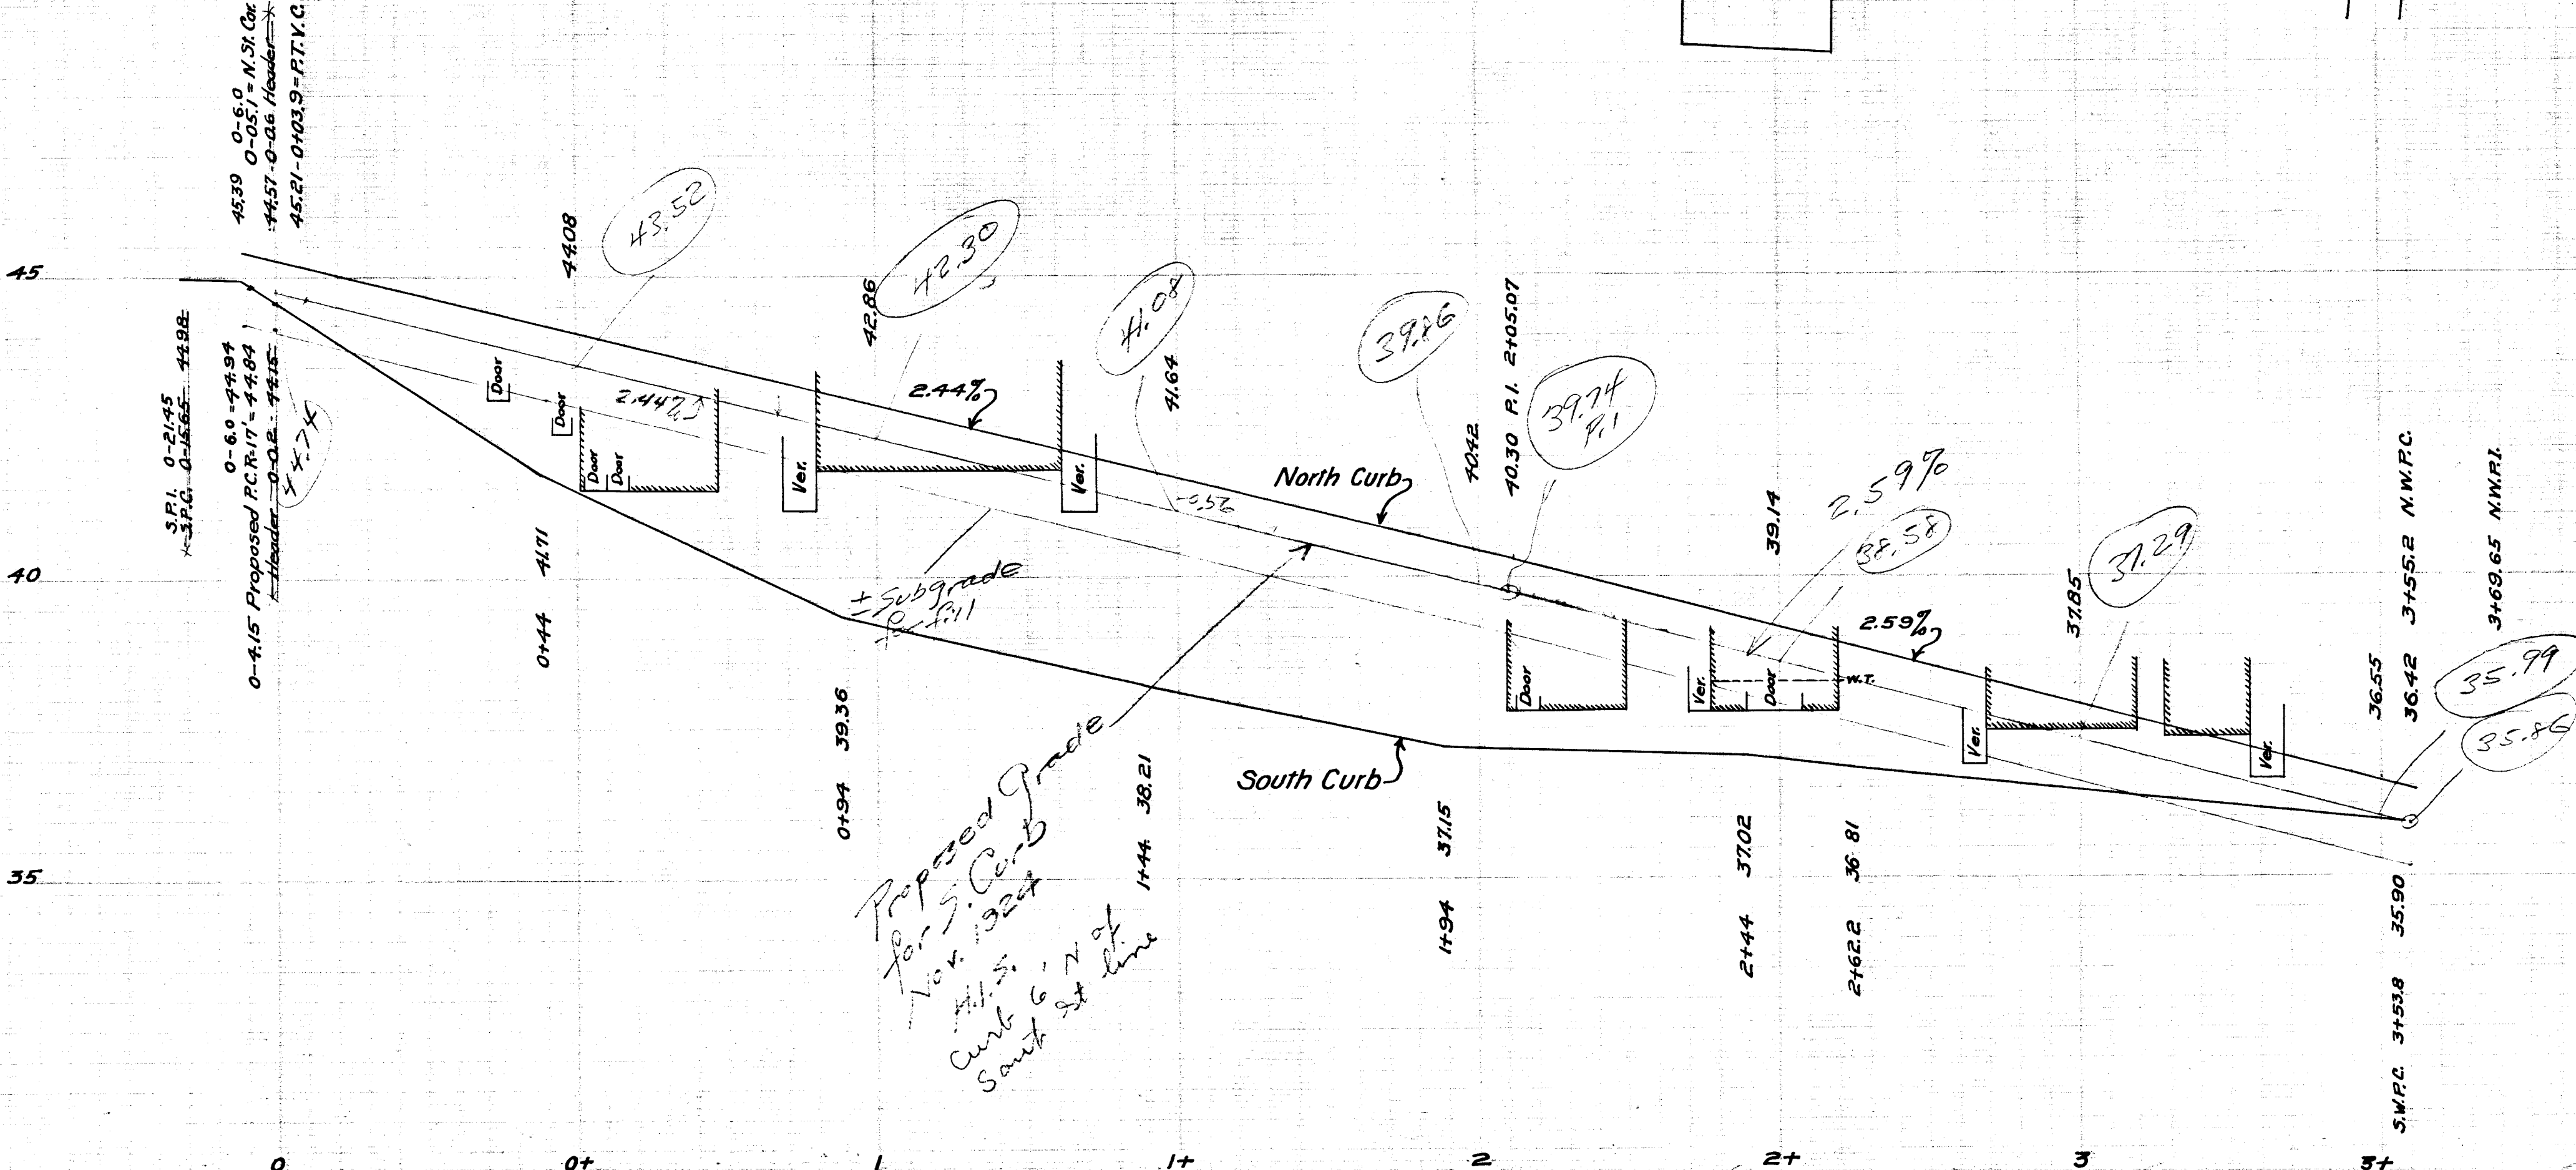

ARCH STREET
MAIN STREET TO PROSPECT STREET
CURB PROFILE
HOR. SCALE 1"=20'
VER. SCALE 1"=2'
NOV. 1924
DAYBOOK NO. 05696
NOTE BOOK 447

DEPARTMENT OF ENGINEERING
HARTFORD CONN.

Proposed {
North gutter 9"
South " 5"
N. half road 12.12' wide
3 " " 10.4 "
Ave. width 23'
Curbs 6' out.