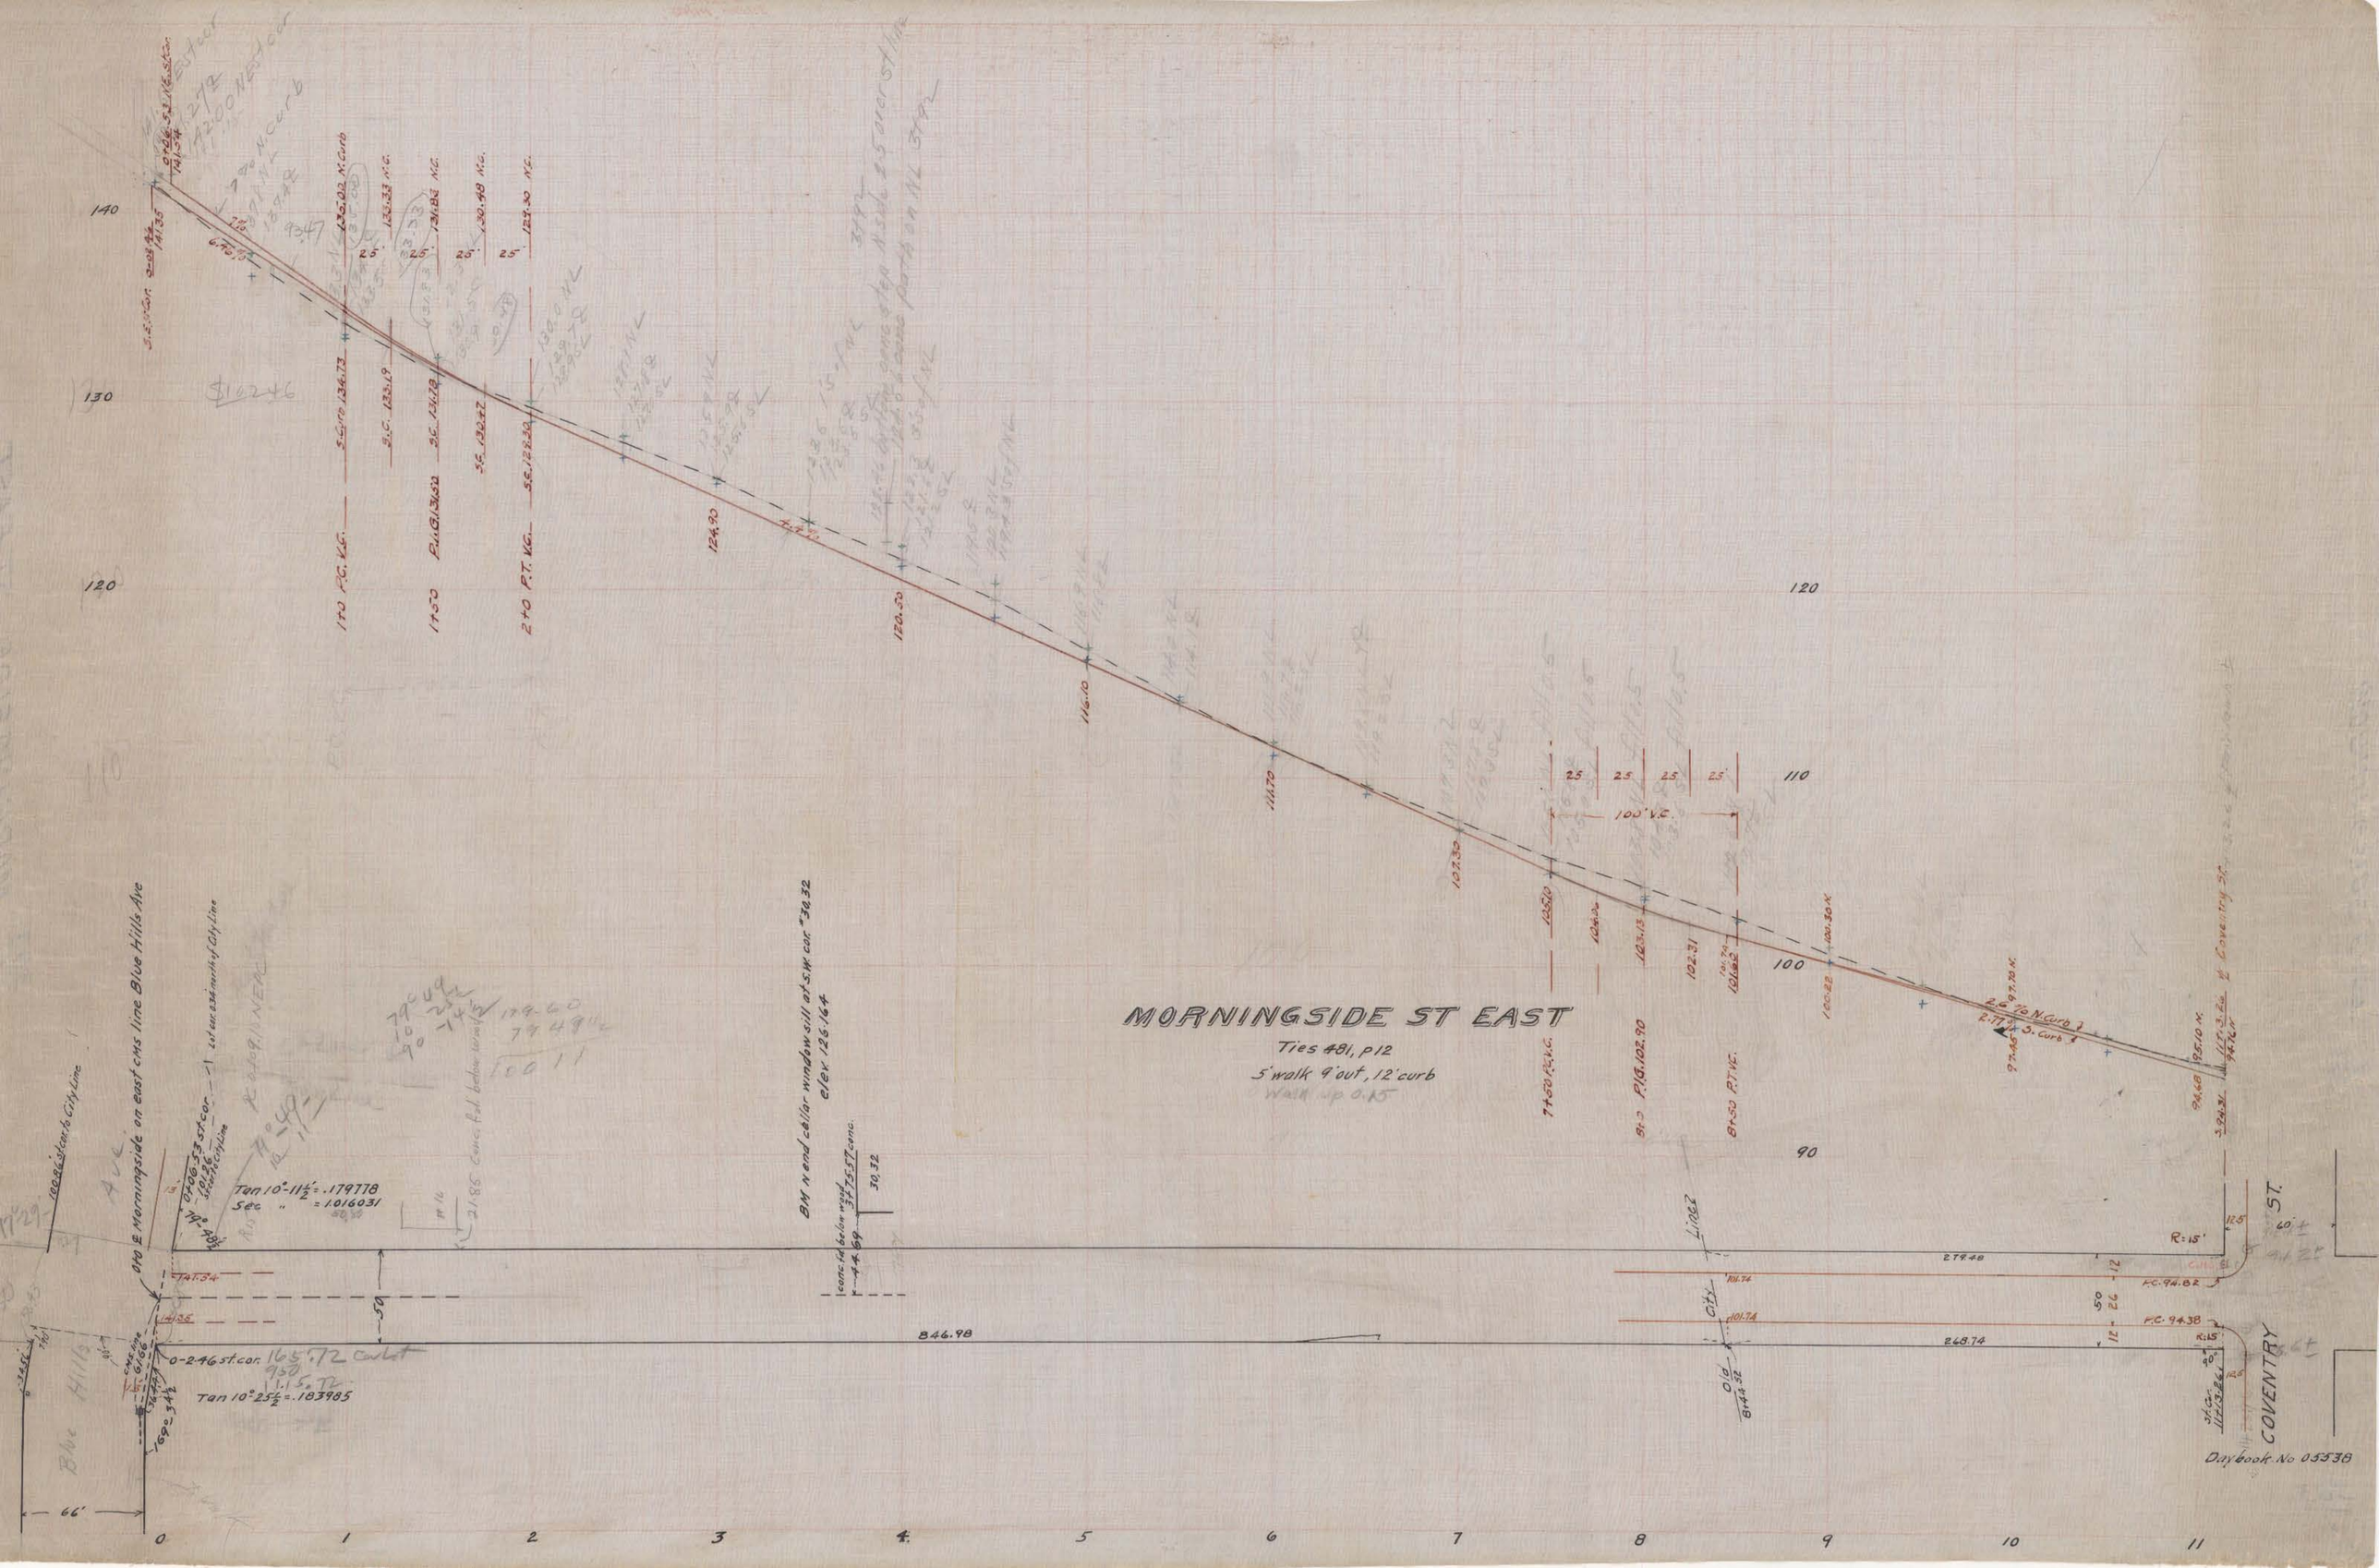
MORNINGSIDE ST EAST
Ties 481, p12
5' walk 9' out, 12' curb
Walk up 0.15
Day Ave E Morningside on east cms line Blue Hills Ave
100' S. of Int. City Line
Tan 10°-11½' = .179778
Sec " = 1.016031
0-246 st. cor.
Tan 10°-25½' = .183985
BM N end cellar window sill at S.W. cor. #38.32
elev. 126.164
846.98
268.74
274.48
100' V.C.
COVENTRY ST.
Daybook No 05538