
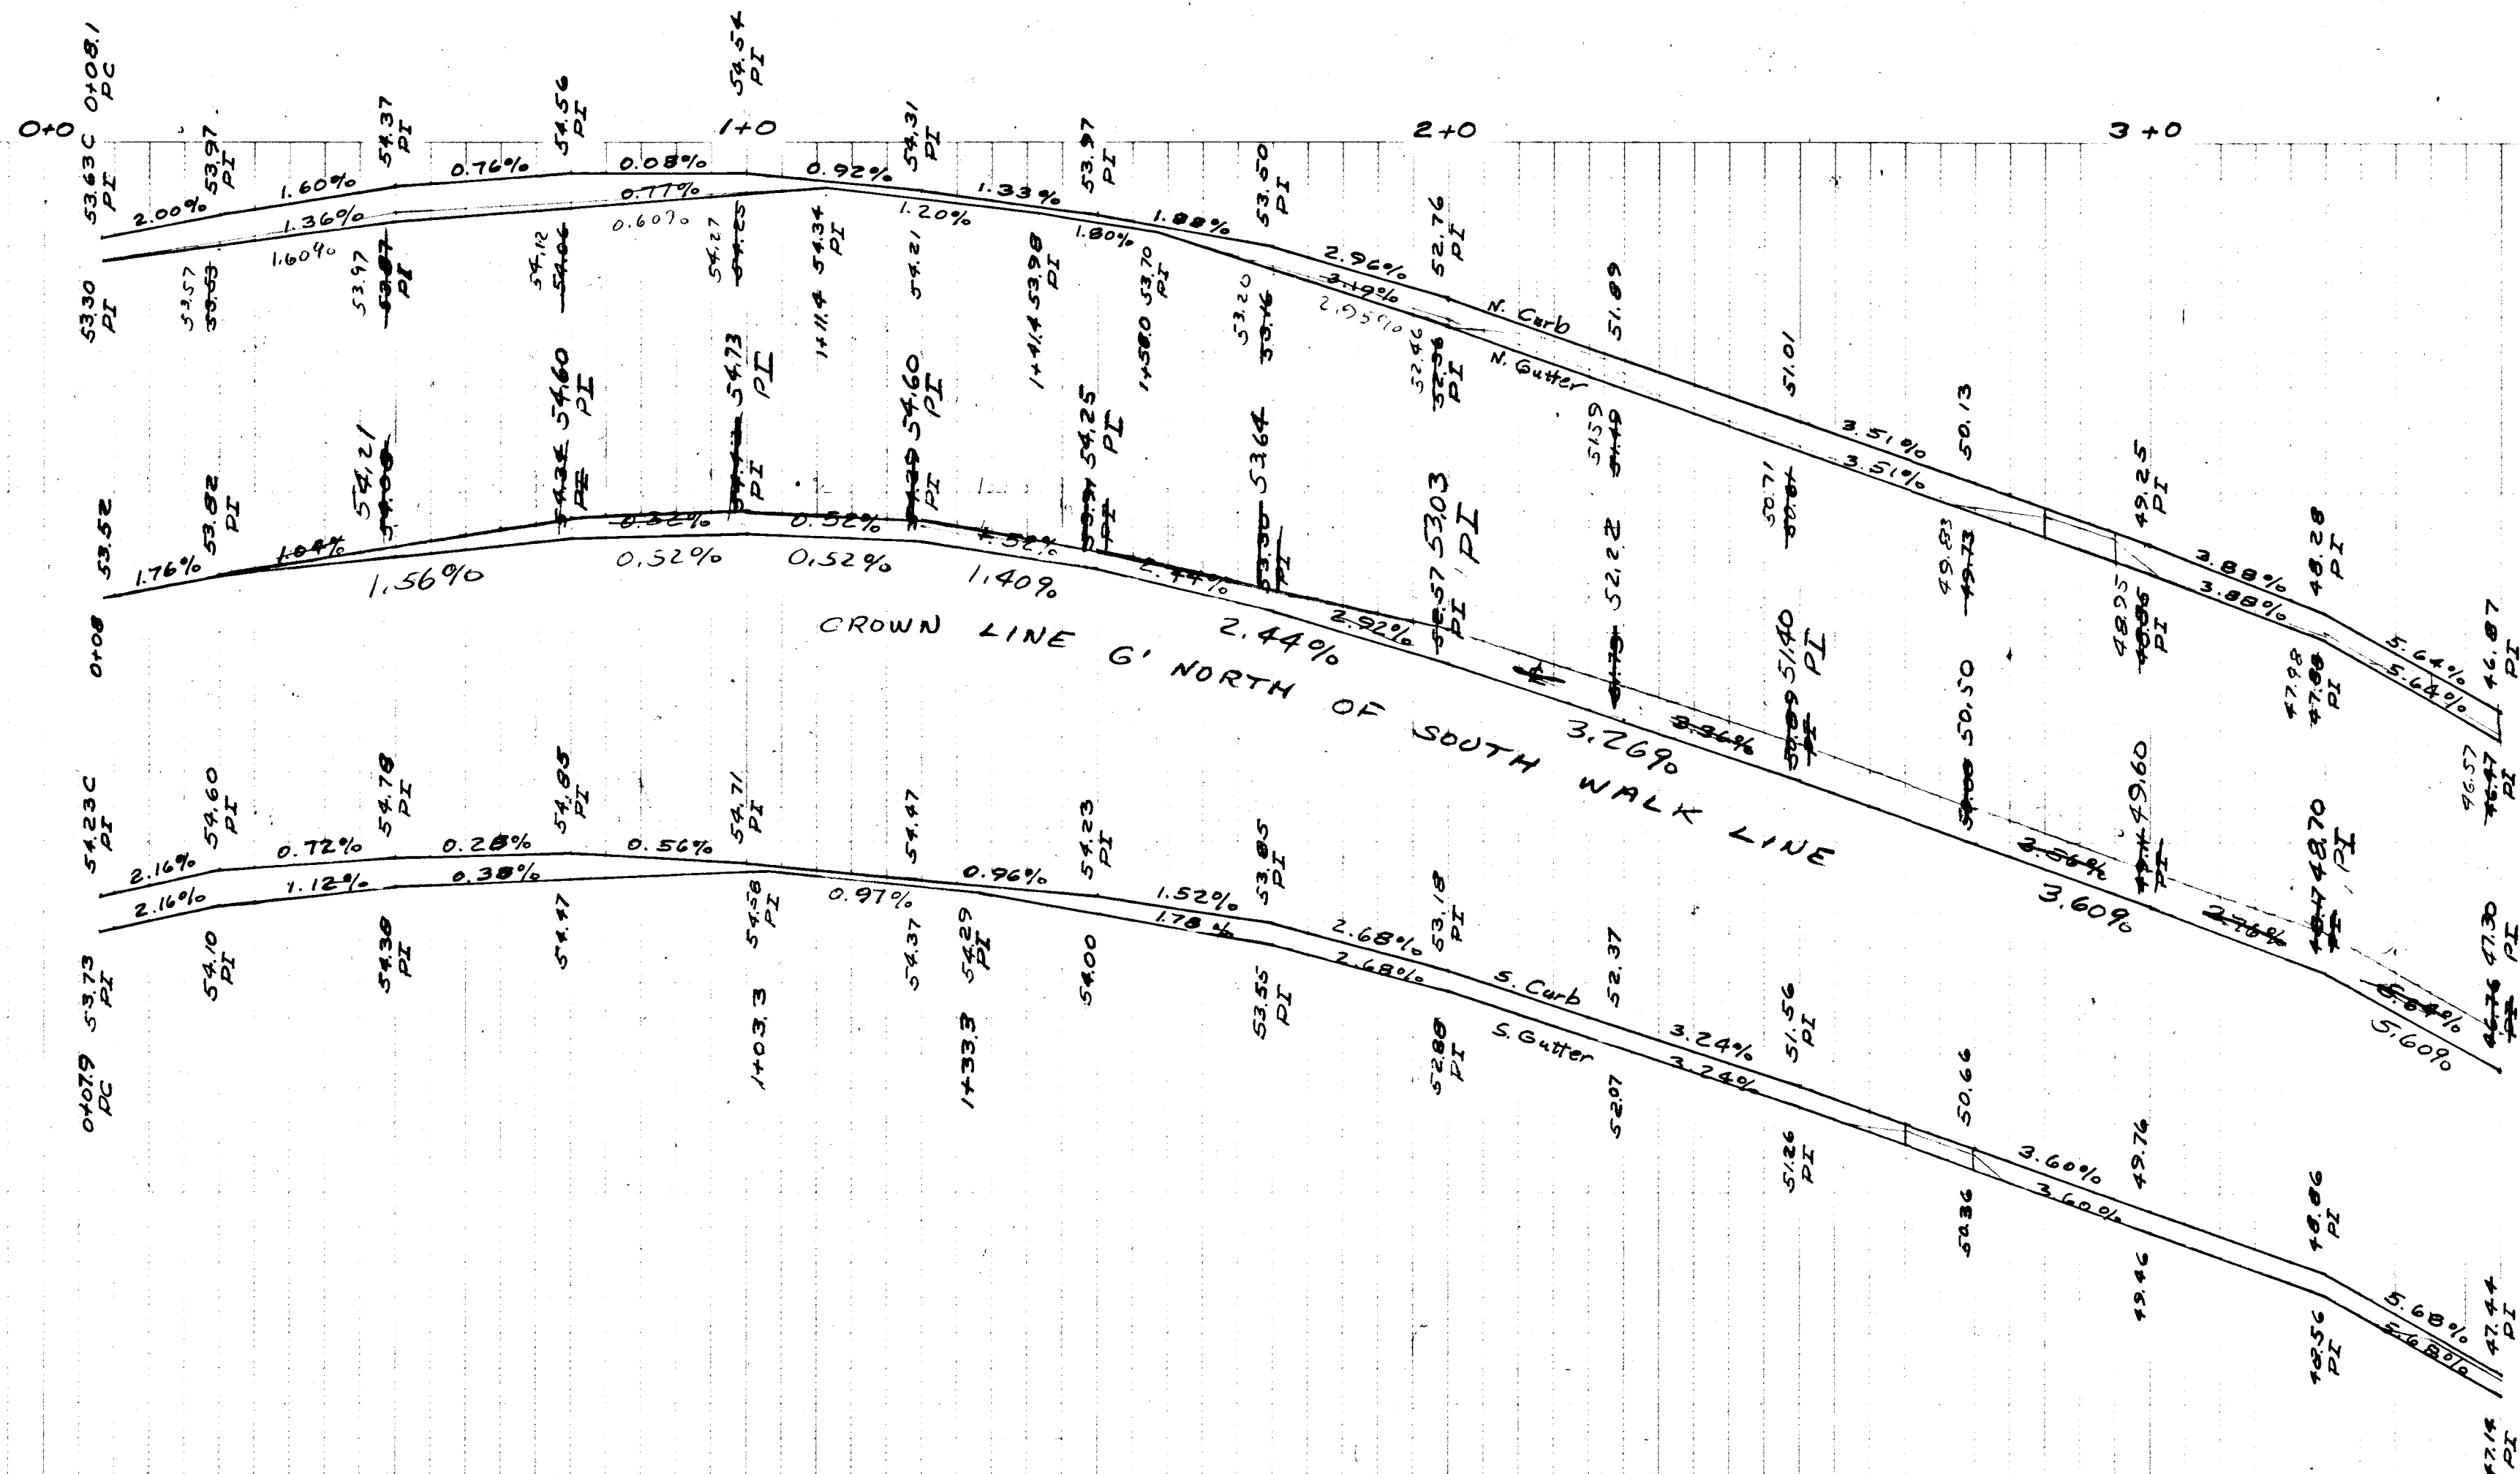


WETHERSFIELD AVE.

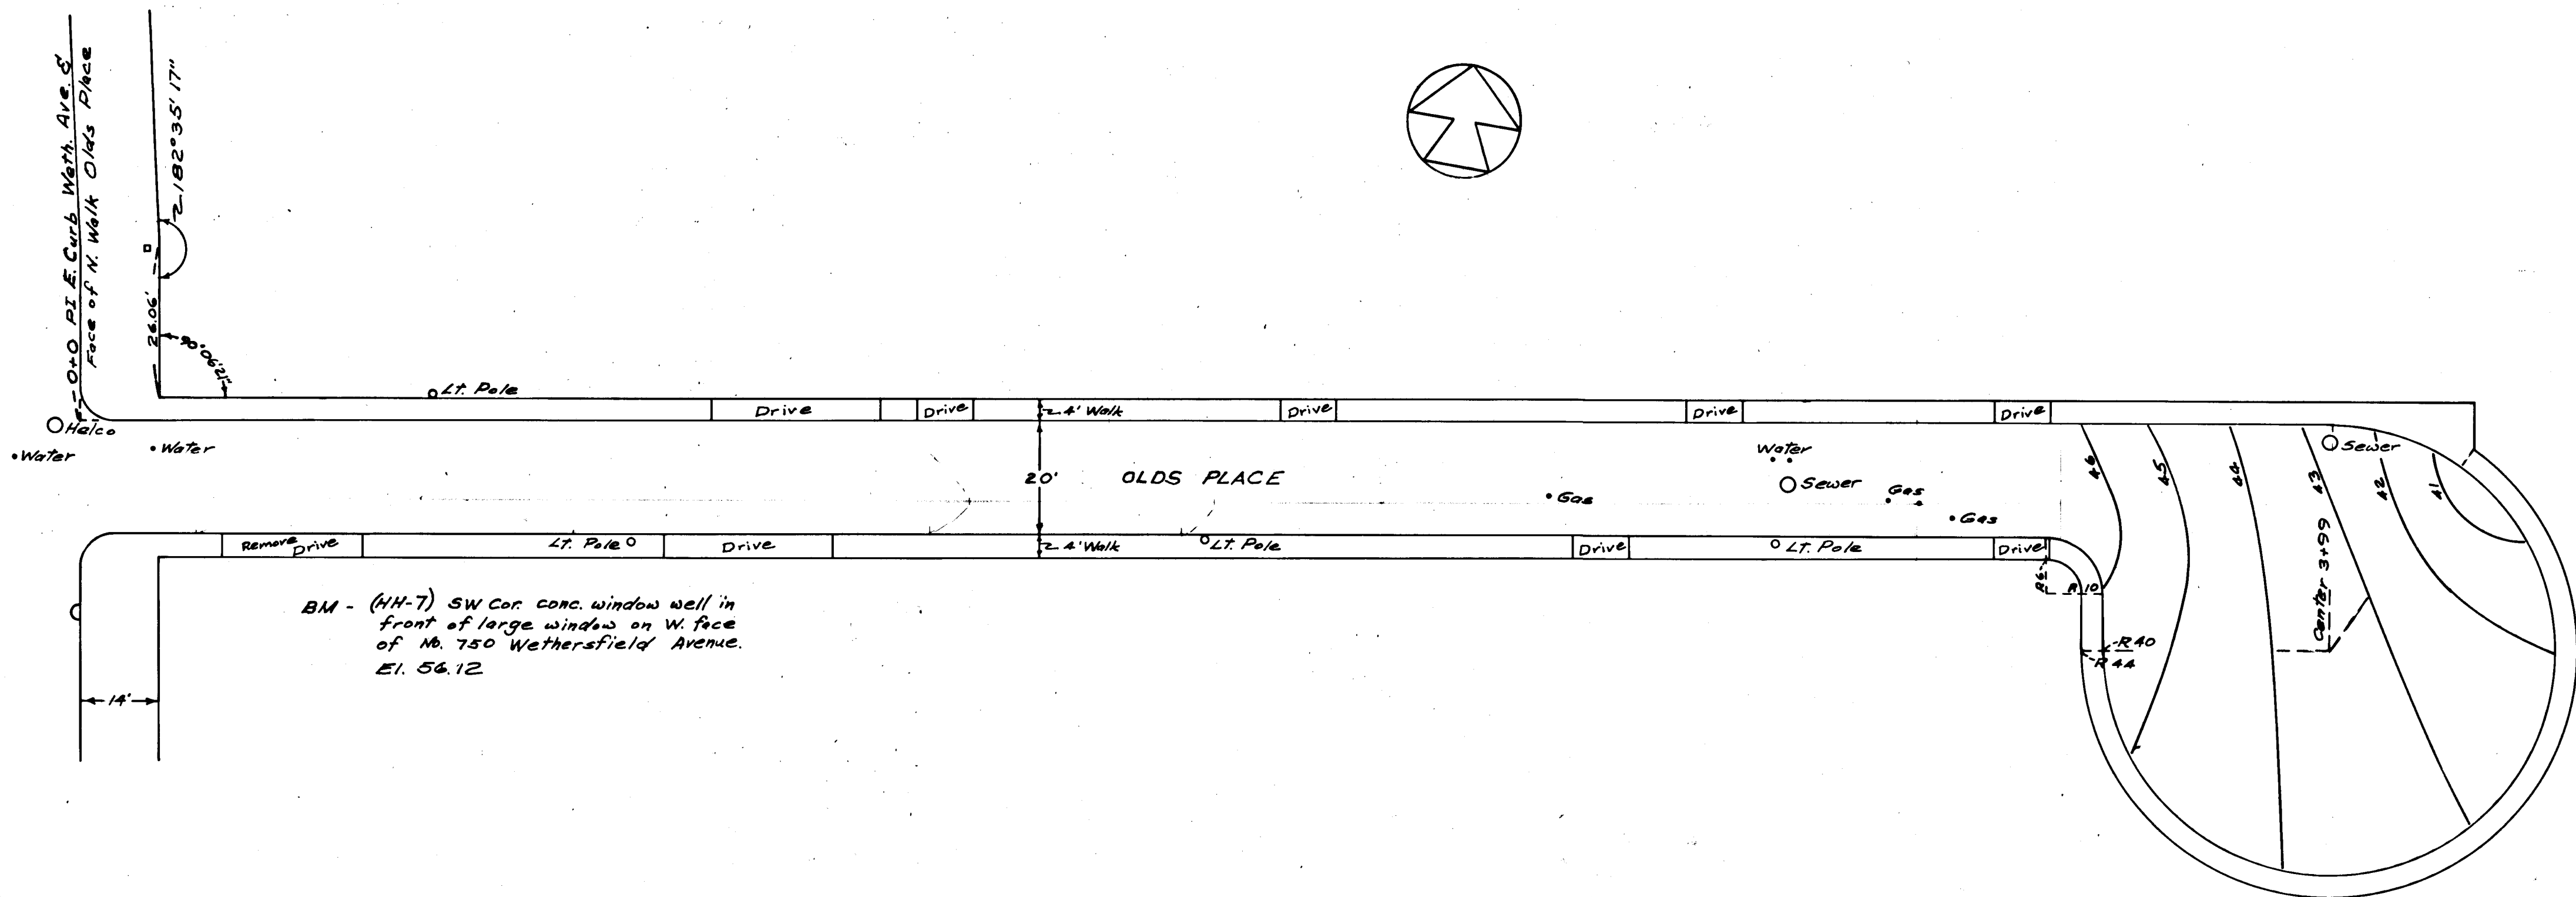

Fied Notes from Book B62 pg. 100

CITY OF HARTFORD, CONNECTICUT DEPARTMENT OF PUBLIC WORKS BUREAU OF ENGINEERING SERVICES		
Plan and profile of OLD'S PLACE		
SUBMITTED	RECOMMENDED	APPROVED
DIVISION ENGINEER	CHIEF OF ENG. SERV.	ASST. DIR. & CITY ENG.
DRAWN <u>AF</u>	SCALE H. 1"=20' V. 1"=2'	DAYBOOK NO. 010570
CHECKED		DATE JULY 1976