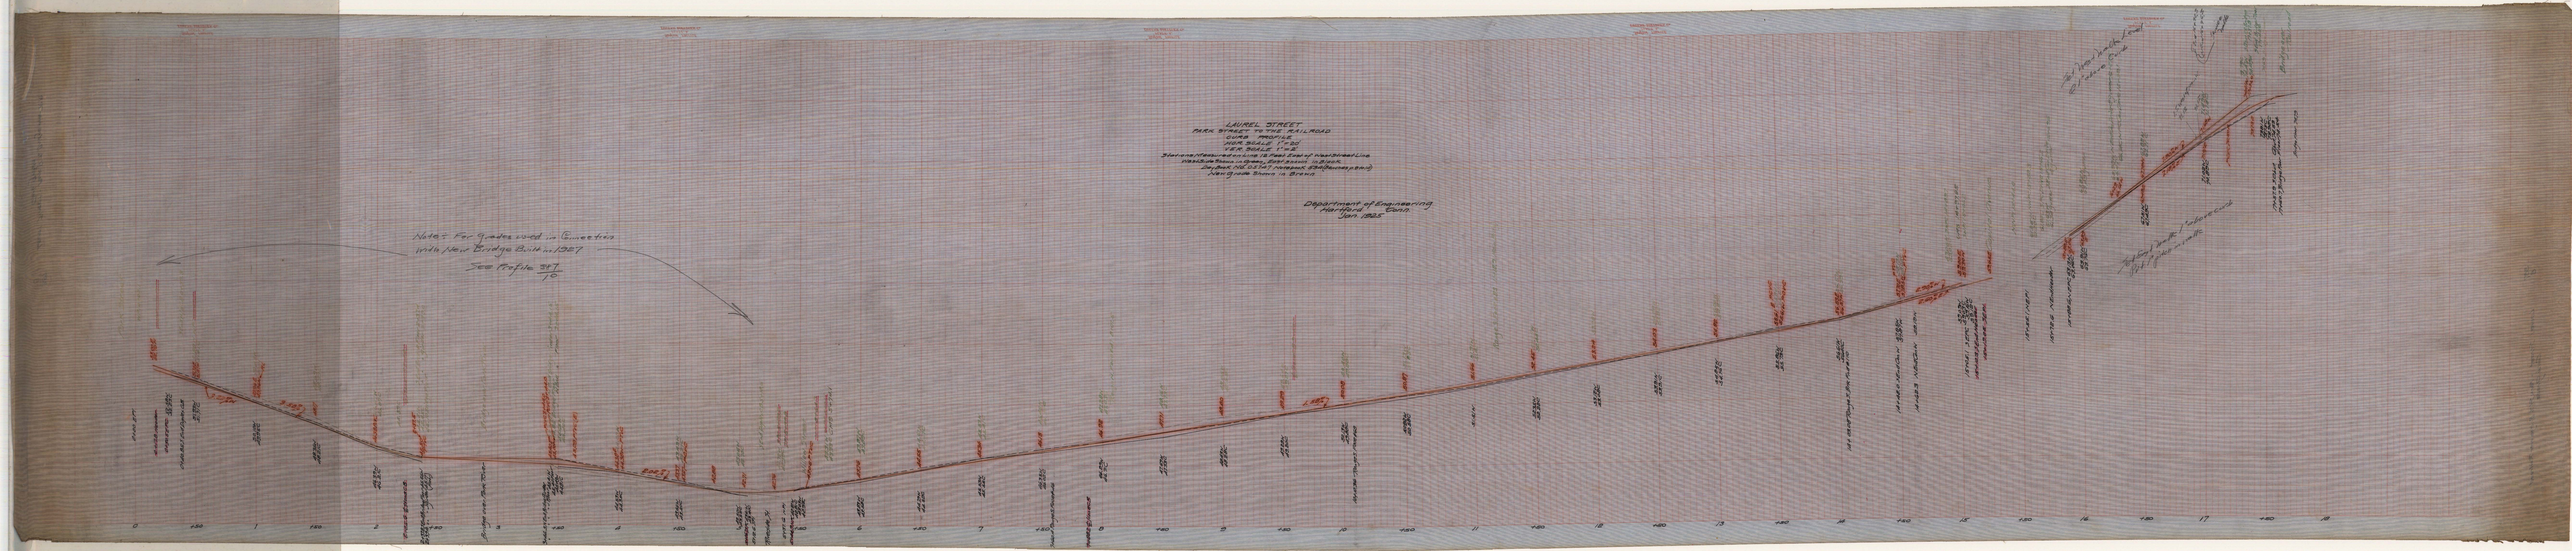
LAUREL STREET
PARK STREET TO THE RAILROAD
HOR. SCALE 1"=20'
VER. SCALE 1"=2'
Department of Engineering
Hartford, Conn.
Jan. 1925
Note: For Grades used in Connection with New Bridge Built in 1927
0
100
1
100
2
100
3
100
4
100
5
100
6
100
7
100
8
100
9
100
10
100
11
100
12
100
13
100
14
100
15
100
16
100
17
100
18