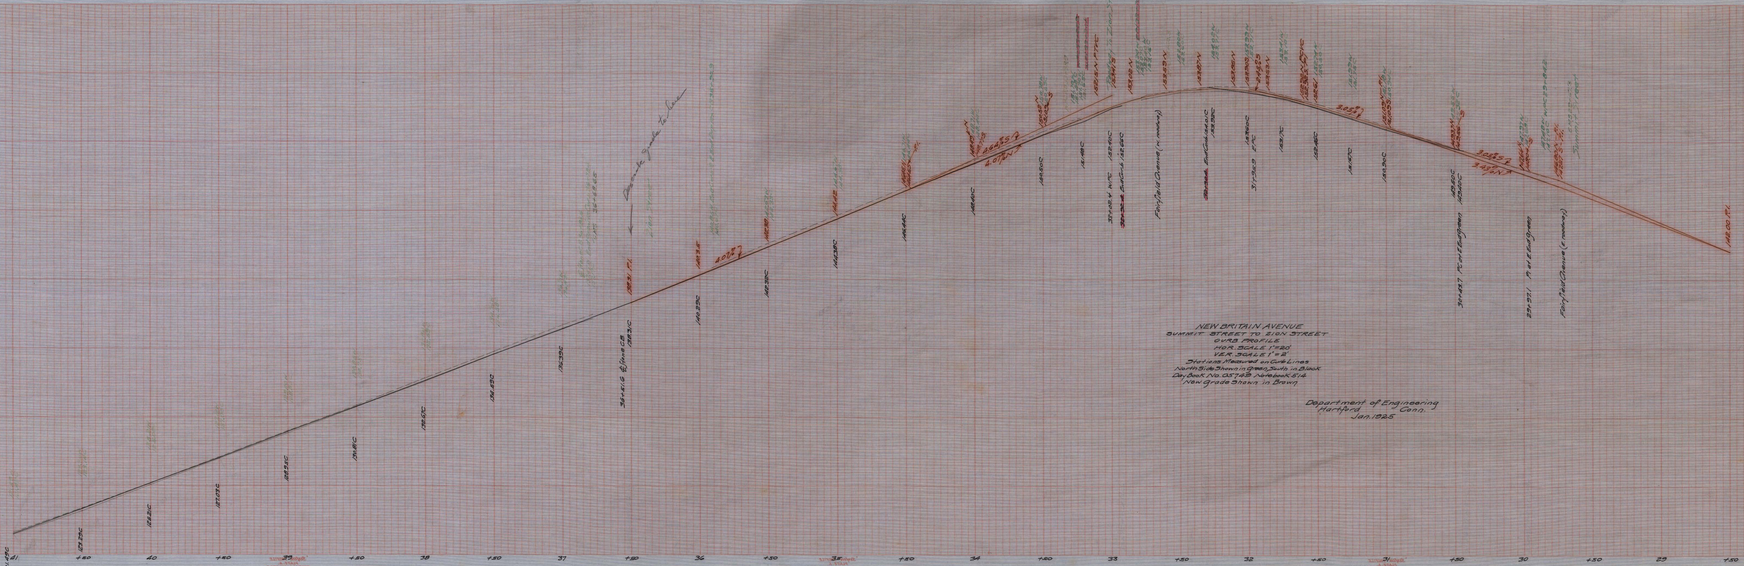
NEW BRITAIN AVENUE
HOR. SCALE 1"=20'
VER. SCALE 1"=5'
Elevations Measured on Cut Lines
North Side Shown in Green, South in Black
Day Book No. 05 Page 148 Notebook 818
Department of Engineering
Hartford, Conn.
Jan. 1925