

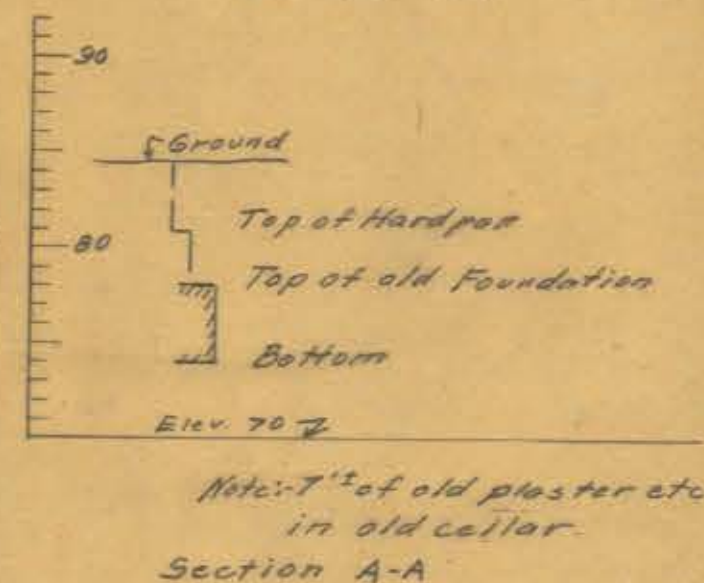
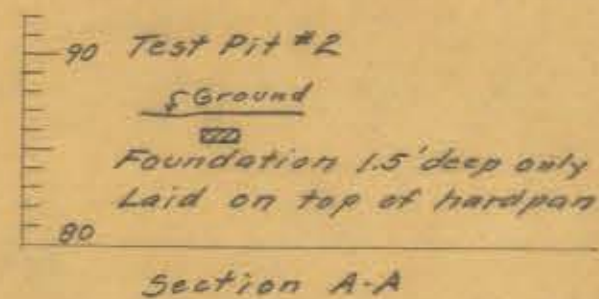


PARK


TERRACE

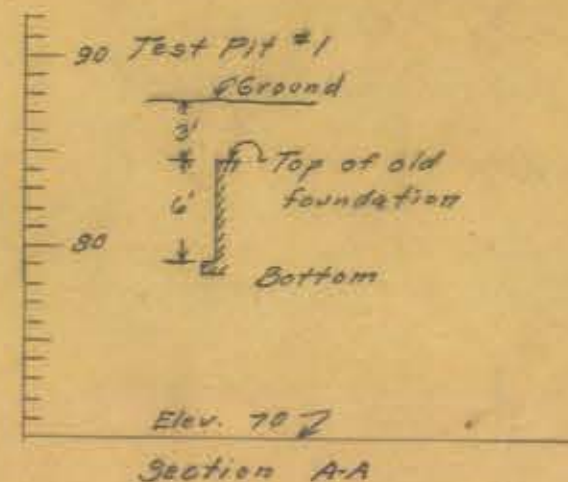

Profiles of Test Pits
Vert. Scale = 1" = 10'

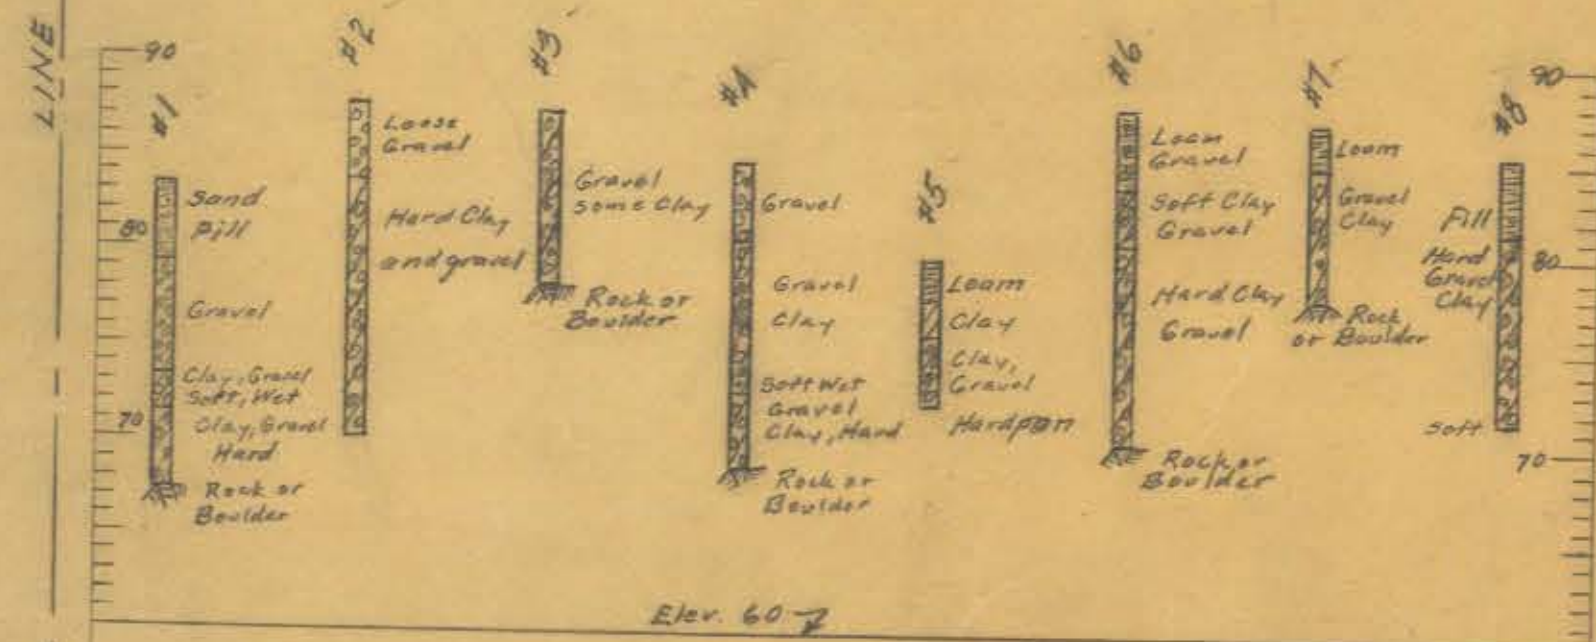

Profile of Borings
Vert. Scale 1" = 10'
Note: - Borings made with 2" auger

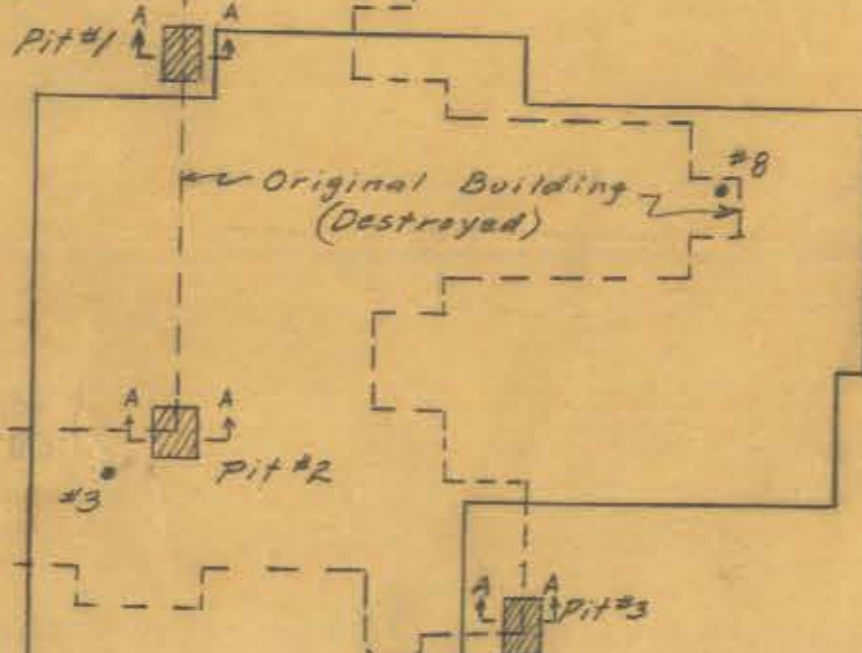

State Taking = 0.2 Acre

State Taking
1962

CITY OF HARTFORD
DEPARTMENT OF ENGINEERING
SCALE 1" = 40' DATE July 8, 1938

Record of Borings and Test Pits
School Property
PUTNAM AND RUSS STS.

(Roll with 400/3)

Traced - WGD