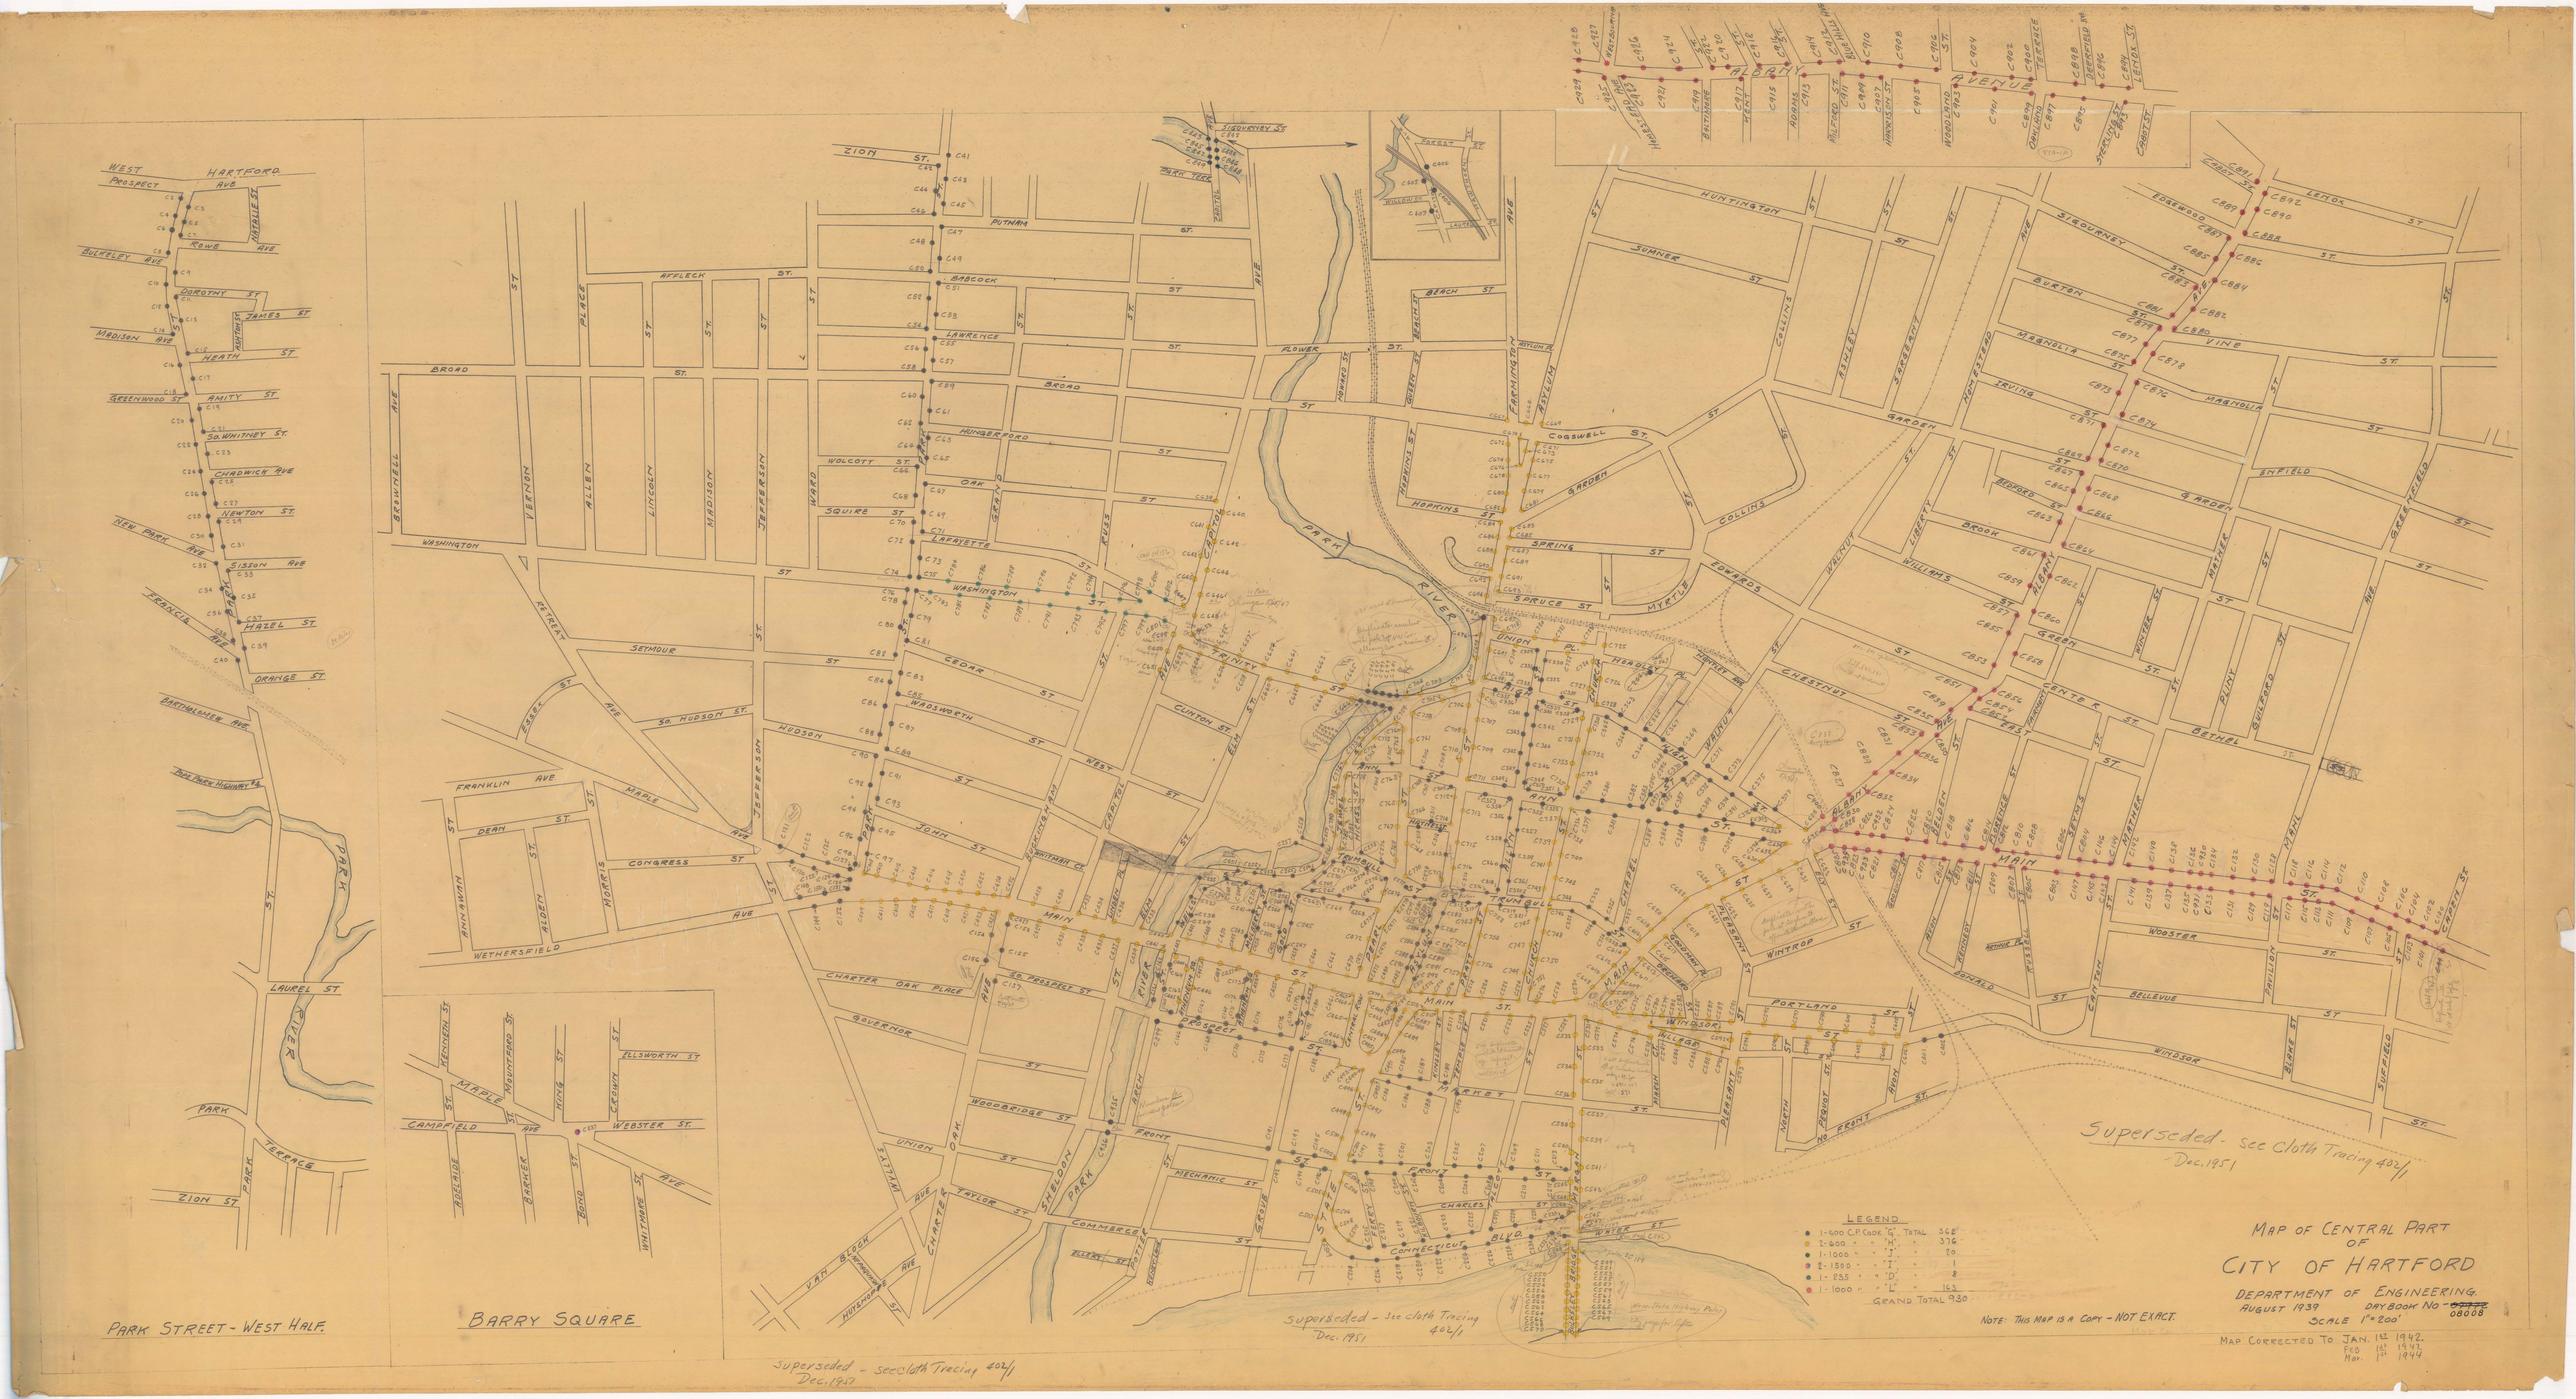
MAP OF CENTRAL PART OF CITY OF HARTFORD
DEPARTMENT OF ENGINEERING
AUGUST 1939
SCALE 1" = 200'
DAYBOOK NO. 08008
NOTE: THIS MAP IS A COPY - NOT EXACT.
MAP CORRECTED TO JAN. 1st 1942.
FEB 1st 1943
MAR. 1st 1944
LEGEND
1-600 C.P. CODE "G" TOTAL 368
2-600 " " "H" " 376
1-1000 " " "I" " 20
2-1500 " " "T" " 1
1-255 " " "D" " 8
1-1000 " " "E" " 162
GRAND TOTAL 930
Superseded - See Cloth Tracing 402/1 Dec. 1951
PARK STREET - WEST HALF
BARRY SQUARE
Superseded - See cloth Tracing 402/1 Dec. 1951
Superseded - See cloth Tracing 402/1 Dec. 1951
WEST HARTFORD
PROSPECT AVE
ROWE AVE
BULKELEY AVE
DOROTHY ST
JAMES ST
MADISON AVE
HEATH ST
GREENWOOD ST
AMITY ST
SO. WHITNEY ST.
CHADWICK AVE
NEWTON ST
NEW PARK AVE
SISSON AVE
FRANCIS AVE
HAZEL ST
ORANGE ST
BARTHOLOMEW AVE
NEW BRITAIN HIGHWAY
PARK RIVER
LAUREL ST
PARK TERRACE
ZION ST
PARK ST
ZION ST
PUTNAM ST
APPLECK ST
BABCOCK ST
LAWRENCE ST
BROAD ST
HUNGERFORD ST
WOLCOTT ST
OAK ST
SQUIRE ST
LAFAYETTE ST
WASHINGTON ST
CEDAR ST
WADSWORTH ST
SETMOUR ST
SO. HUDSON ST
HUDSON ST
FRANKLIN AVE
DEAN ST
CONGRESS ST
WETHERSFIELD AVE
CHARTER OAK PLACE
GOVERNOR ST
WOODBRIDGE ST
FRONT ST
UNION ST
TAYLOR ST
COMMERCE ST
ALLEN PL
VAN BLOCK AVE
HUTCHINGS ST
CHARTER OAK AVE
SHELDON PARK
MECHANIC ST
GROVE ST
CHARLES PL
CONNECTICUT BLVD
WATER ST
RIVER ST
FLOWER ST
BEACH ST
SIGOURNEY ST
MAIN TERR
PARK RIVER
TRUMBULL ST
ASYLUM ST
FARMINGTON AVE
HOPKINS ST
SPRING ST
SPRUCE ST
UNION PL
TRINITY ST
COGSWELL ST
GARDEN ST
COLLINS ST
EDWARDS ST
MYRTLE ST
HUNTINGTON ST
SUMNER ST
ASHLEY ST
SARGENT ST
BURTON ST
MAGNOLIA ST
IRVING ST
EMFIELD ST
BROOK ST
WILLIAMS ST
GREEN ST
CHESTNUT ST
CENTER ST
BETHEL ST
BUNKER HILL ST
PLINY ST
WALNUT ST
CHAPEL ST
PEARL ST
ALLYN ST
WINTHROP ST
PORTLAND ST
WINDSOR ST
BELLEVUE ST
WOOSTER ST
MAIN ST
ROSEWOOD ST
SETON ST
VINE ST
SUFFIELD ST
BLAKE ST
CAPITOL AVE
WEST ST
ELM ST
CLINTON ST
WHITNEY CT
ROCKY HILL AVE
BRAINARD PL
WYLLYS ST
WILLIAM ST
WALLACE ST
WOODLAND ST
HOWARD ST
QUEEN ST
BRUNSWICK ST
BROWNELL AVE
VERNON ST
ALLEN PLACE
LINCOLN ST
MADISON ST
JEFFERSON ST
WARD ST
GRAND ST
REED ST
CARTER ST
ESSEX ST
RETREAT AVE
MAPLE AVE
JOHN ST
RANKAMAN ST
ALDEN ST
MORRIS ST
KENSINGTON ST
MAPLE AVE
MOUNTFORD ST
KING ST
CROWN ST
ELLSWORTH ST
CAMPFIELD ST
WEBSTER ST
ROCKLIDE AVE
PARKER ST
BOND ST
WHITMORE ST
AVE