


Roll with $\frac{402}{13}$

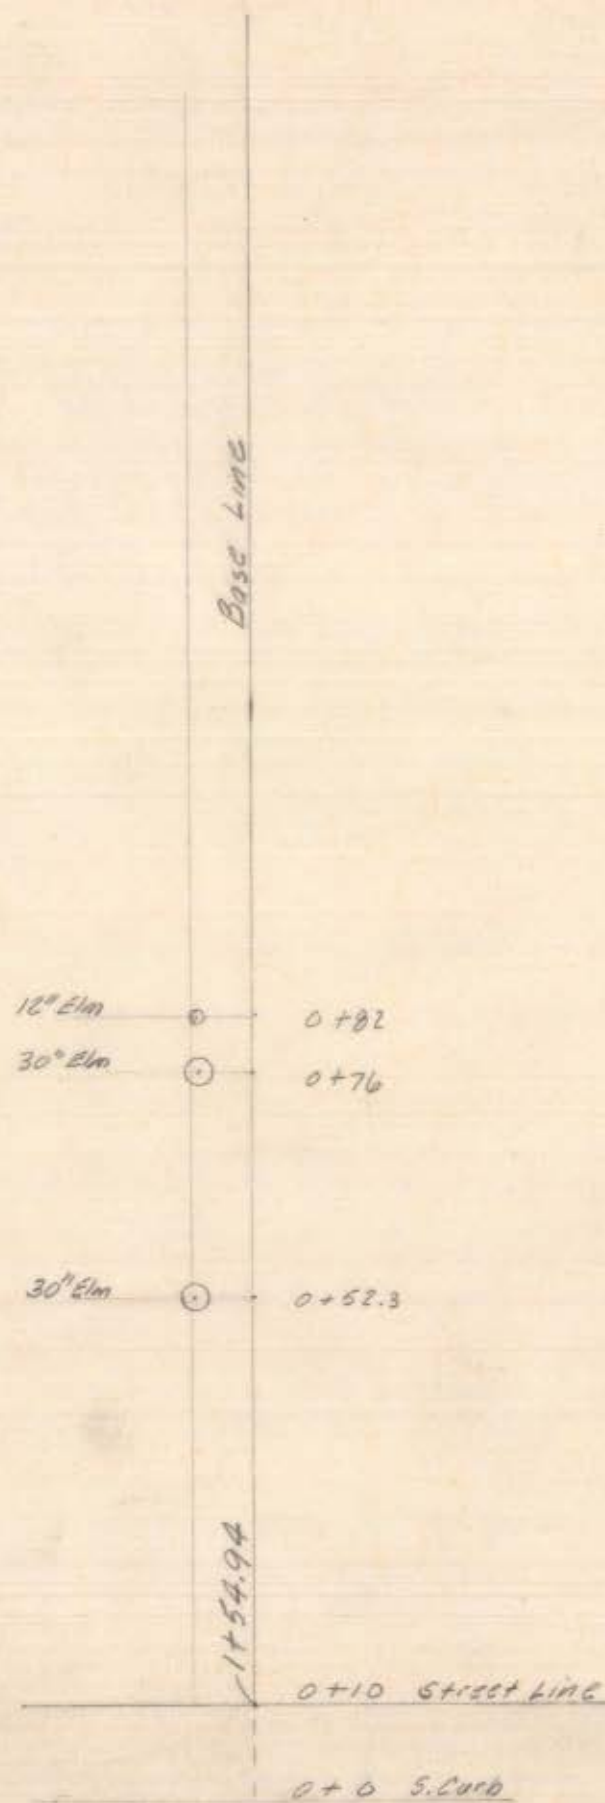

See Plan in Sketch File - "Z" (Zion Hill Cemetery)

March 1968

0+0
Zion Street

1" = 20'