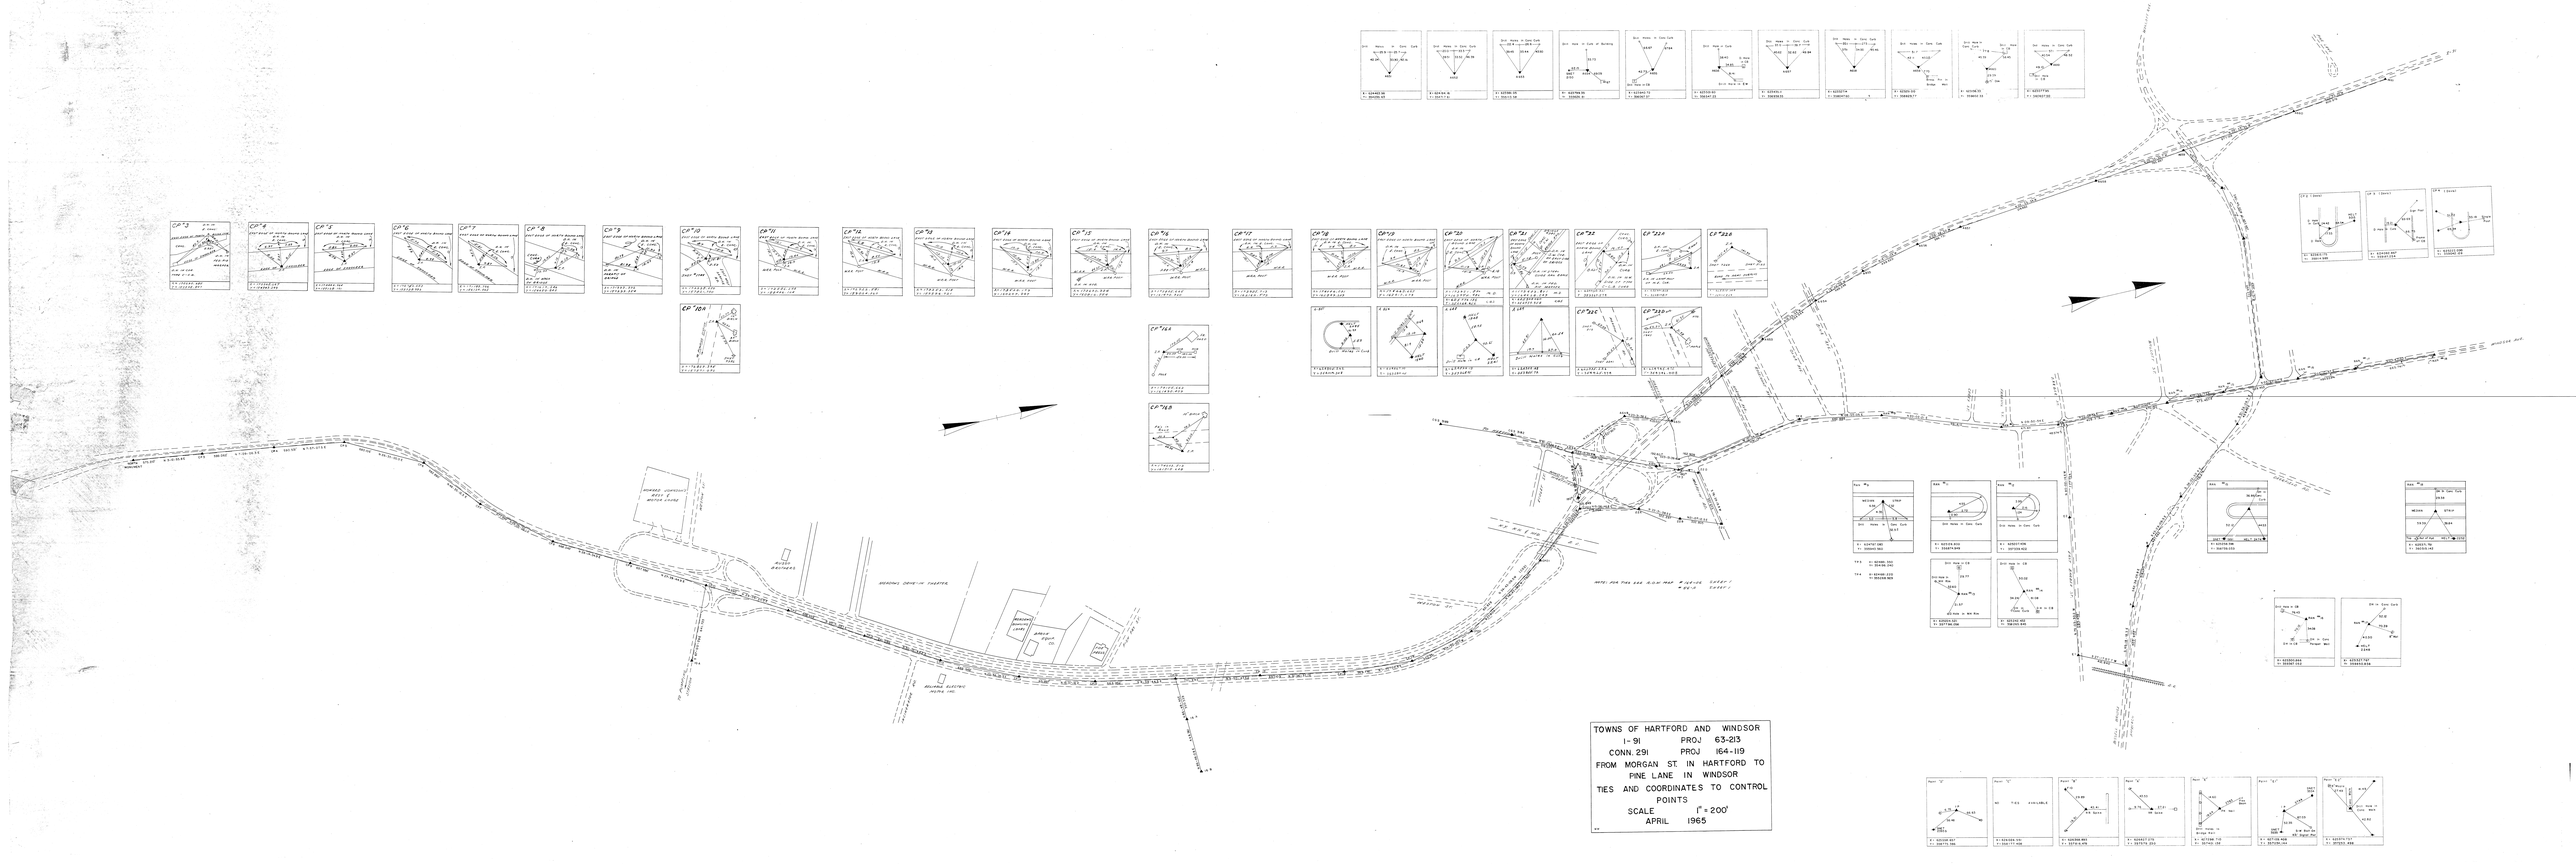

TOWNS OF HARTFORD AND WINDSOR
I-91 PROJ 63-213
CONN. 291 PROJ 164-119
FROM MORGAN ST IN HARTFORD TO
PINE LANE IN WINDSOR
TIES AND COORDINATES TO CONTROL
POINTS
SCALE 1" = 200'
APRIL 1965