


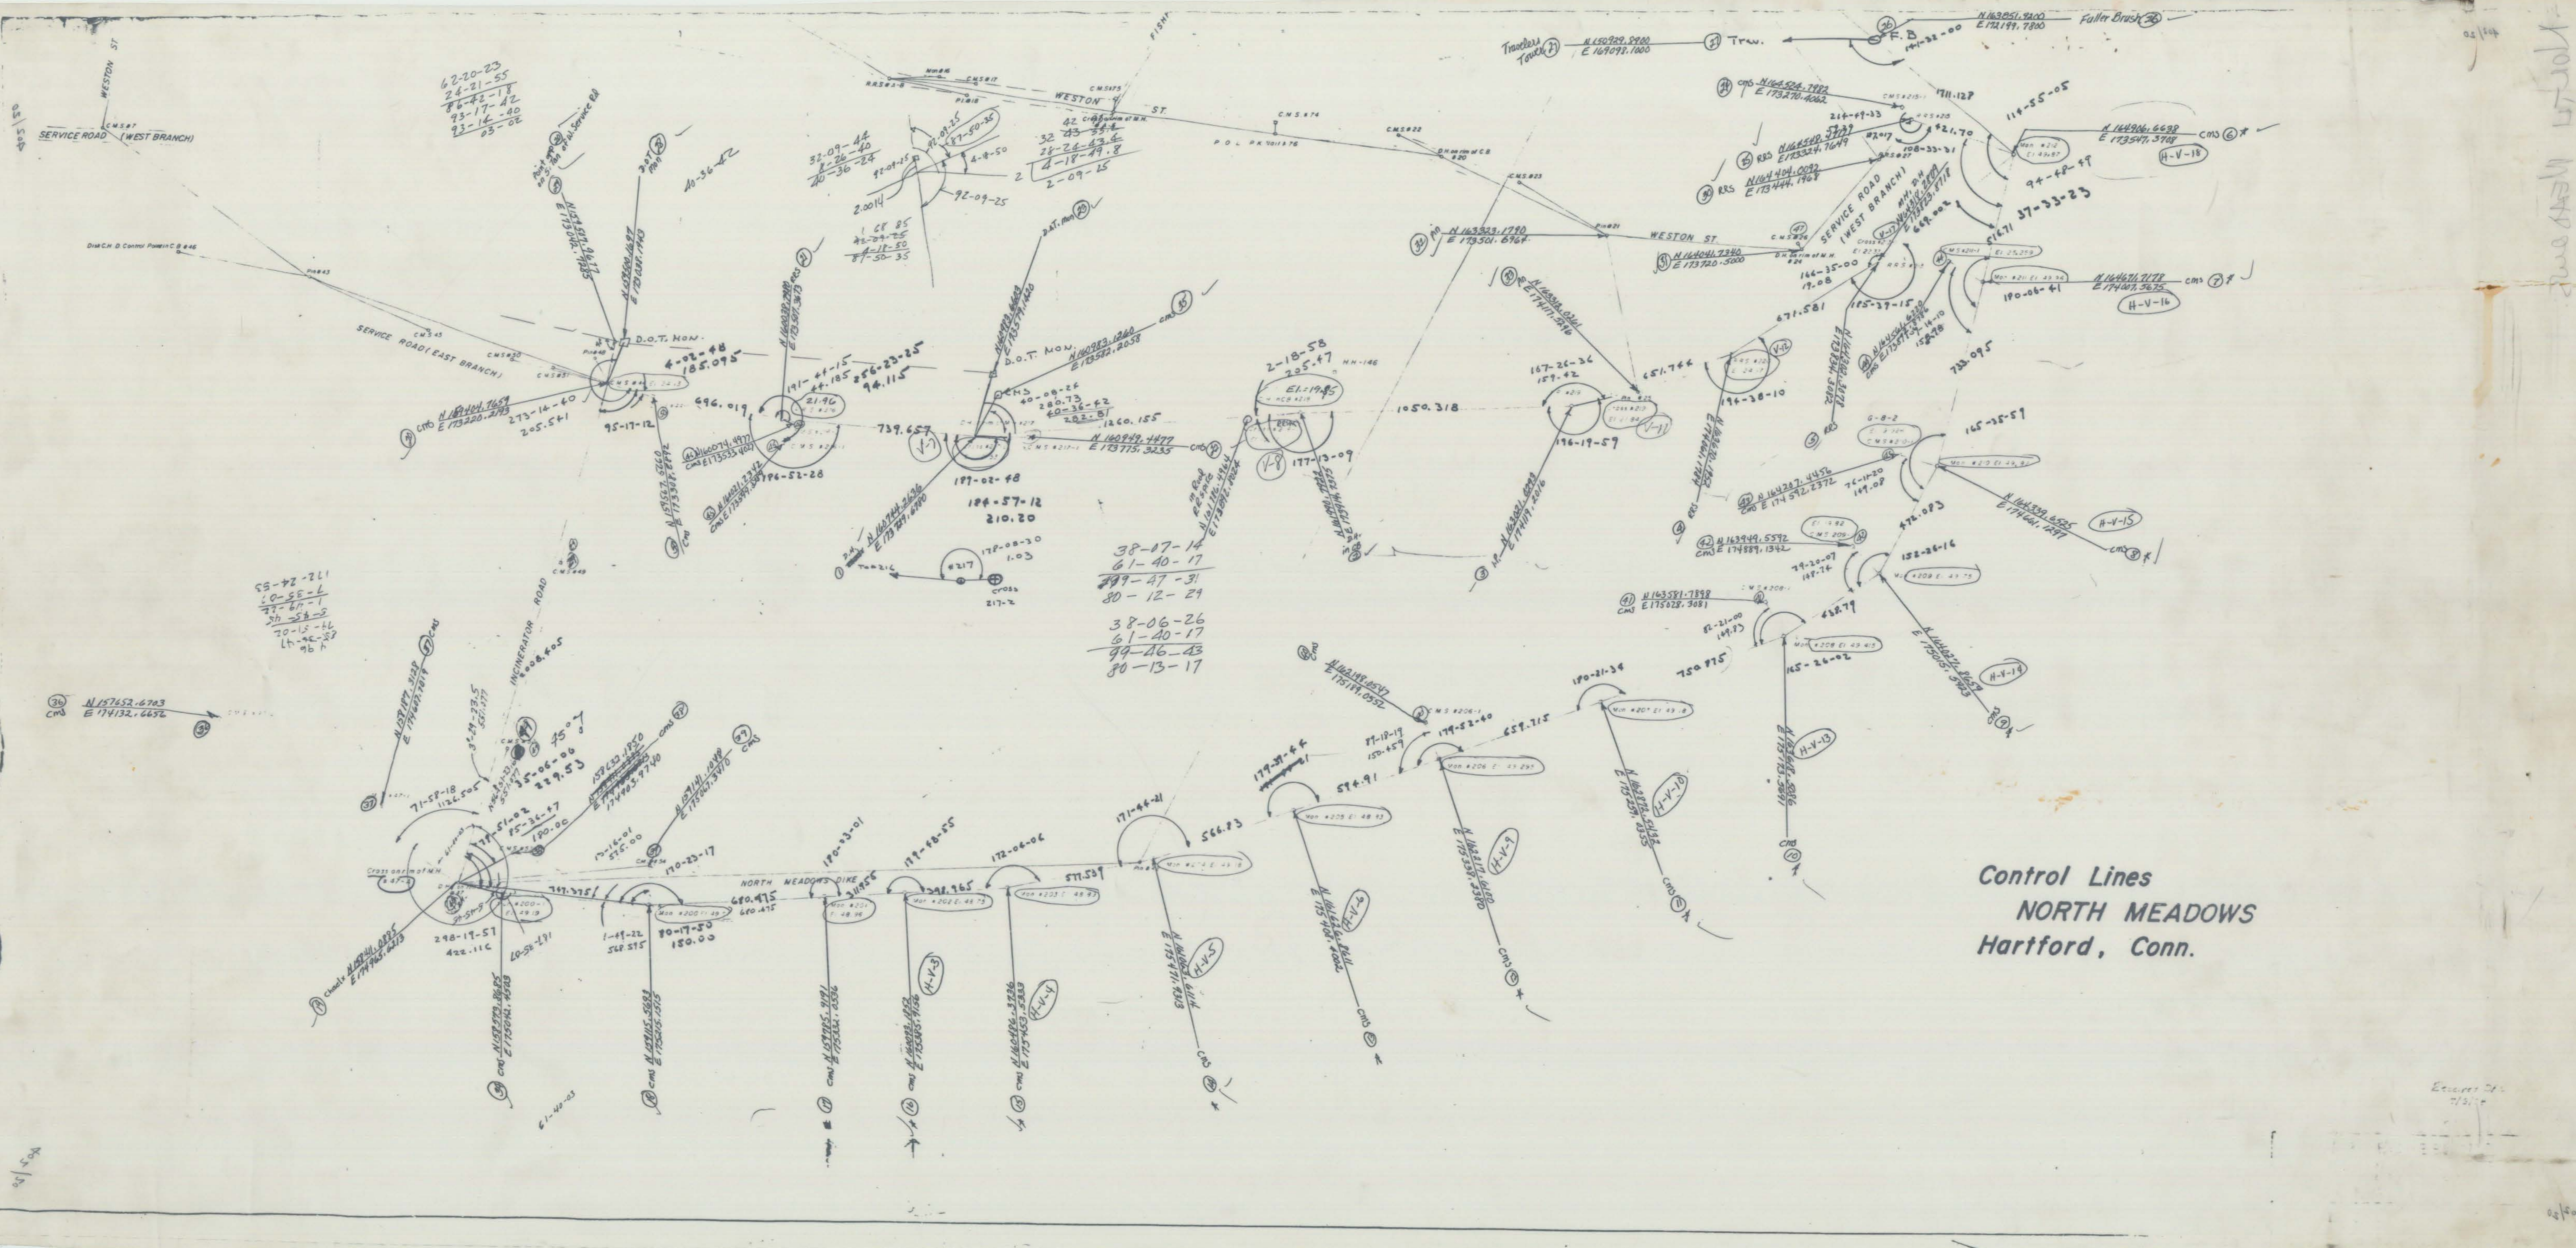

62-20-23
24-21-55
86-42-18
93-17-42
93-14-40
03-02

53-42-21
10-55-6
27-67-1
27-58-3
20-15-46
14-46-57
96-6

25/54

25/54

100-15

25/54

Control Lines
NORTH MEADOWS
Hartford, Conn.