


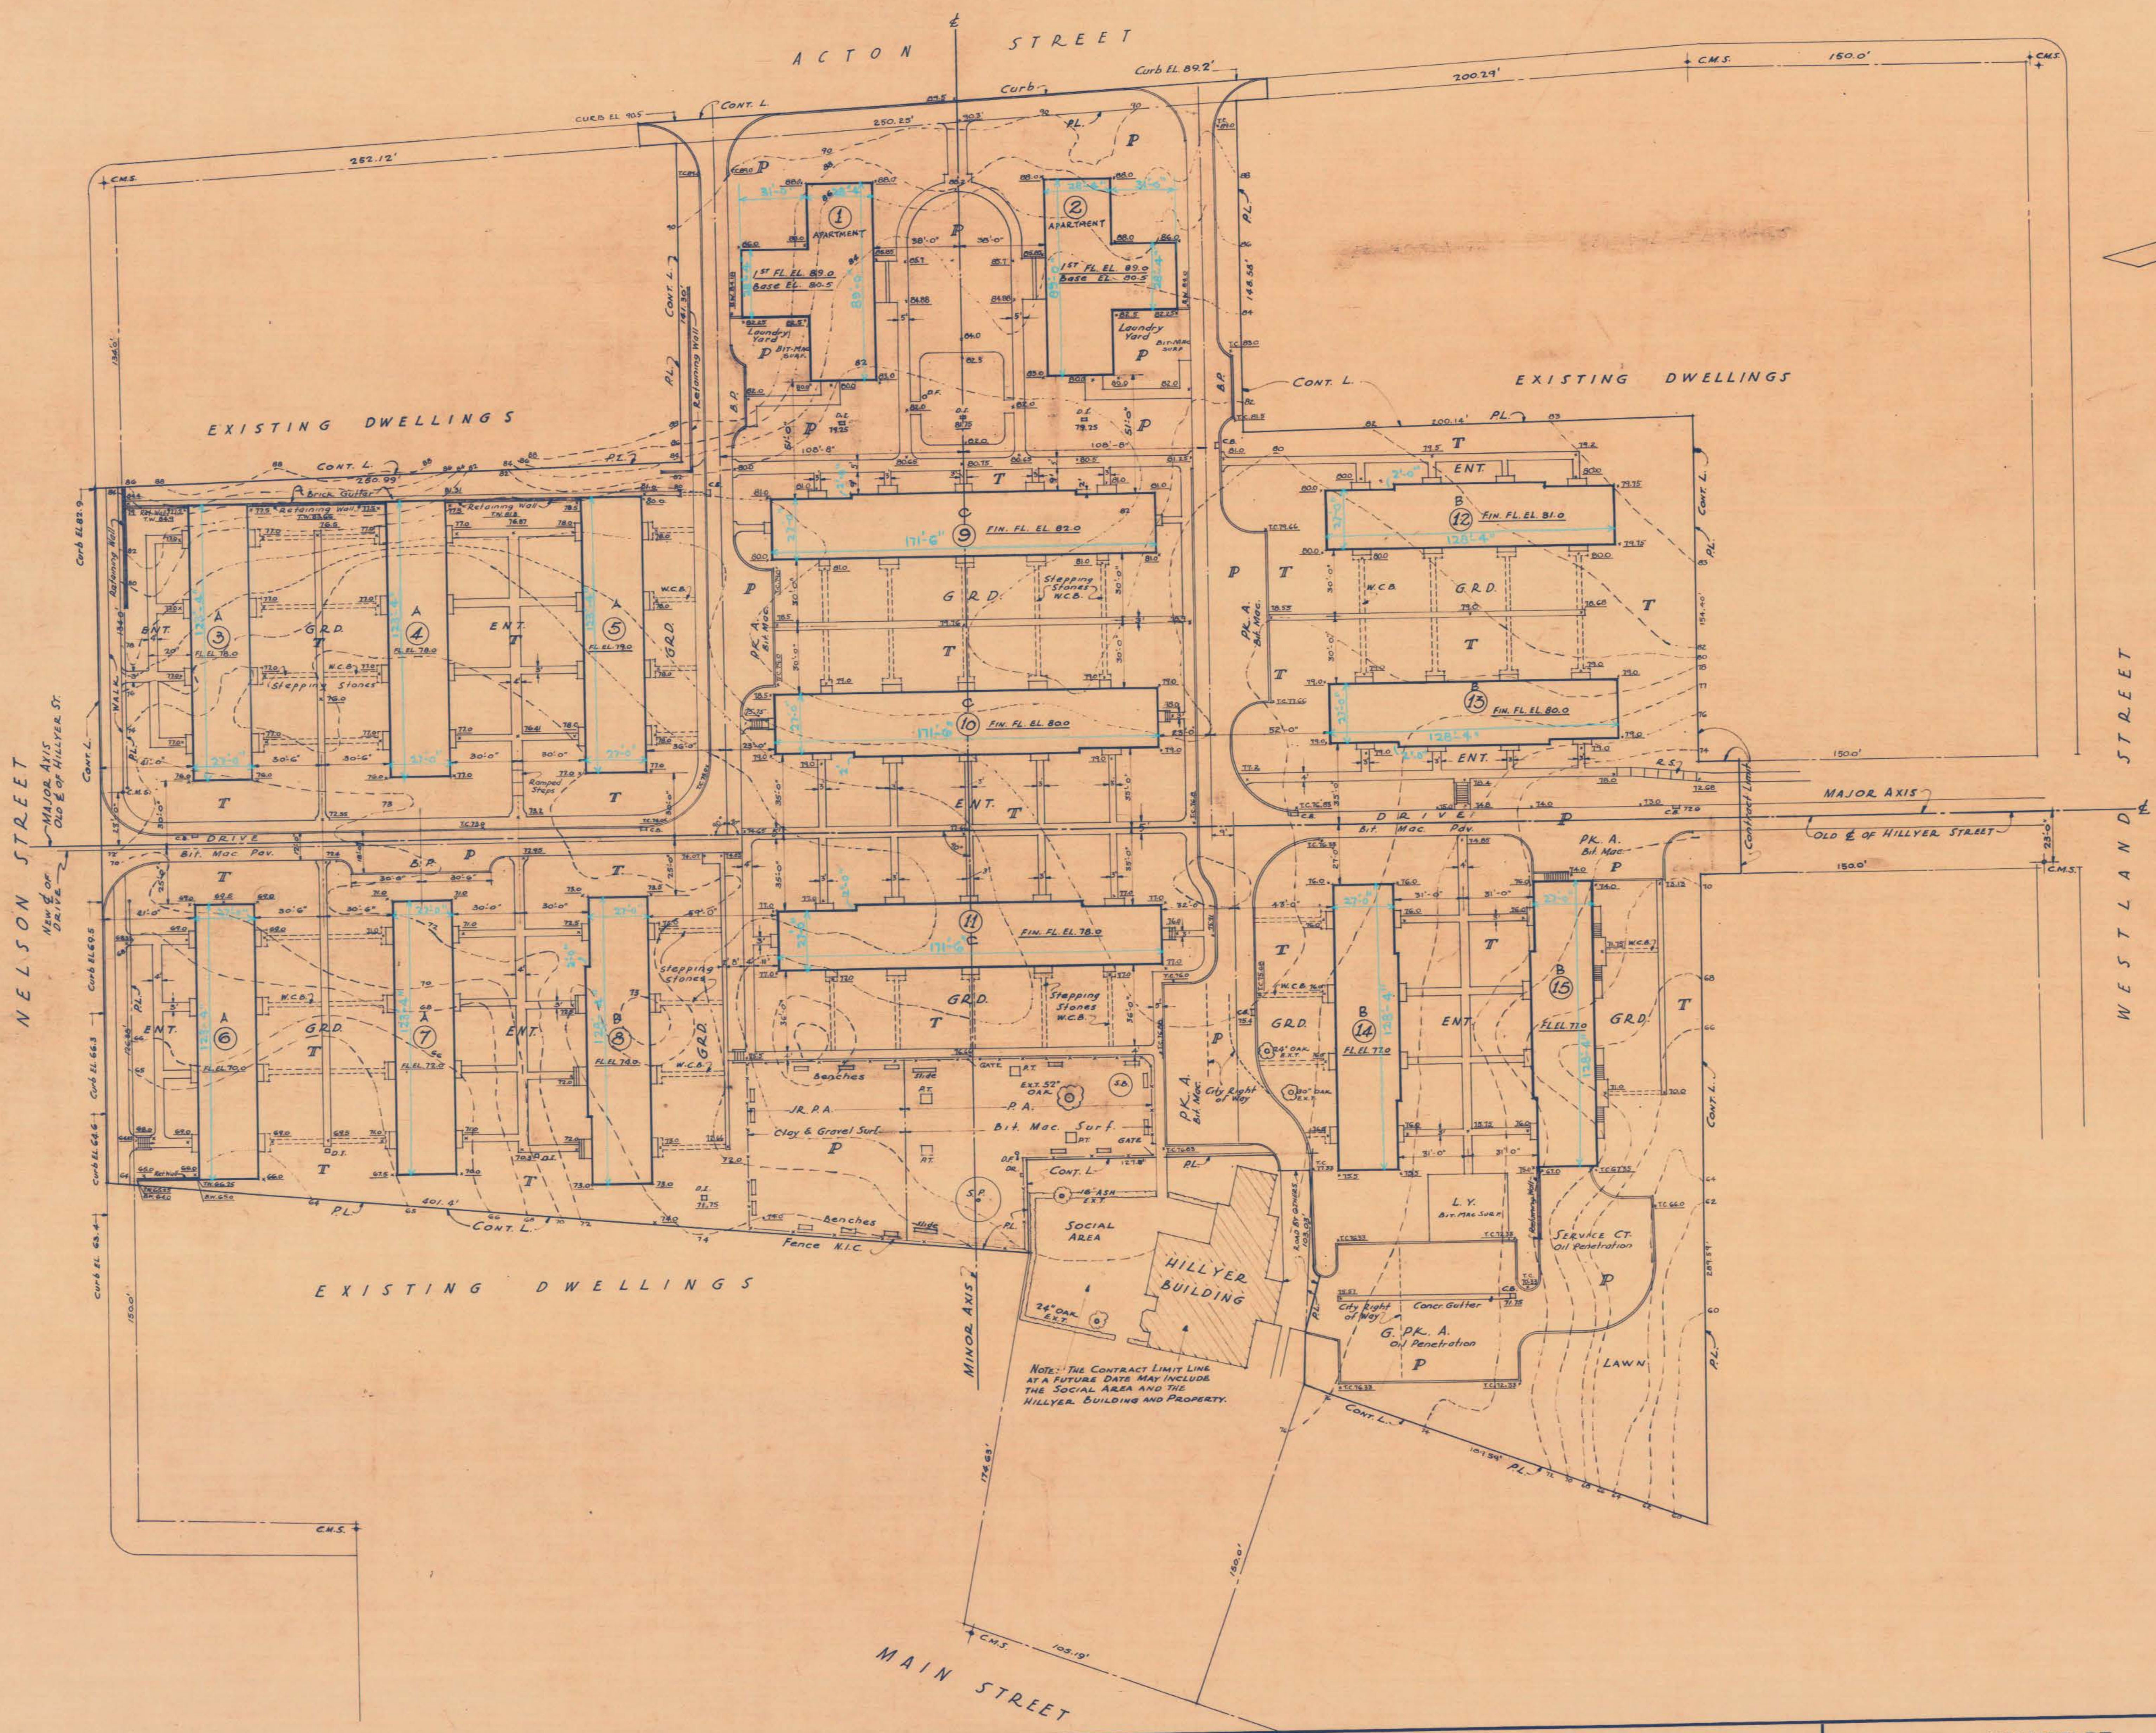

SYMBOL	DESCRIPTION
P	PROJECT MAINTAINED
T	TENANT
GRD	GARDEN
ENT	ENTRANCE
EX.T	EXISTING TREE
CL	CLOTHES LINE - Not Included
CB	CATCH BASIN
PA	PLAY AREA
JR.PA	JUNIOR PLAY AREA
PK.A	PARKING AREA
GPK.A	GENERAL PARKING AREA
T.C.	EL TOP OF CURB
B.C.	BOTTOM OF CURB
T.W.	TOP WALL
W.C.B.	WALK CONC. BLOCKS
FENCE (N.C.)	FENCE (N.C.)
BIT. MAC. SURF.	BITUMINOUS MACADAM SURFACE
" " PAV.	" " PAVING
L.Y.	LAUNDRY YARD
C.B.	CATCH BASIN
S.P.	SPRAY POOL
DF	DRINKING FOUNTAIN
CONT. L.	CONTRACT LIMIT
DR.	DRAIN (S.P. and D.F.)
OB.	OIL PENETRATION
S.B.	SAND BOX
BY-PASS	BY-PASS
R.S.	RAMP STEPS
PL	PROPERTY LINE
DI	DRAIN INLET
AT	PLAY TABLE

NOTE: C.B. INDICATES CATCH BASIN OR DRAIN INLET AT SPECIFIED UNDER SEPARATE DIVISION. LOCATIONS ARE SUBJECT TO SLIGHT CHANGE.

SCHEDULE OF ROOMS						
BLDG#	3 ROOMS	4 ROOMS	5 ROOMS	6 ROOMS	TYPE	# OF STORIES
1	18				APARTMENT	2
2	18					2
3		8			ROWHOUSE TYPE "A"	2
4		8				2
5		8				2
6		8				2
7		8				2
8		4	4		ROWHOUSE TYPE "B"	2
9		4	4			2
10		4	4			2
11		4	4			2
12		4	4			2
13		4	4			2
14		4	4			2
15		4	4			2
16		2	6	2	ROWHOUSE TYPE "C"	2
17		2	6	2		2
18		2	6	2		2
19		2	6	2		2
20		2	6	2		2
TOTAL UNITS	36	66	38	6		
TOTAL ROOMS BY UNITS	108	297	209	39		
TOTAL NUMBER OF ROOMS - 653						

HENRI B. VAN ZELM
PLUMBING & HEATING ENGINEER
11 ASYLUM STREET, HARTFORD, CONN.

PAUL D. BEMIS
ELECTRICAL ENGINEER
36 PEARL STREET, HARTFORD, CONN.

JO RAY & A. CARL STELLING
LANDSCAPE ARCHITECTS
WESTPORT, CONN.

- HILLYER STREET PROJECT - CONN. 3-1 -

THE HOUSING AUTHORITY OF THE CITY OF HARTFORD

HARTFORD, CONN.

UNDER LOAN CONTRACT WITH THE U. S. HOUSING AUTHORITY

CARL J. MALMFELDT
ARCHITECT
36 PEARL STREET, HARTFORD, CONN.

CARL F. HAKEWESSELL
ROBERT H. LIENHARD
ROBERT H. SCHUTZ, JR.
ASSOCIATES

DRAWN BY: J.R.
TRACED BY: J.P.
CHECKED BY: E.N.P. C.J.M.
DATE: OCT/18/1939
SCALE: 1"=30'

TITLE
SITE PLAN

APPROVED

William A. Scott

REVISIONS

SHEET NUMBER
L 501