


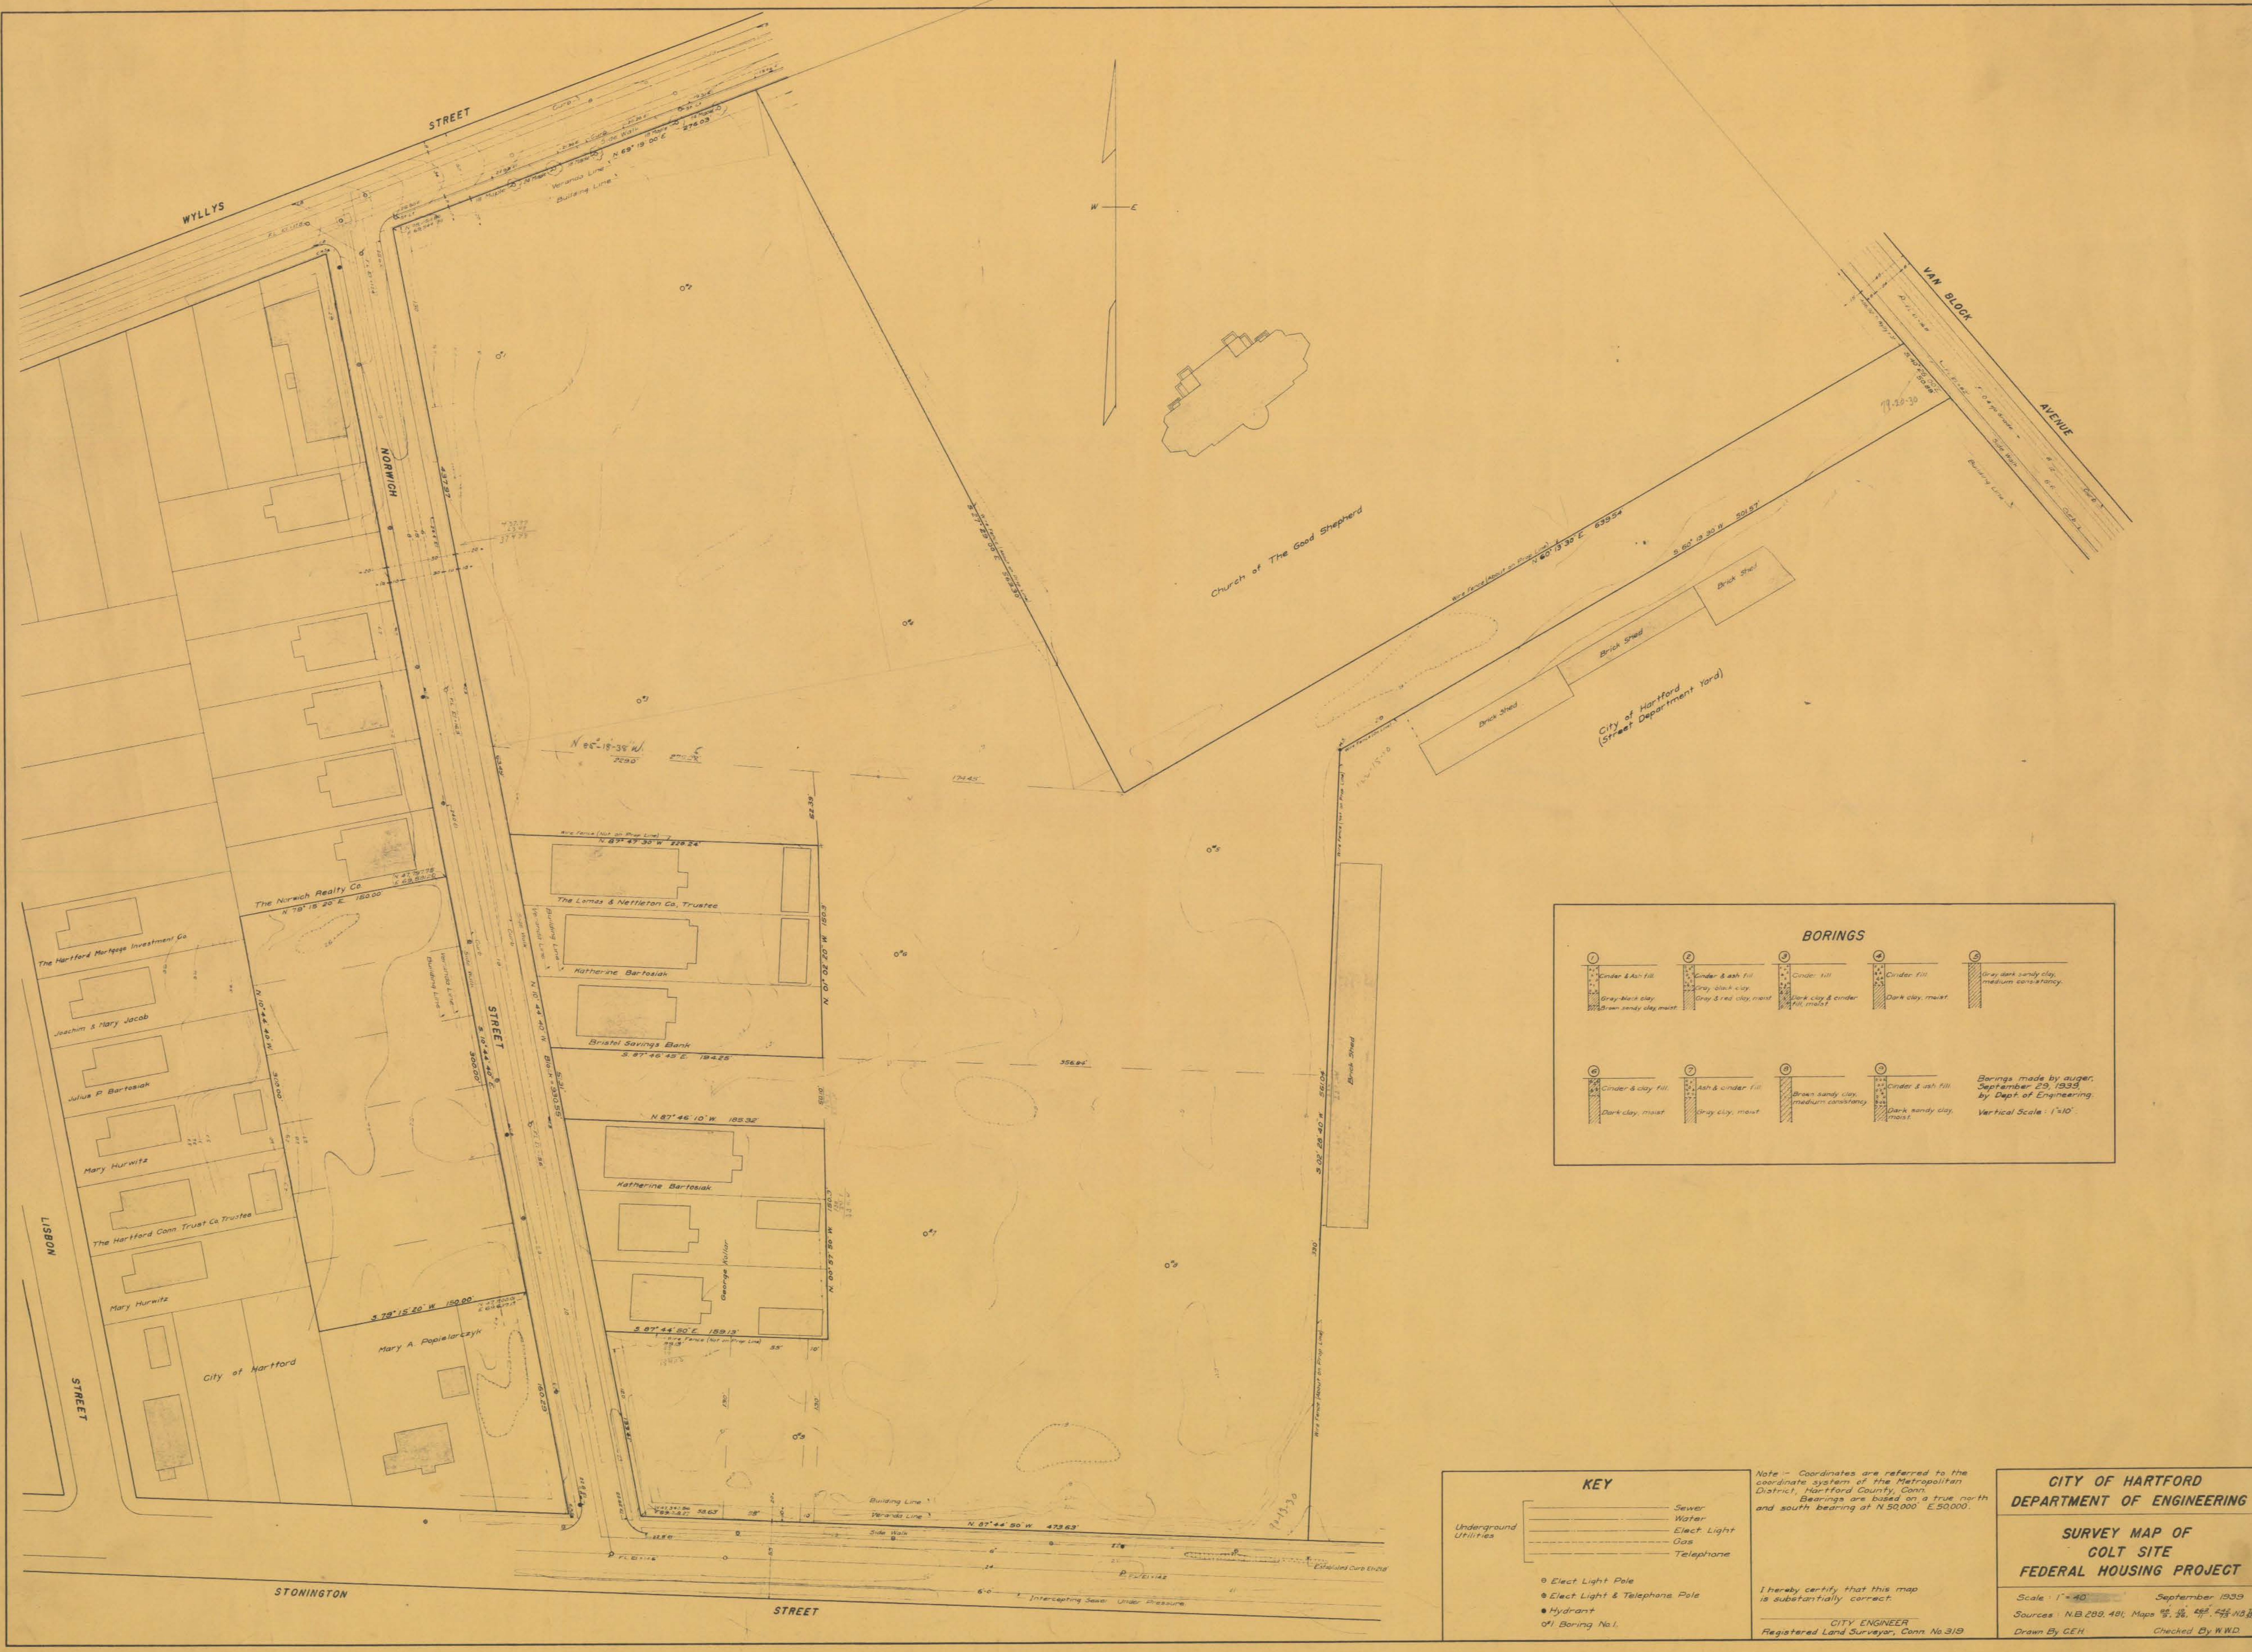

BORINGS

1	2	3	4	5
Cinder & ash fill Gray-black clay Brown sandy clay, moist	Cinder & ash fill Gray-black clay Gray & red clay, moist	Cinder fill Dark clay & cinder fill, moist	Cinder fill Dark clay, moist	Gray dark sandy clay, medium consistency
6	7	8	9	
Cinder & clay fill Dark clay, moist	Ash & cinder fill Gray clay, moist	Brown sandy clay, medium consistency	Cinder & ash fill Dark sandy clay, moist	

Borings made by auger, September 25, 1939, by Dept. of Engineering.
Vertical Scale: 1"=10'

KEY

Underground Utilities

- Sewer
- Water
- Elect. Light
- Gas
- Telephone

Elect. Light Pole
Elect. Light & Telephone Pole
Hydrant
Boring No. 1

Note - Coordinates are referred to the coordinate system of the Metropolitan District, Hartford County, Conn. Bearings are based on a true north and south bearing at N. 50,000 E. 50,000.

I hereby certify that this map is substantially correct.

CITY ENGINEER
Registered Land Surveyor, Conn. No. 319

**CITY OF HARTFORD
DEPARTMENT OF ENGINEERING**

**SURVEY MAP OF
COLT SITE
FEDERAL HOUSING PROJECT**

Scale: 1"=40' September 1939
Sources: N.B. 209, 481, Maps 15, 26, 48, 49, 50,100
Drawn By: C.E.H. Checked By: W.W.D.