
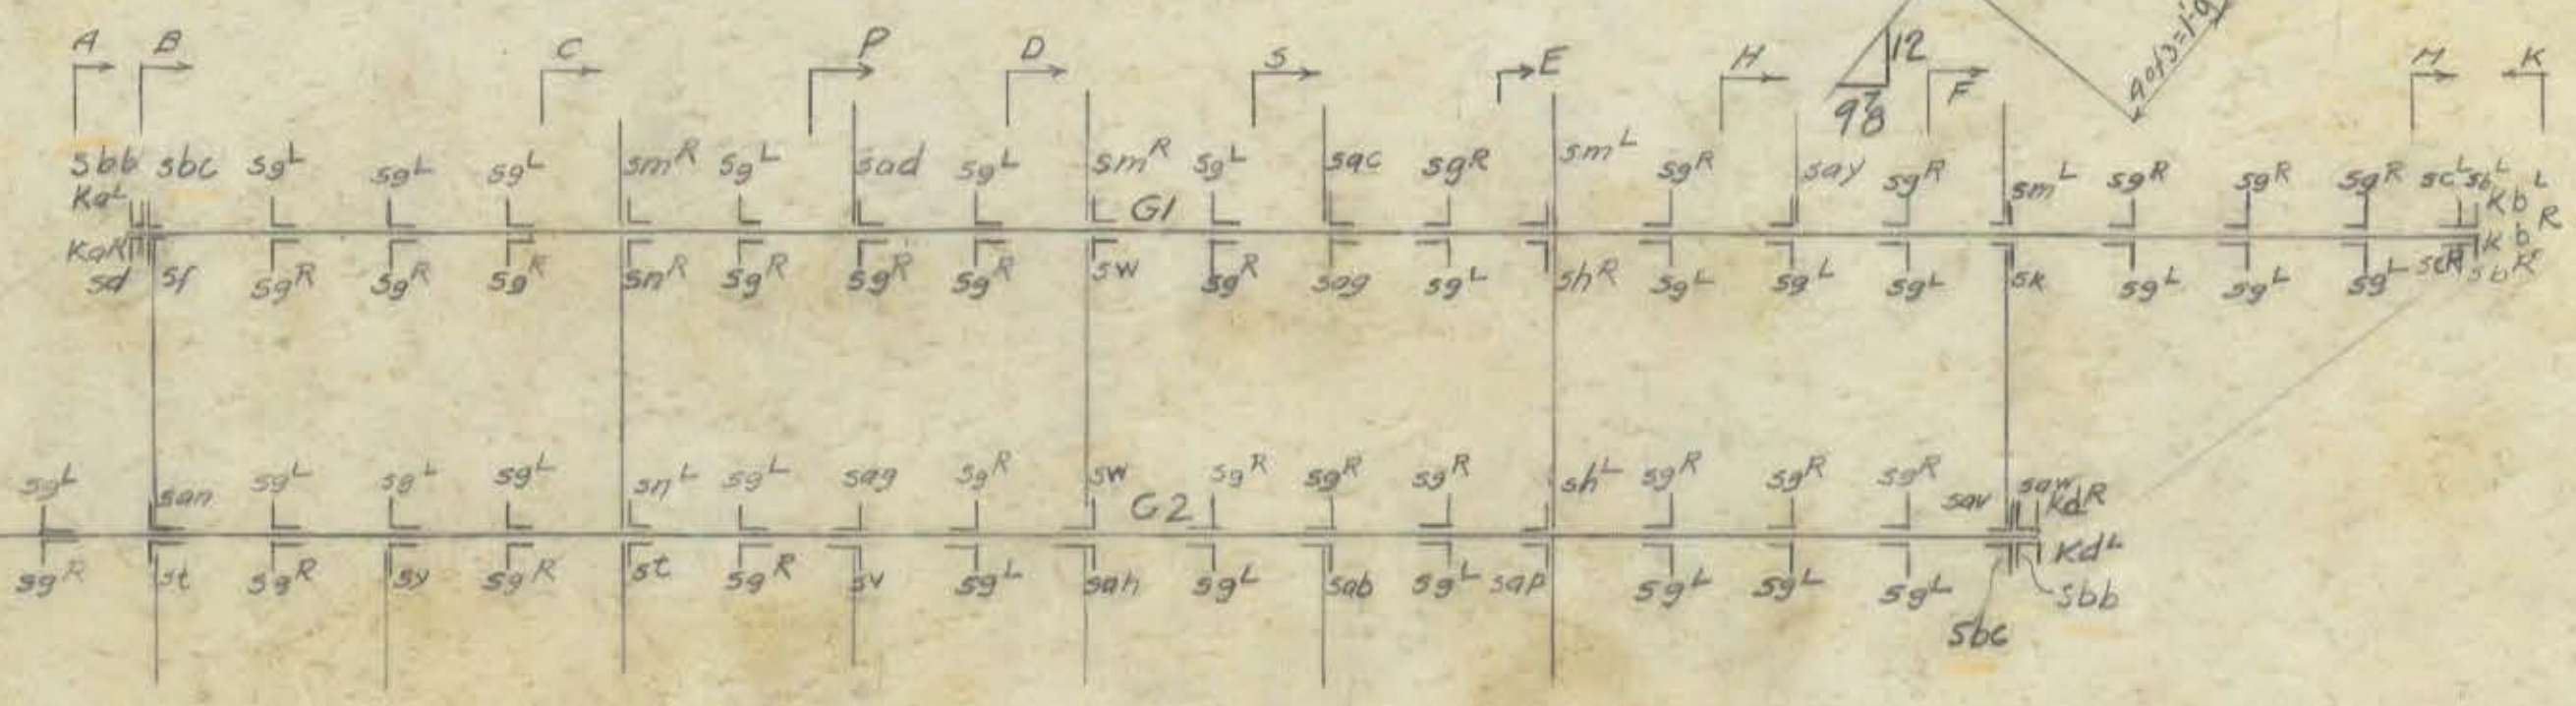
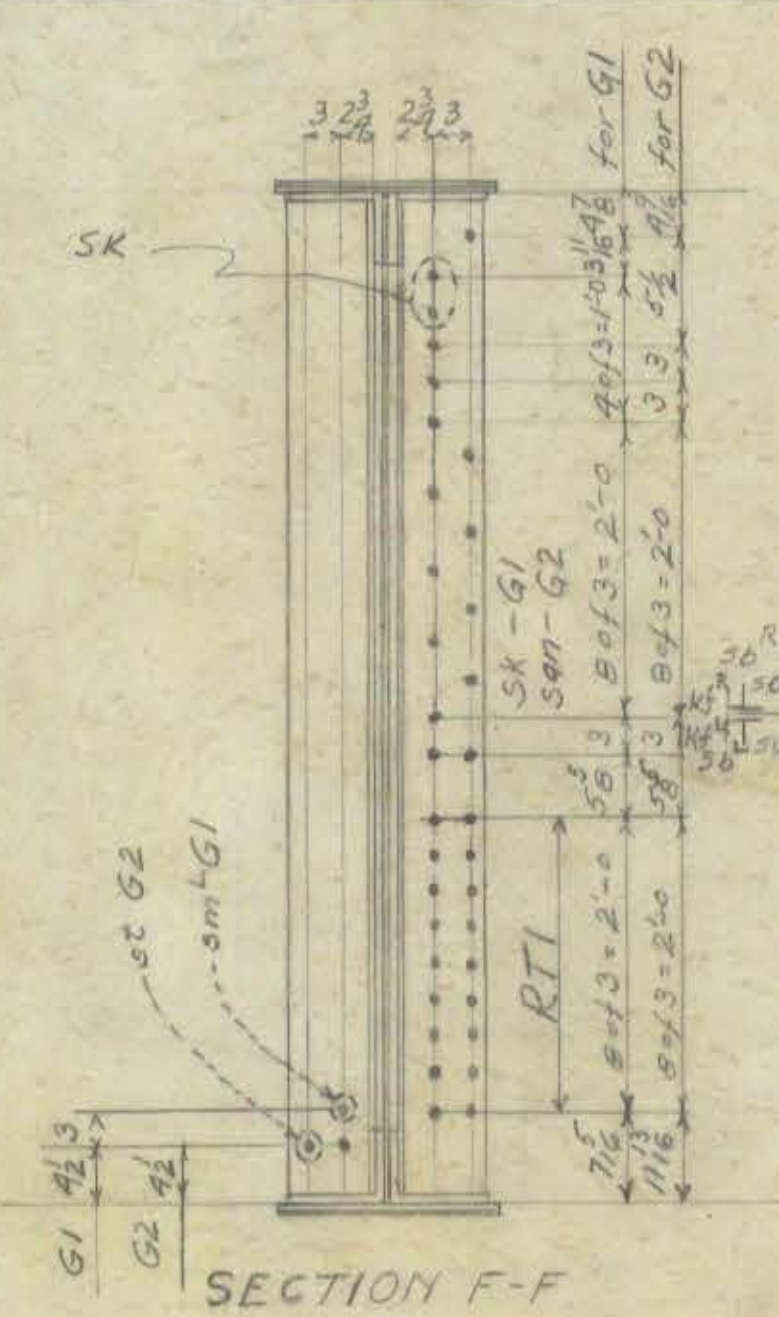
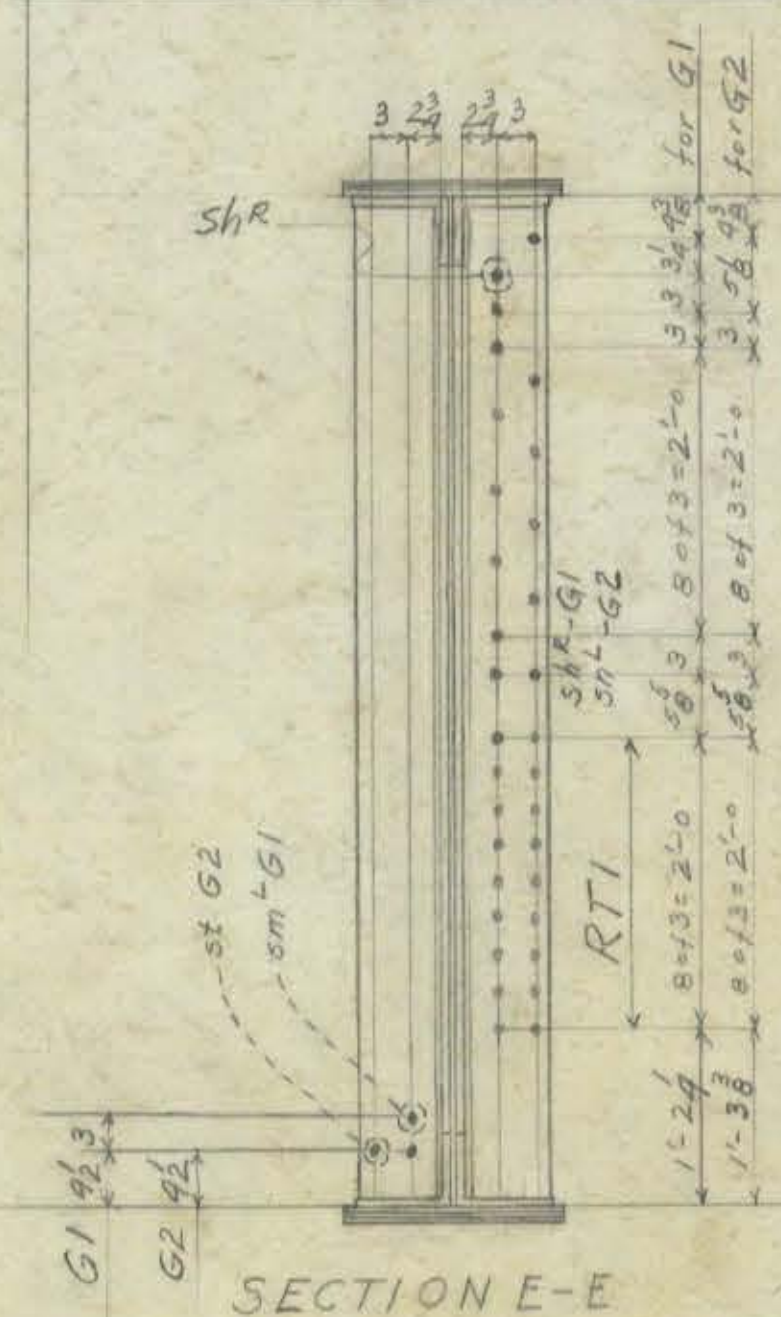


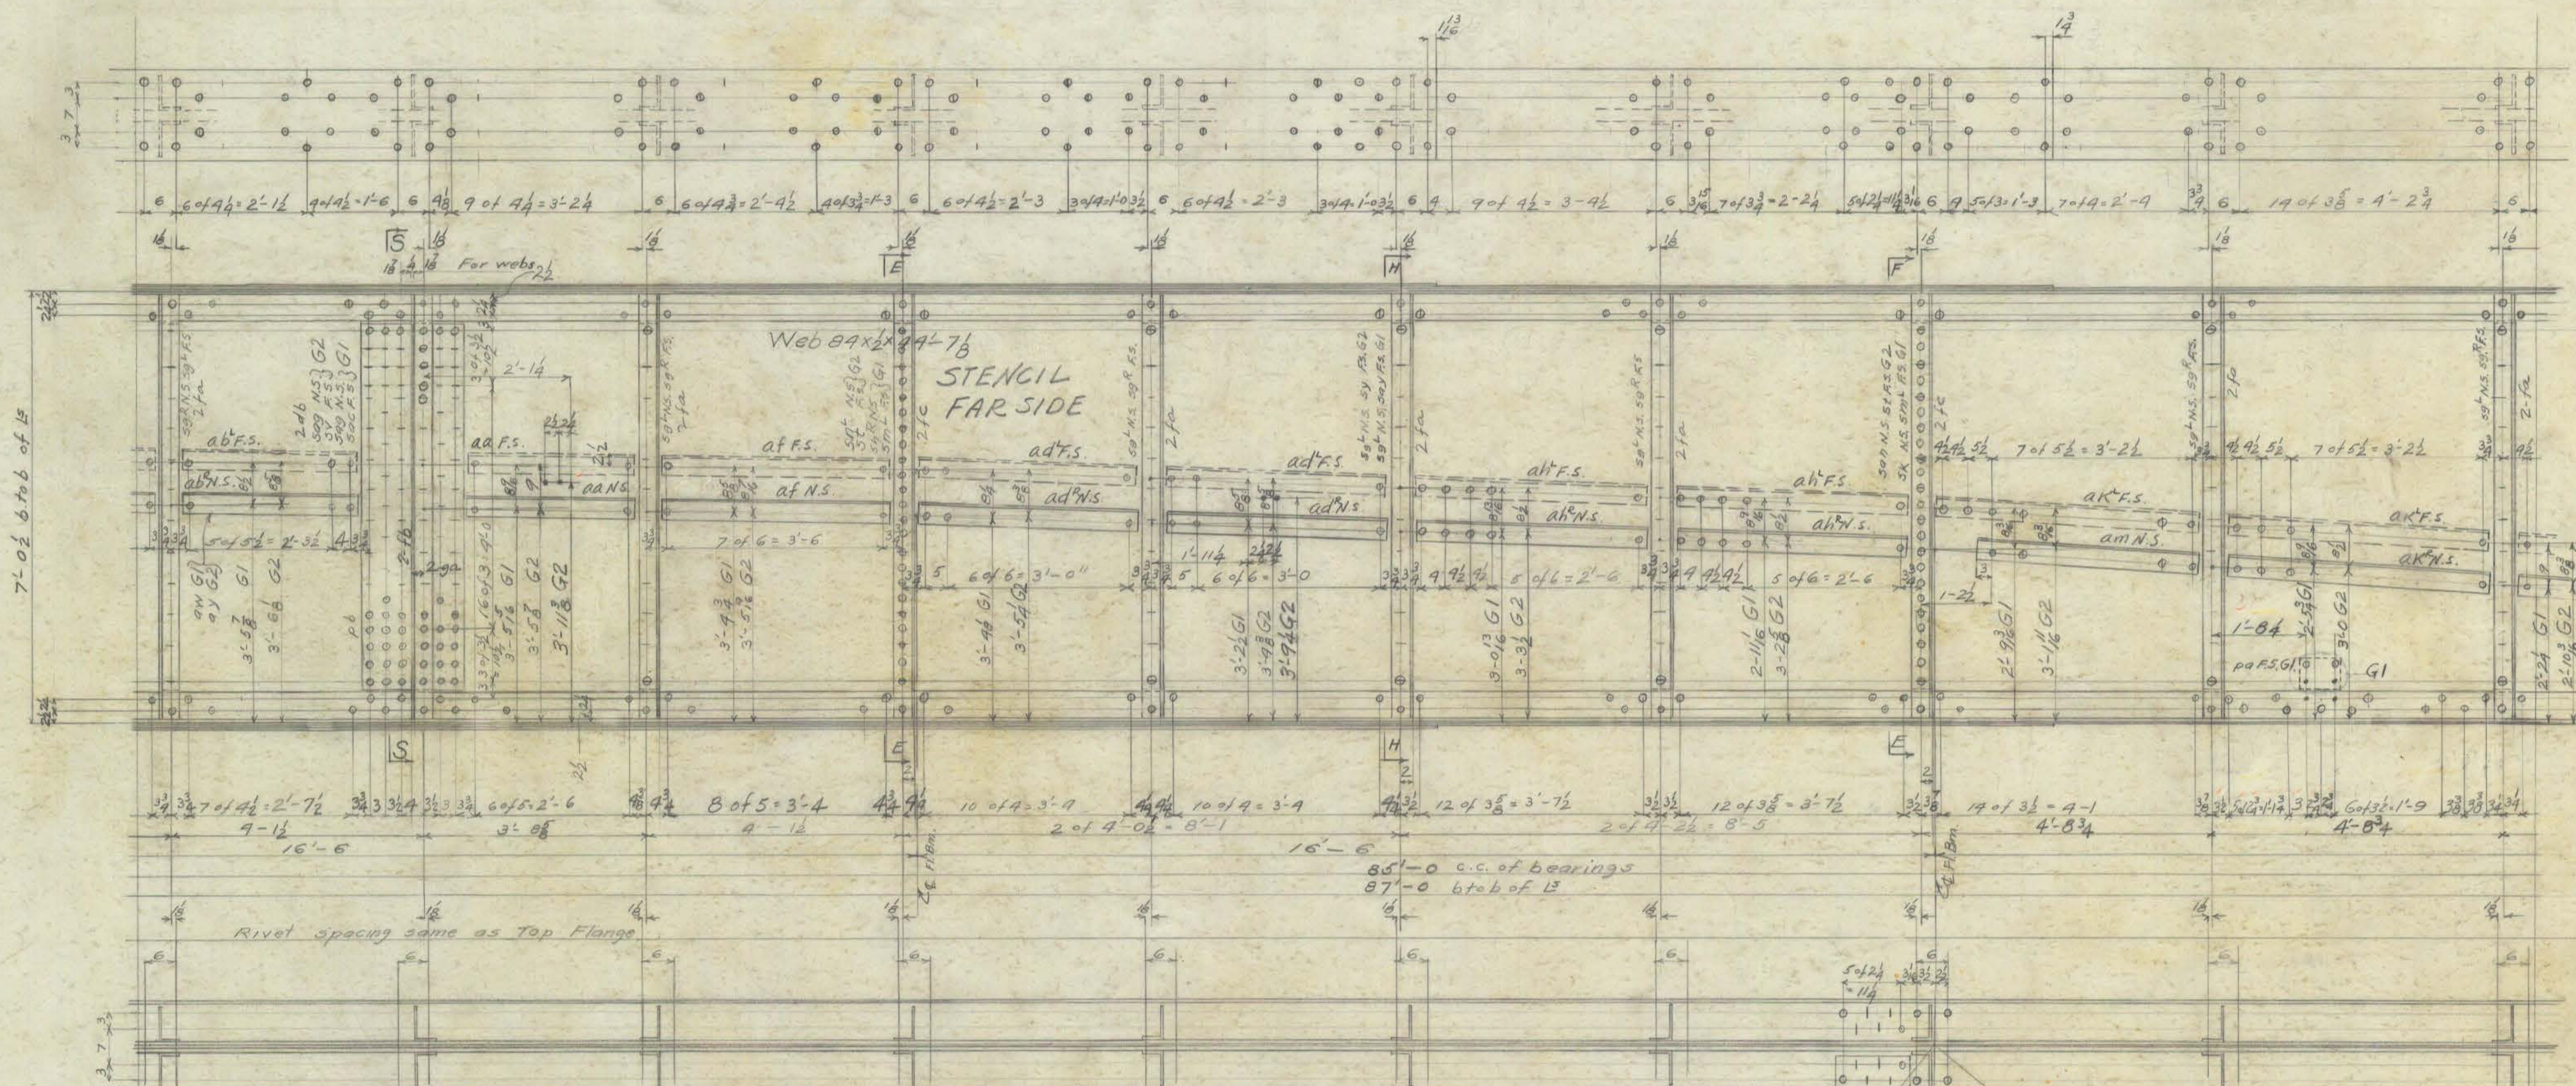

Rev. 10-18-41
Sbb changed to sbc
Sbc " " sbc

STATE OF CONNECTICUT
COMMERCE ST. BRIDGE
OVER
PARK RIVER CONDUIT
HARTFORD CONN.
ROADWAY GIRDERS

RECEIVED
OCT 15 1942
DEPARTMENT OF
ENGINEERING

AMERICAN BRIDGE COMPANY
DRAWINGS MADE AT Elmira PLANT
WORK FABRICATED AT Elmira PLANT
IN CHARGE OF E.B. Maloney
DRAW. MADE BY C.M.P. DATE
DRAW. CHECKED BY W.C. DATE 2-14-41
ORDER No. 449199 SHEET No. 6 BC.

DEPARTMENT OF ENGINEERING
SCALE 1" = 10'-0"
DATE OCT 1942
NUMBER 02559 40959