


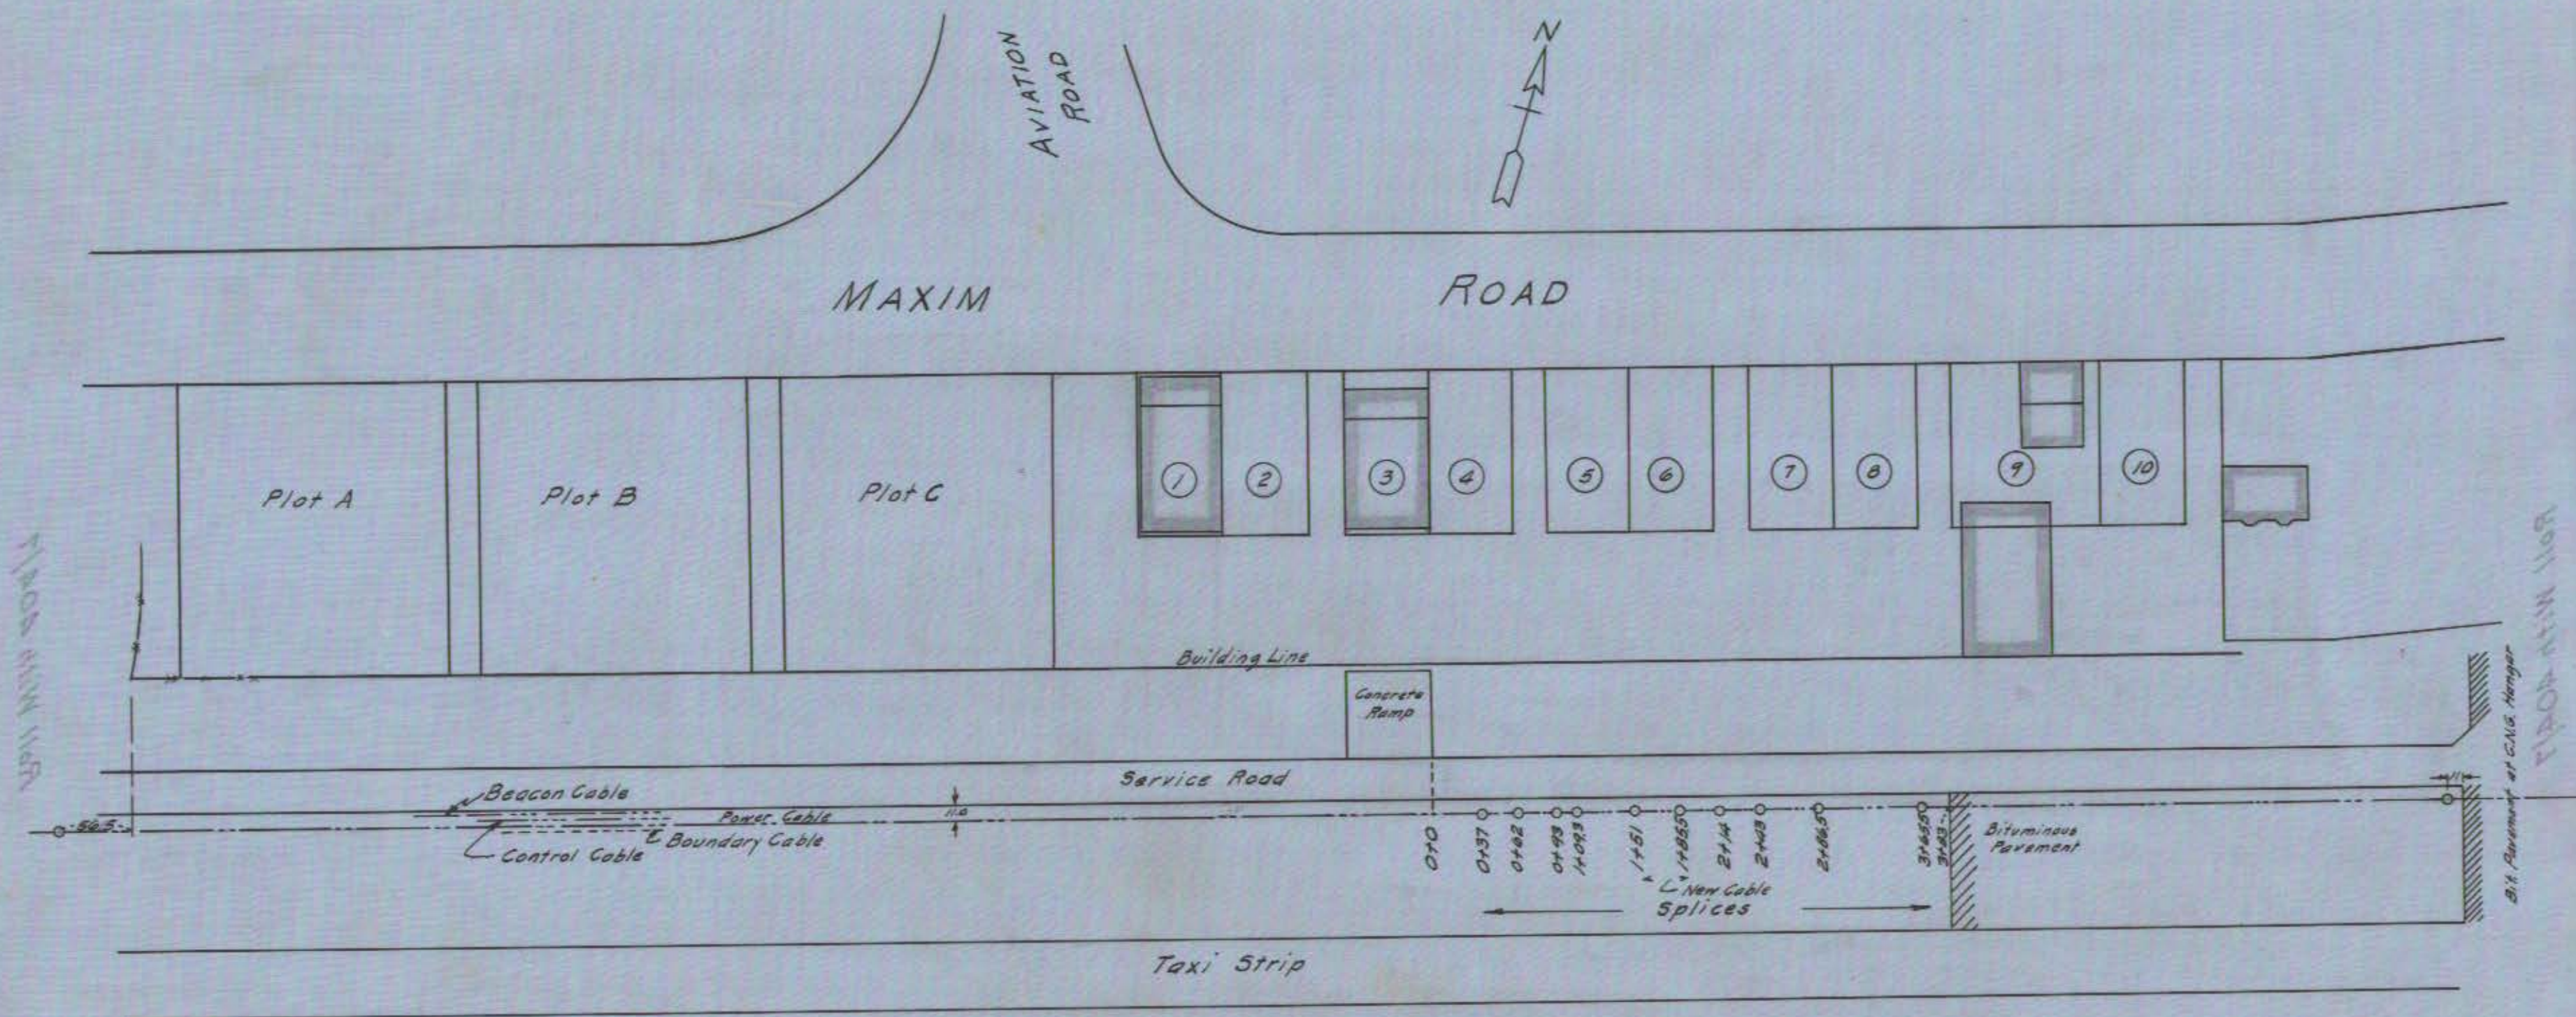

AVIATION FIELD
 DETAIL OF
 SPLICES IN POWER CABLE
 SCALE-1"=100' NOVEMBER 1950

CITY OF HARTFORD
 DEPARTMENT OF ENGINEERING