

TOWN OF WETHERSFIELD

BRAINARD ROAD

ROAD

See Detail Plan of This Area

AVIATION ROAD


MAXIM

AVIATION FIELD
LOCATION OF
UNDERGROUND CABLES
SCALE - 1"=200'

NOTES - 740 DAYBOOK NO. 08441
MAY 1943

CITY OF HARTFORD
DEPARTMENT OF ENGINEERING

NOTE - This plan compiled from electrical plans of original installations drawn by W. J. Oates, and dated Sept. 28, 1939, from information furnished by Airport Manager, and from surveys. The location of underground cables, etc., is only approximately correct and therefore is not guaranteed.
(See Plans 547/9, 547/10, 539/4, 539/5)

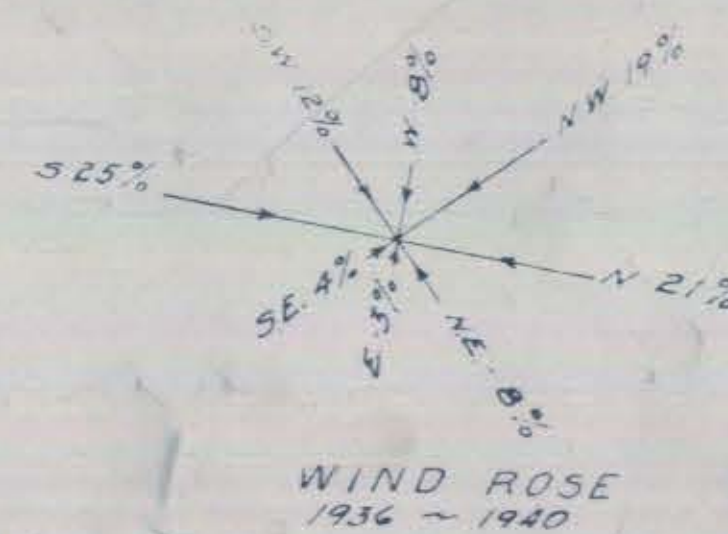

CONNECTICUT

CLARK

DIRE

RIVER

404
8

404
8