




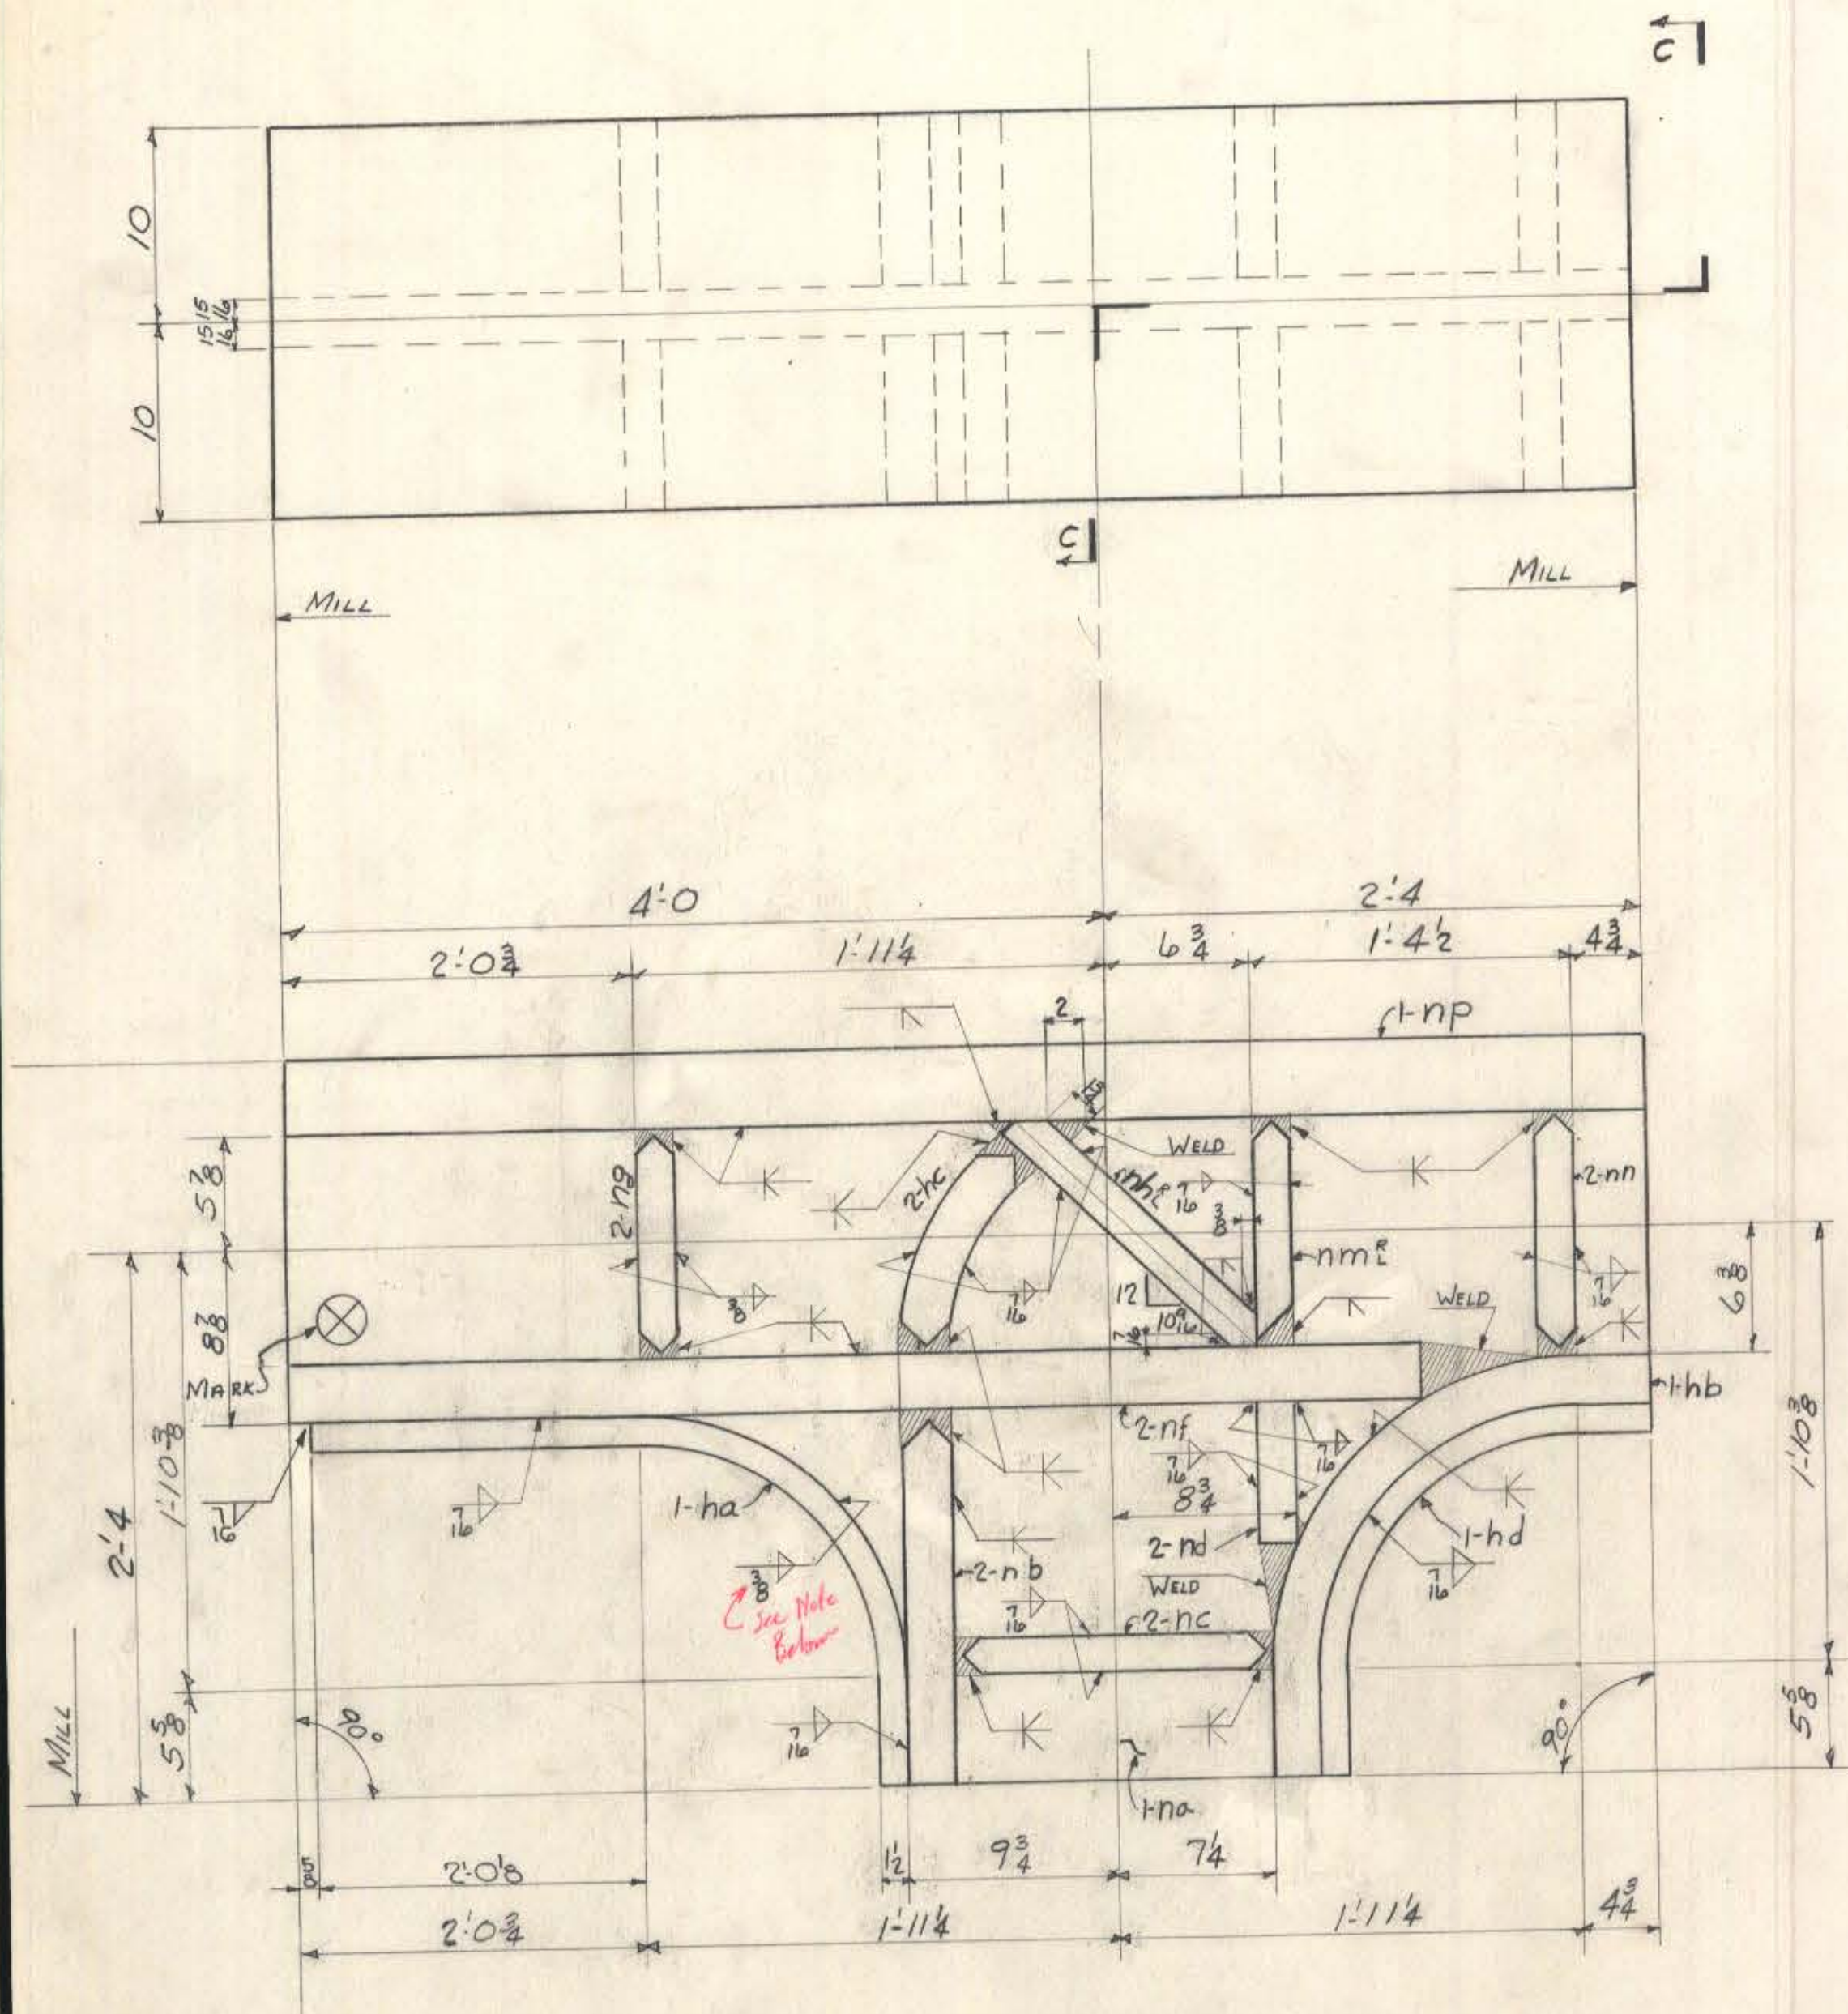


8 JOINTS - Mk B1-3; C1-3; B2-3; C2-3 (2 EACH)

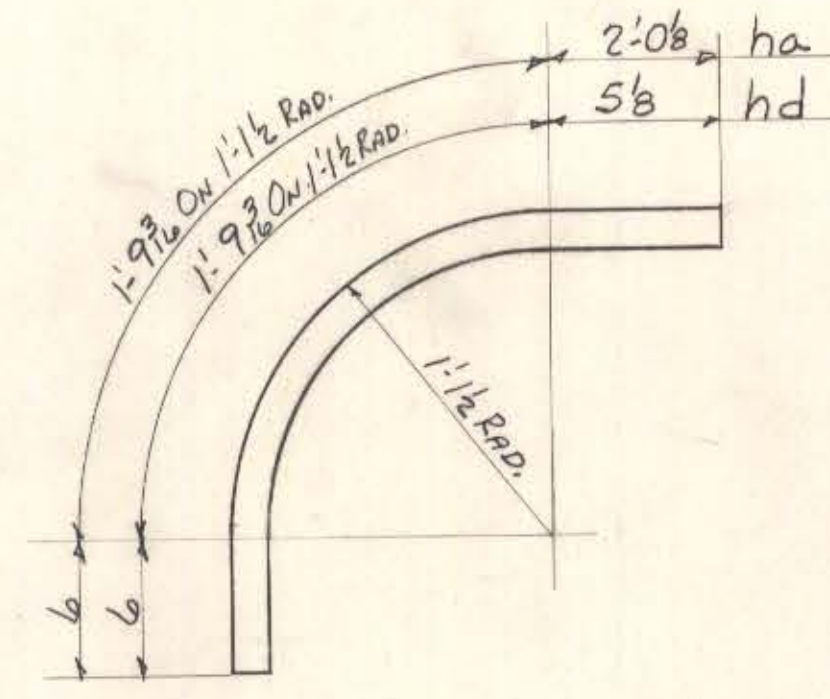


8 PLATES Mk. ha
8 PLATES Mk. hd

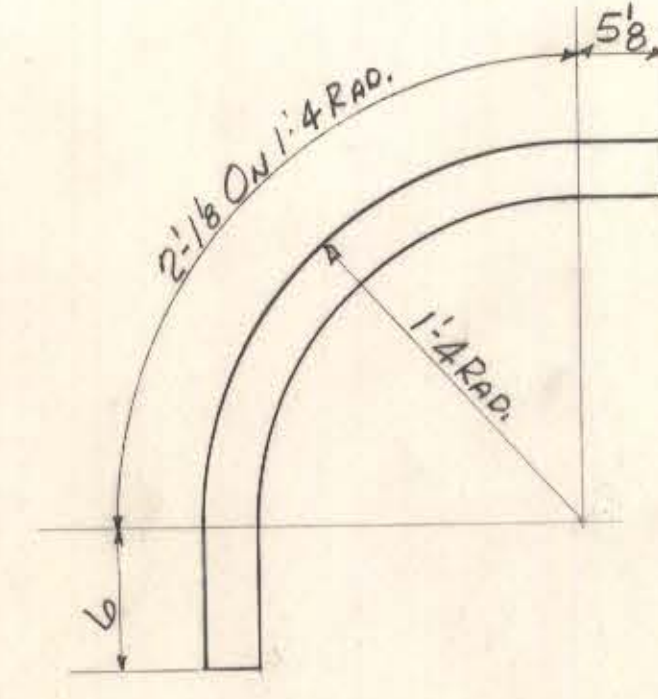


8 PLATES Mk. hb

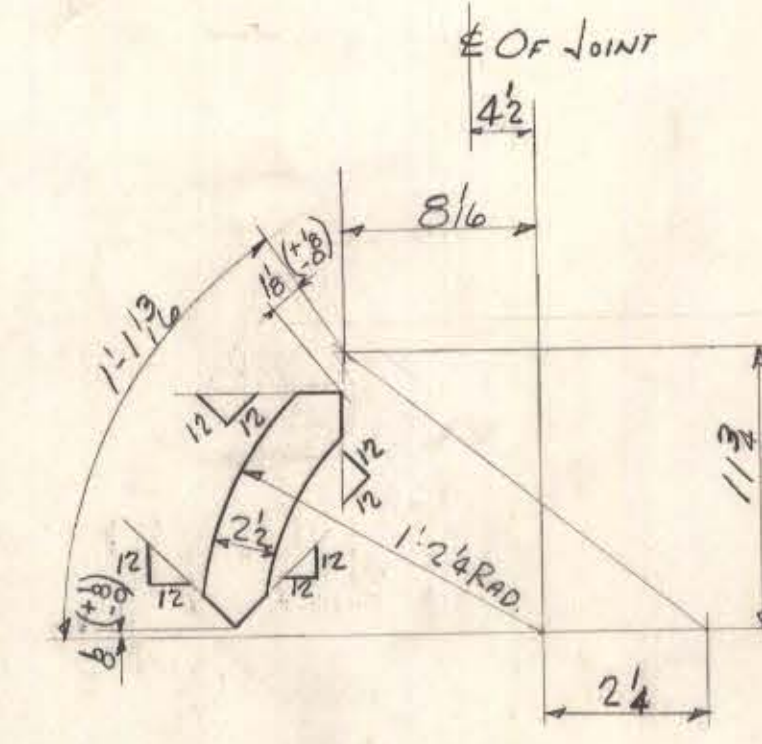


16 PLATES Mk. hc

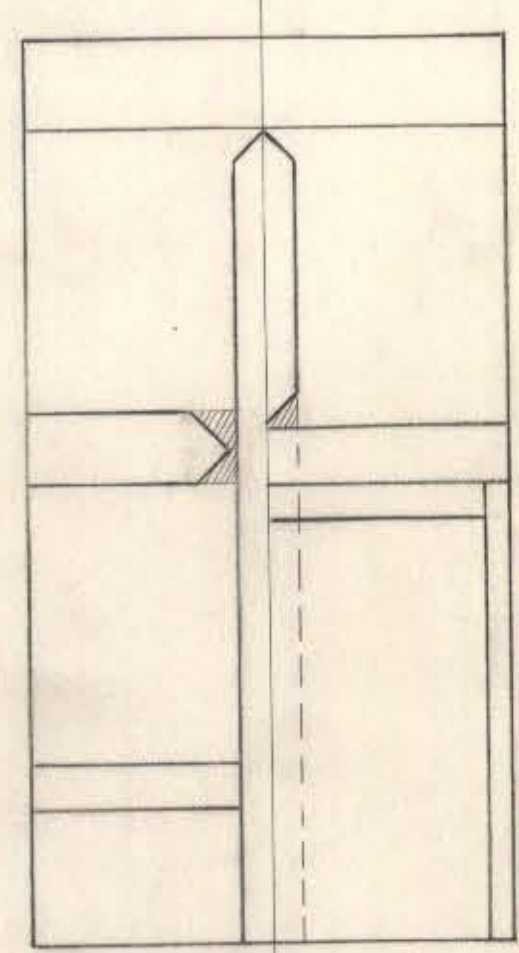


SECTION C-C

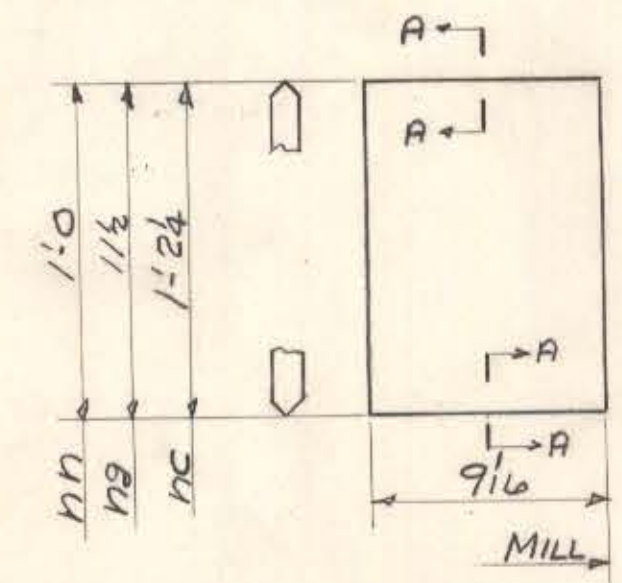


16 PLATES Mk. nc
16 PLATES Mk. ng
16 PLATES Mk. nn

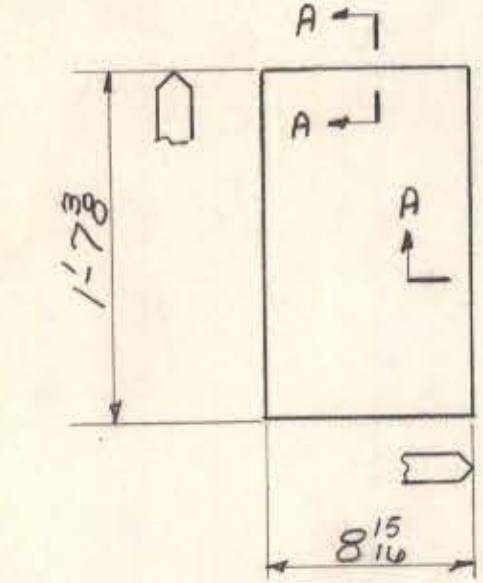


16 PLATES Mk. nb

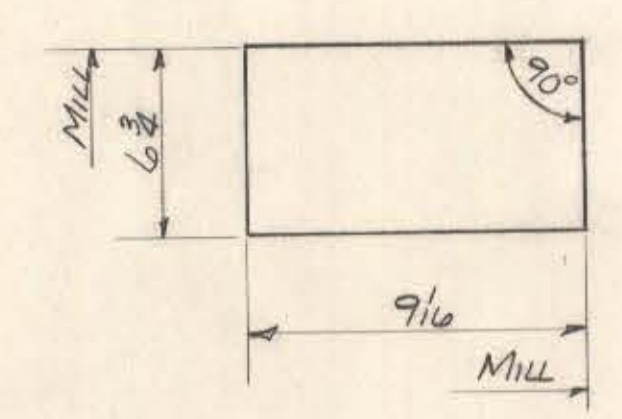


16 PLATES Mk. nd

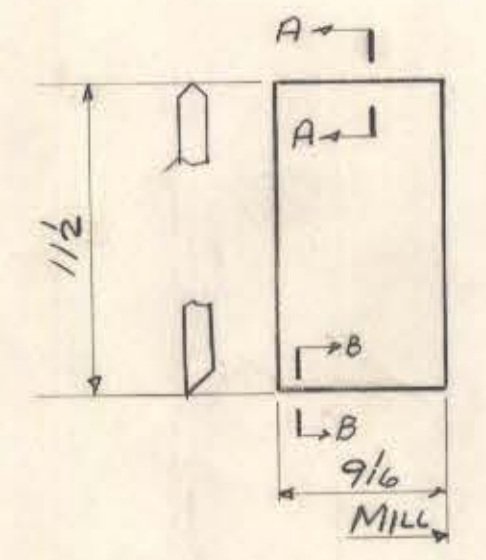


16 PLATES Mk. nm

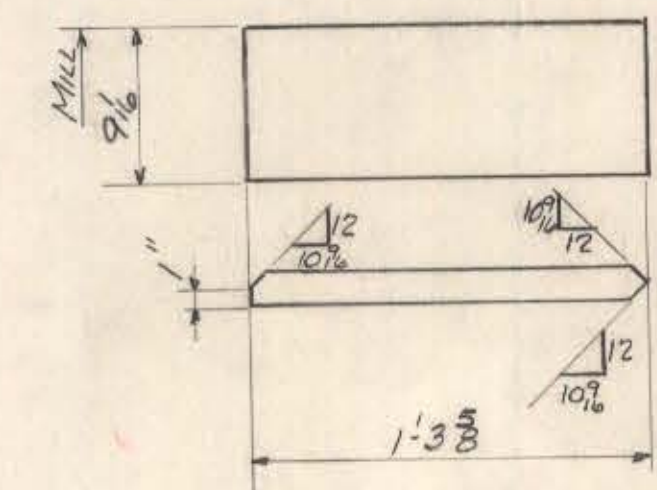


16 PLATES Mk. nh

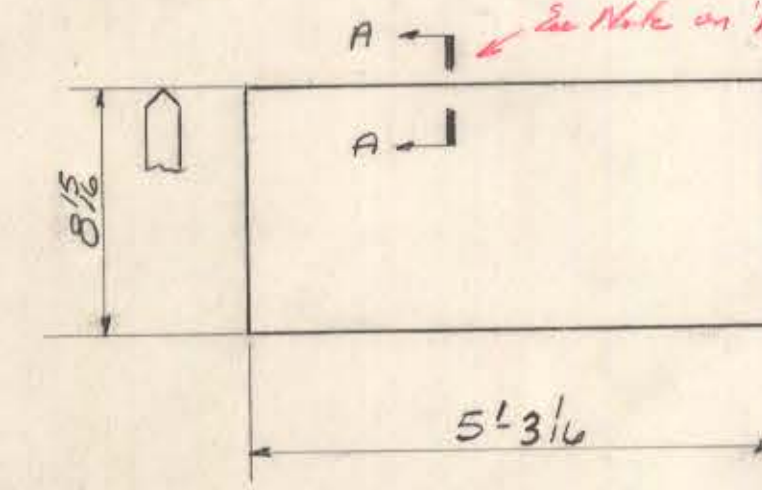


16 PLATES Mk. nf

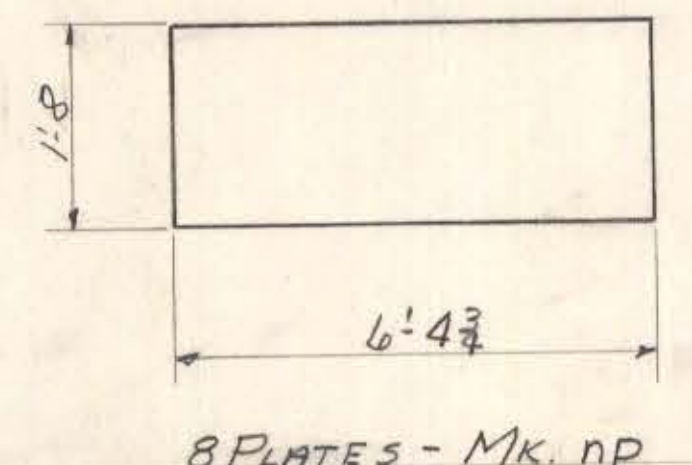


8 PLATES - Mk. np

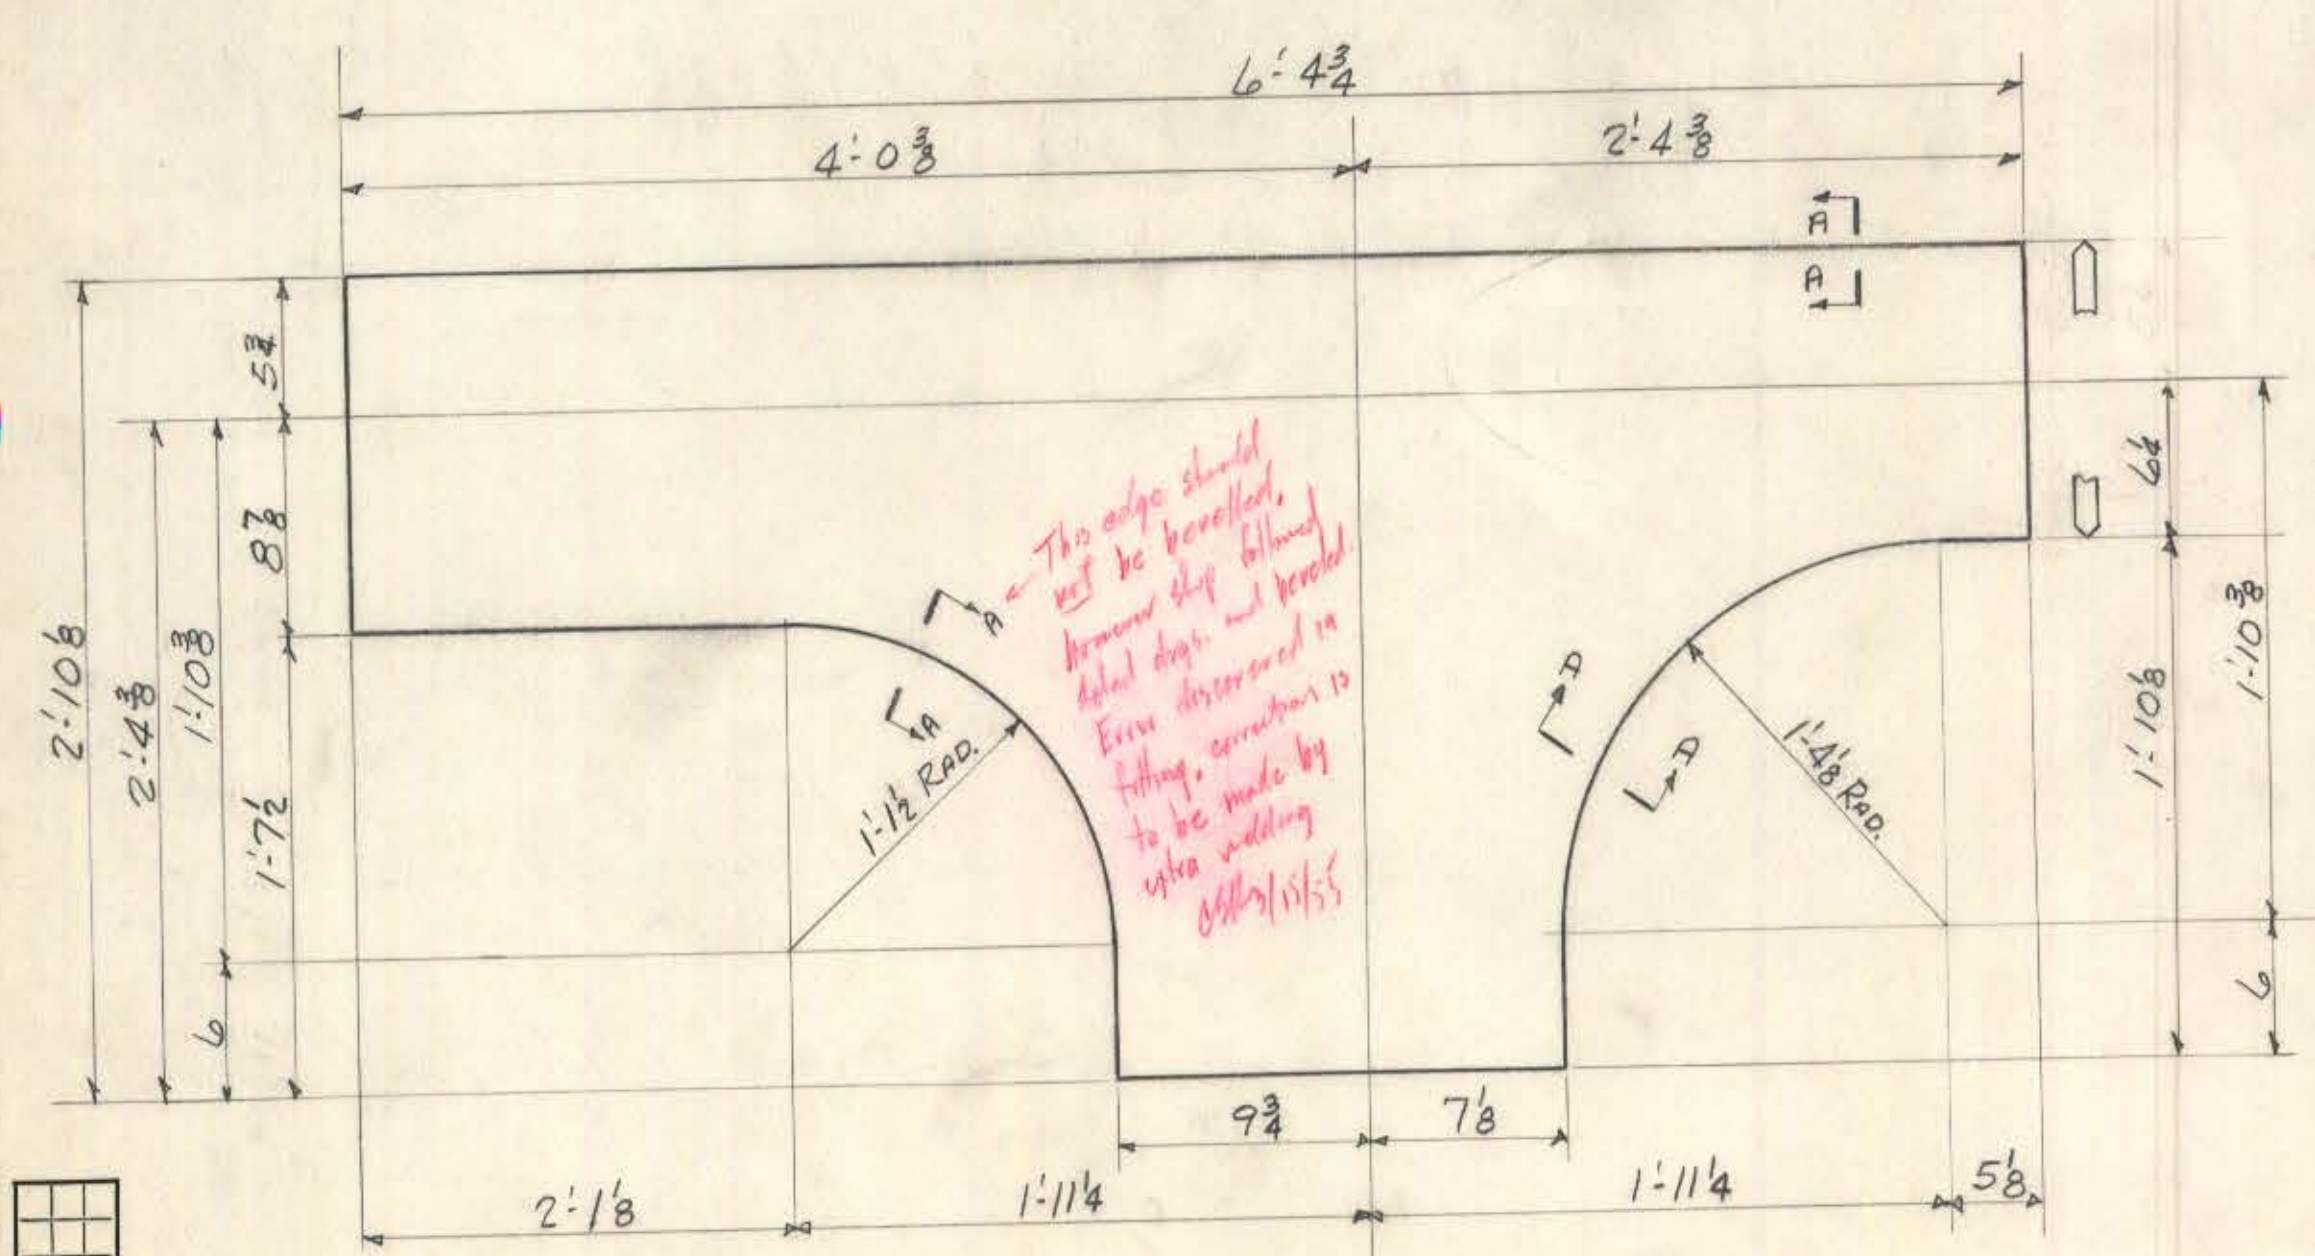


8 PLATES Mk. na

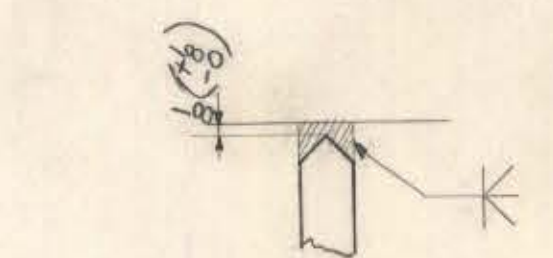


TYPICAL SECTION FOR
DOUBLE BEVEL BUTT WELD

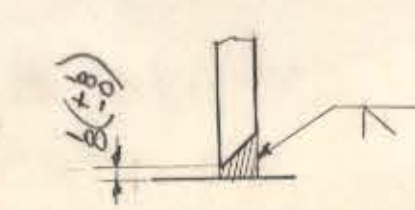

TYPICAL SECTION FOR
SINGLE BEVEL BUTT WELD

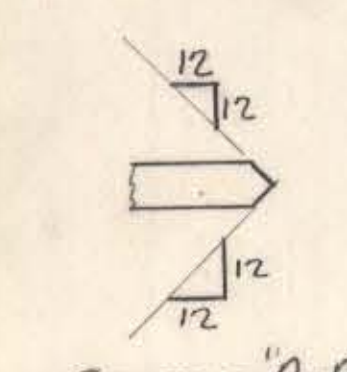

SECTION A-A

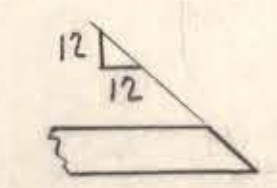

SECTION B-B

REVISIONS:
OPEN HOLES:

WEIGHT	NO. PCS.	ASS'M MK.	SHAPE	LENGTH	REMARKS	ORDERED
8 JOINTS - Mk B1-3; C1-3; B2-3; C2-3 (2 EACH)						
3244	8	ha	R. 18 x 1 1/2	4 3/8	R. 12-FD1	Ord.
4160	8	hb	R. 20 x 2 1/2	3 0/4	R. 14-FD1	Ord.
1049	16	hc	R. 9 1/2 x 2	1 0/16	R. 33-FD2	Ord.
2007	8	hd	R. 18 x 1 1/2	2 8/8	R. 13-FD1	Ord.
8727	8	na	R. 34 1/2 x 1 3/8	6 4/8		ORD. 200 36 x 1 1/2 x 1 1/2
2035	16	nb	R. 8 1/2 x 2 1/2	1 7/8		ORD. 200 36 x 1 1/2 x 1 1/2
1189	16	nc	R. 9 1/2 x 2	1 2/4	M. EDGE	ORD. 200 36 x 1 1/2 x 1 1/2
559	16	nd	R. 9 1/2 x 2	0 6/8	M. EDGES	ORD. 200 36 x 1 1/2 x 1 1/2
775	16	nf	R. 8 1/2 x 3	5 3/4		ORD. 200 36 x 1 1/2 x 1 1/2
759	16	ng	R. 9 1/2 x 2	0 11/2	M. EDGE	ORD. 200 36 x 1 1/2 x 1 1/2
1299	16	nh	R. 9 1/2 x 2	1 3/8	M. EDGE	ORD. 200 36 x 1 1/2 x 1 1/2
959	16	ni	R. 9 1/2 x 2	0 11/2	M. EDGE	ORD. 200 36 x 1 1/2 x 1 1/2
999	16	nn	R. 9 1/2 x 2	1 0	M. EDGE	ORD. 200 36 x 1 1/2 x 1 1/2
13164	8	np	R. 20 x 3 3/8	6 4/8		ORD. 200 36 x 1 1/2 x 1 1/2
243	PAINT					
48865	TOTAL					
TOTAL	ORD.	PLATES	STD.	BOLT	RIV.	PAINT
48865	48622					243

2-21-55 R. ha made 1" shorter (100b was 2 1/8") R.C.G.
DATE REVISION BY CHK'D

Lehigh Structural Steel Co.
ALLENTOWN, PA.
HARTFORD PUBLIC LIBRARY
HARTFORD, CONN
VIERENDEEL TRUSSES "B&C"

IN CHARGE OF CF DATE 11/2/54 CONTRACT NUMBER 4089
DRAWN BY ELG DATE 11/2/54 SHEET NUMBER 17
CHECKED BY FF DATE 11/18/54
SCALE