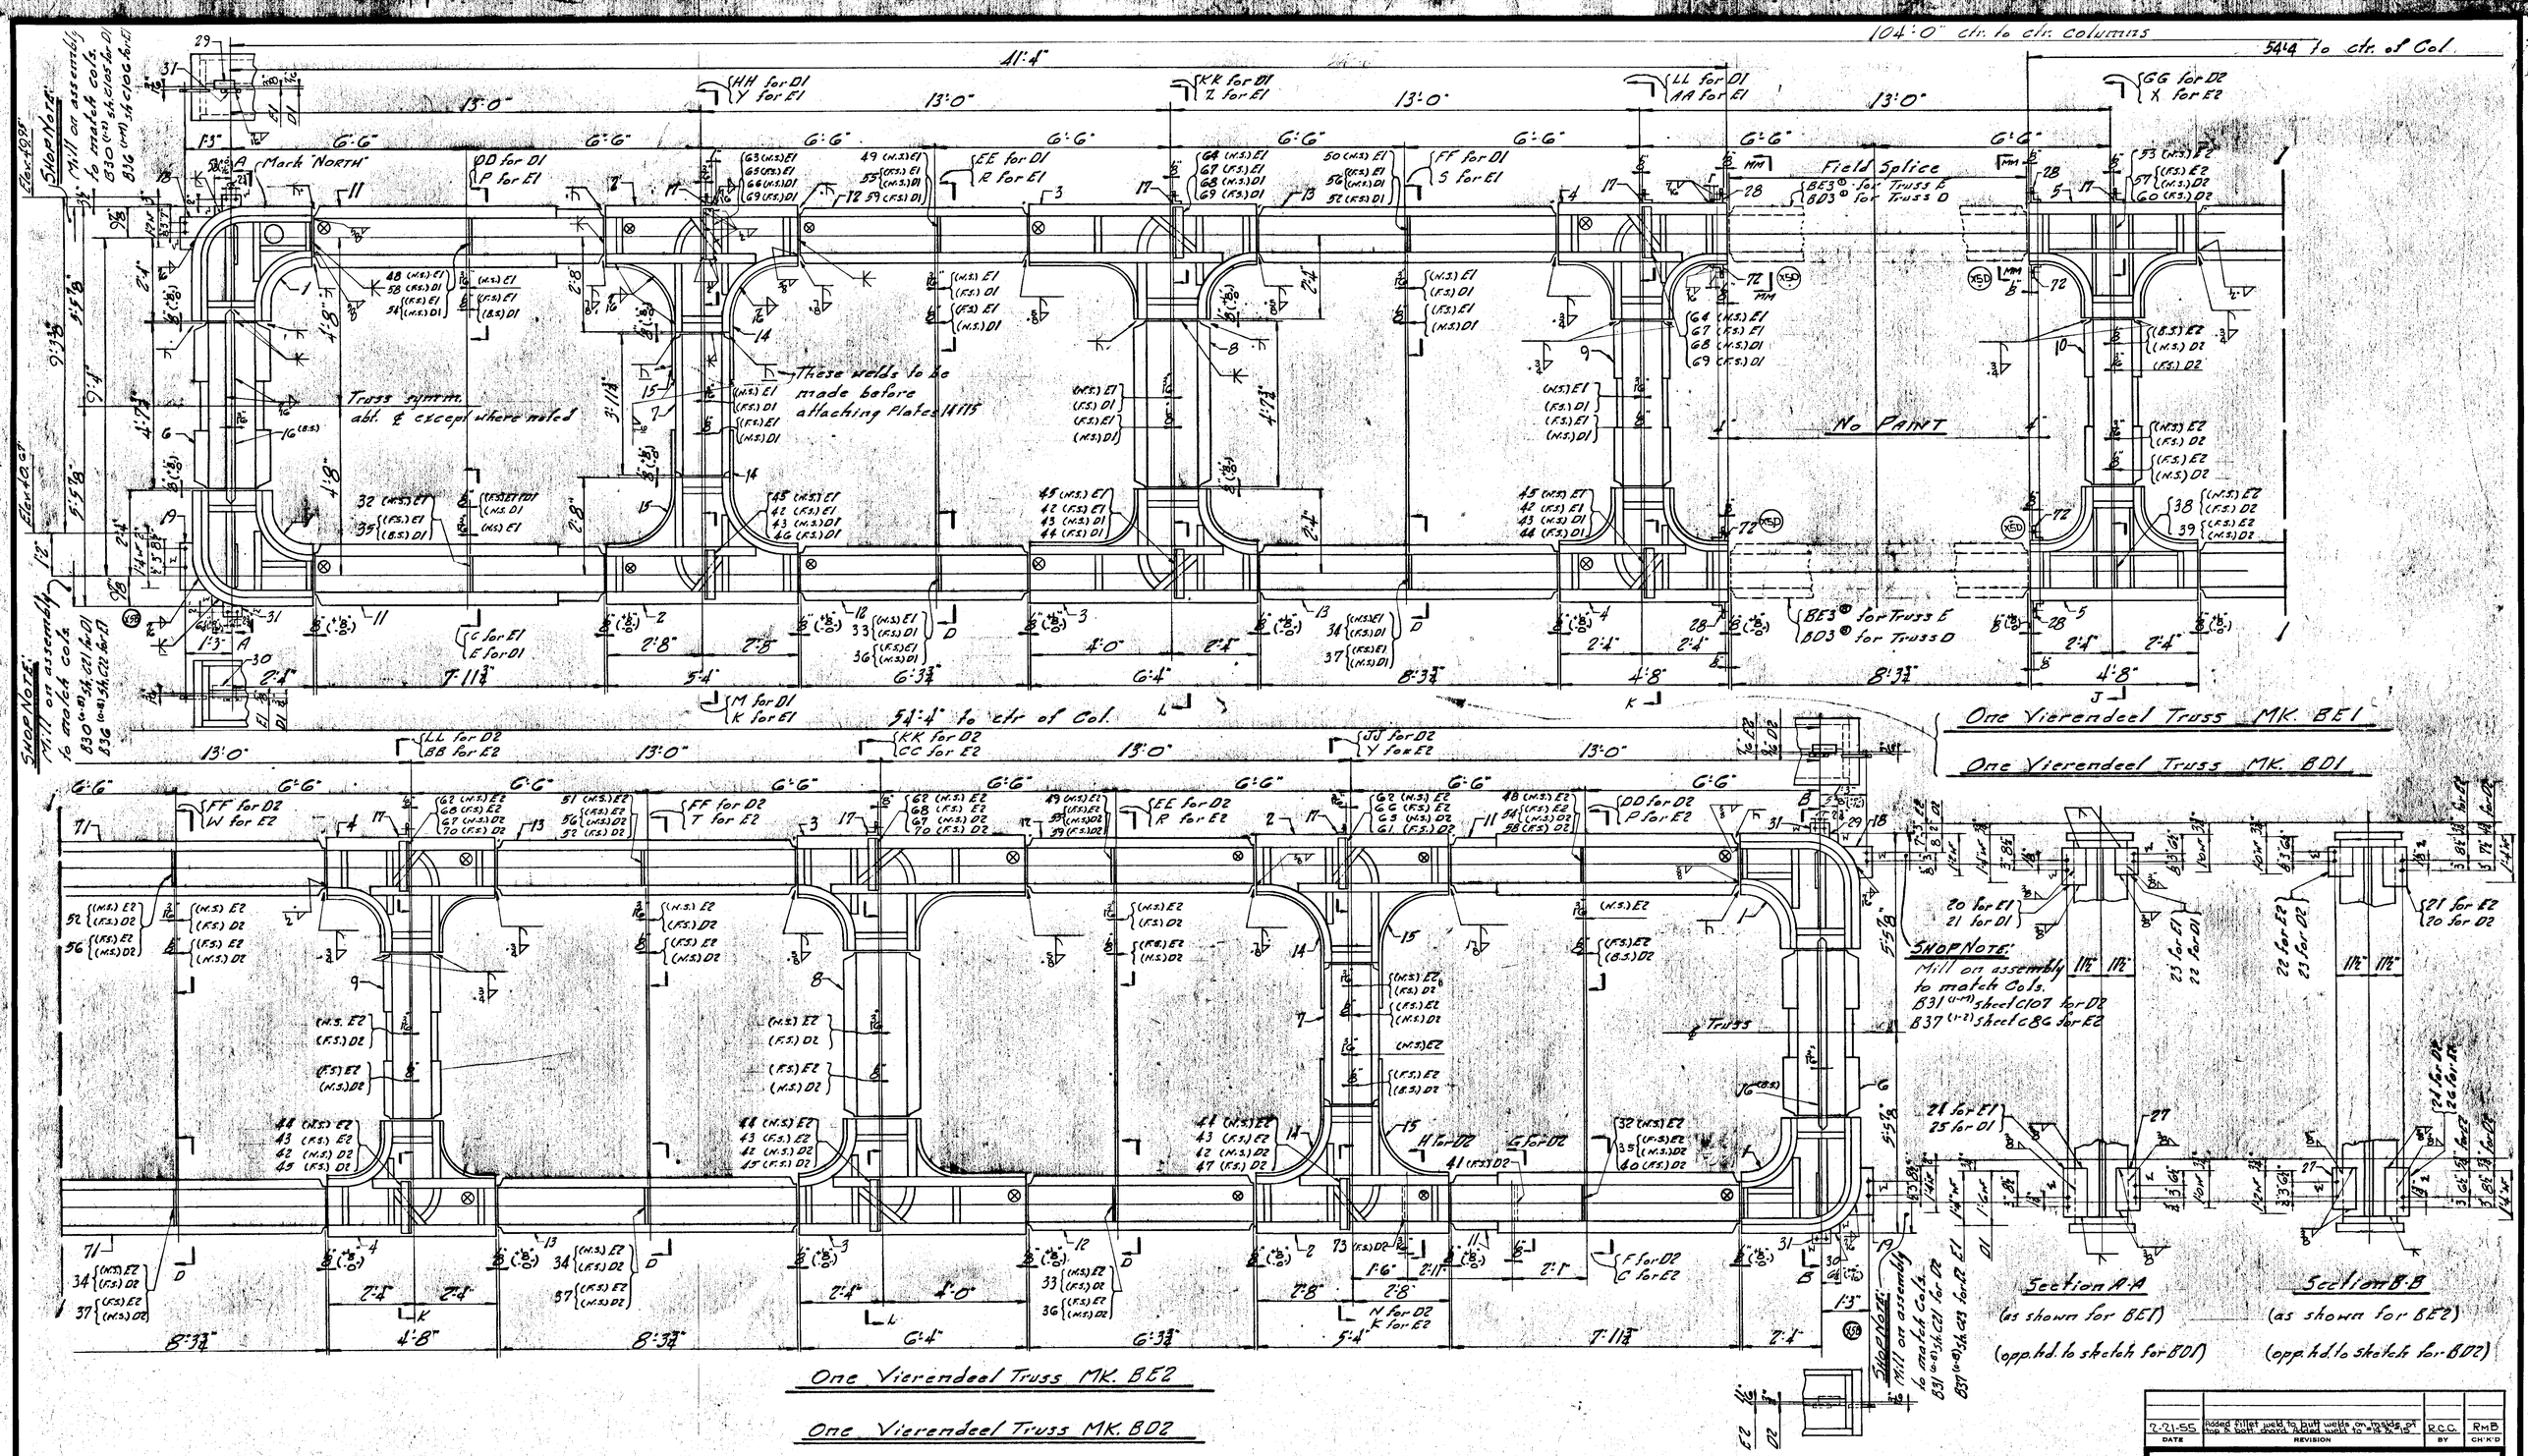

NOTE:
See sheet AD2 for Sections C-C to MM-MM.
For typical butt welds see sheet FD6

DATE	REVISION	BY	CH'K'D
2-21-55	Added fillet weld to butt welds on inside of top & bott. chord. Added weld to 18 & 19	RCC	RMB

Lehigh Structural Steel Co.
ALLENTOWN, PA.

HARTFORD PUBLIC LIBRARY
HARTFORD, CONN.
VIERENDEEL TRUSSES "D" & "E"

IN CHARGE OF CL	DATE	CONTRACT NUMBER 4082	
DRAWN BY CTD	DATE 12 Oct 54		
CHECKED BY RCC / R.E.	DATE 11-10-54	SHEET NUMBER AD1	
SCALE			