


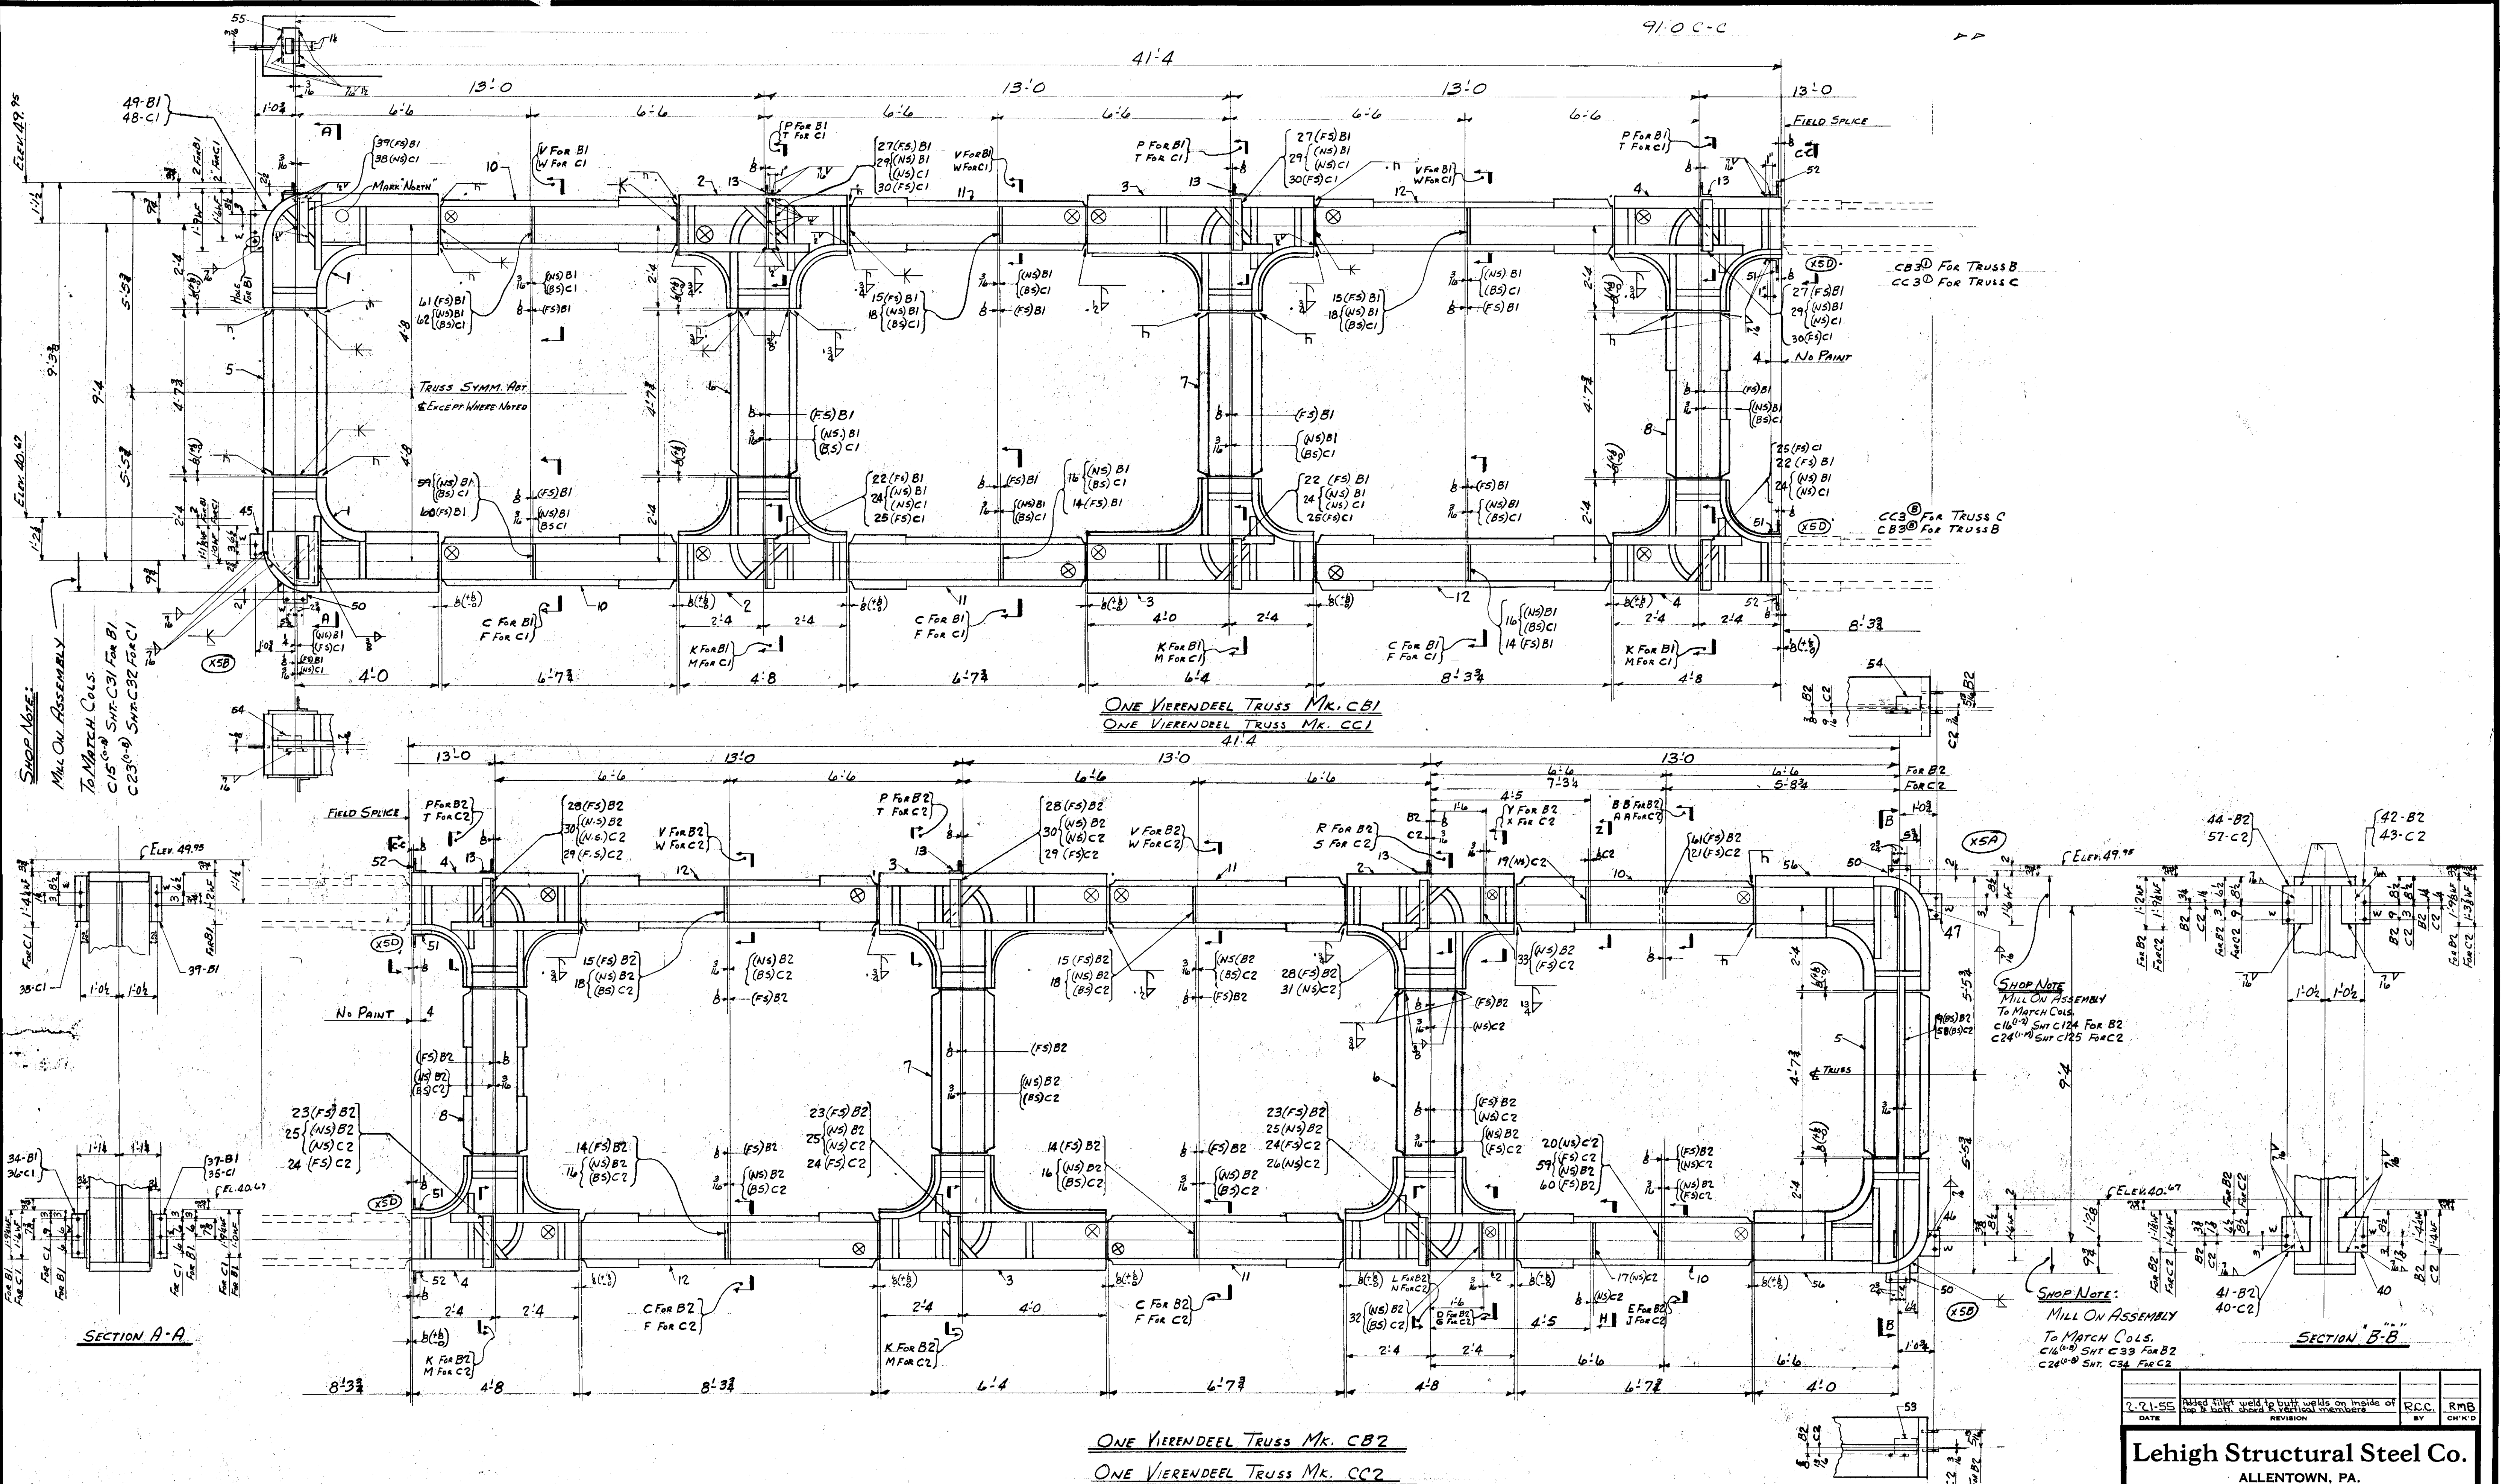

2-21-55	Added fillet weld to butt welds on inside of top & butt, check structural requirements	RECC	RMB
DATE	REVISION	BY	CHK'D
Lehigh Structural Steel Co. ALLENTOWN, PA. HARTFORD PUBLIC LIBRARY HARTFORD, CONN. VIERENDEEL TRUSSES "B" & "C"			
IN CHARGE OF	DATE	CONTRACT NUMBER	
DRAWN BY	DATE	40591	
CHECKED BY	DATE		
SCALE		SHEET NUMBER	HD3