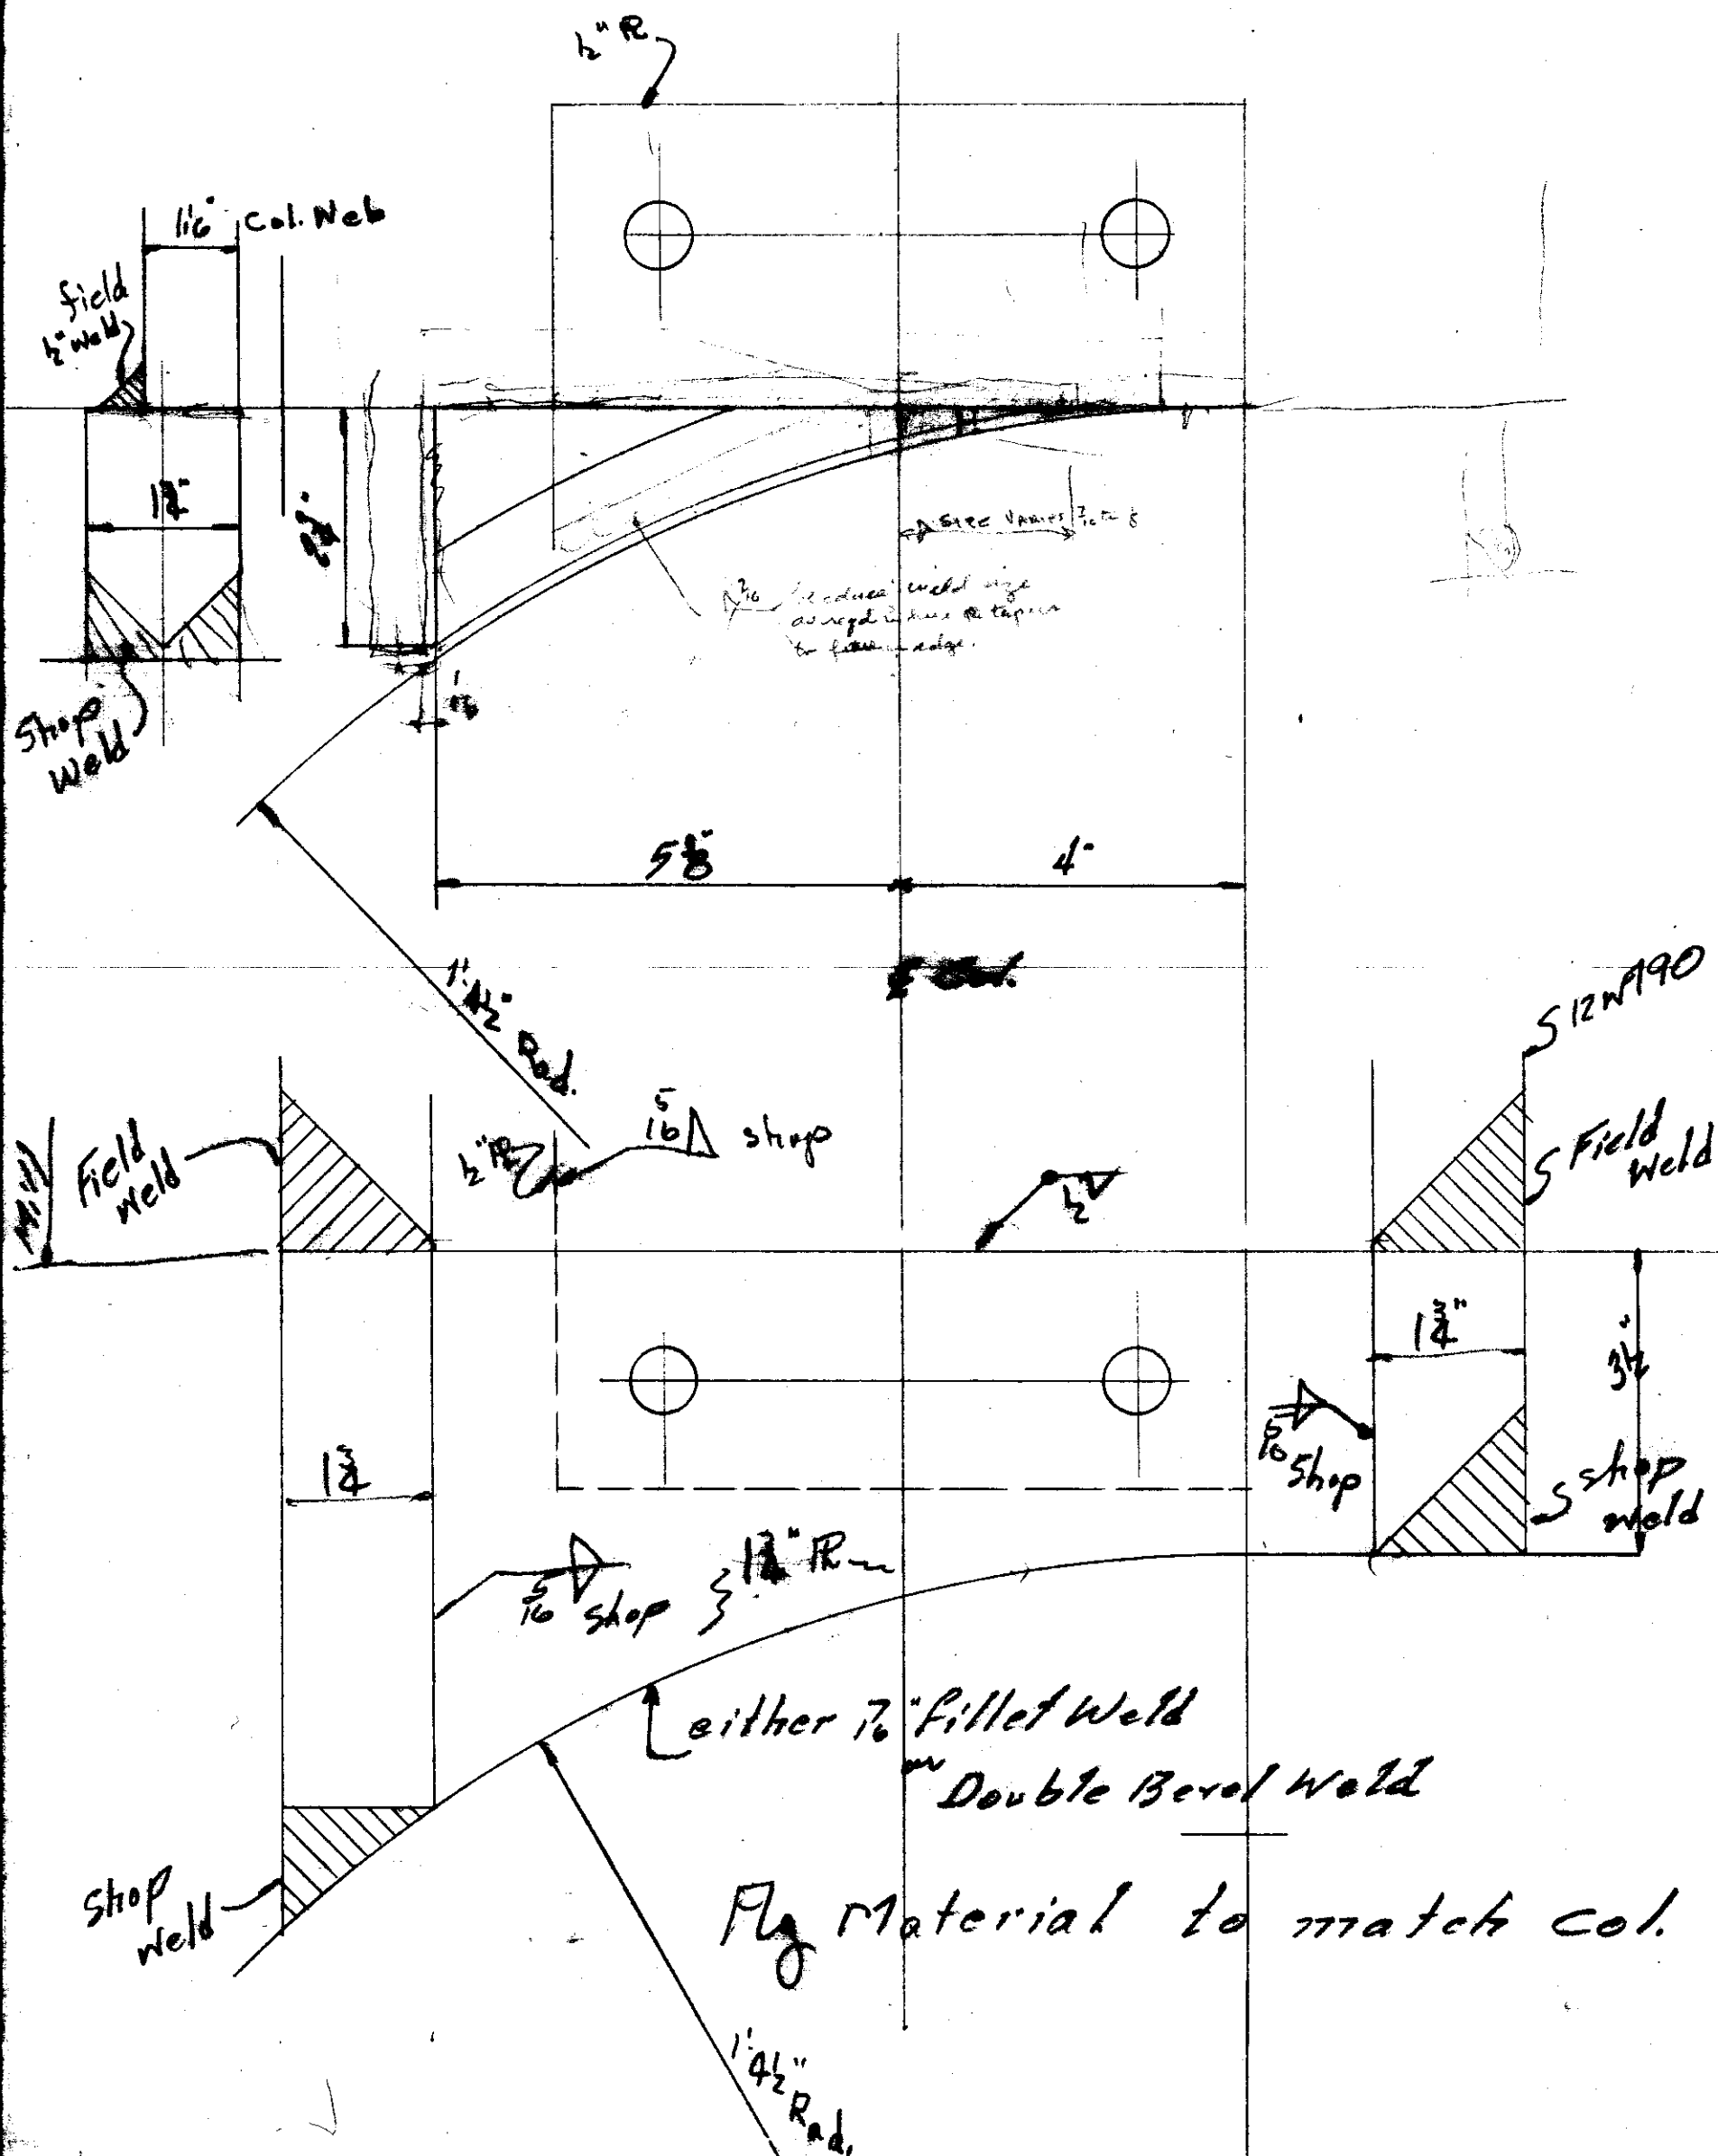


ALLENTOWN, PA.

WEIGHT

CONN.

REVIEWS

UNLESS NOTED

DET.

END



ORD.

PLATE

STD.

BOLT

RIV.

BAR

SM. STD.

PAINT

•

OPEN HOLES

UNLESS NOTED



[illegible]**CONTRACT NO.**

SHEET NO.

4089

F