


LEHIGH STRUCTURAL STEEL CO.
ALLENTOWN, PA.

WEIGHT

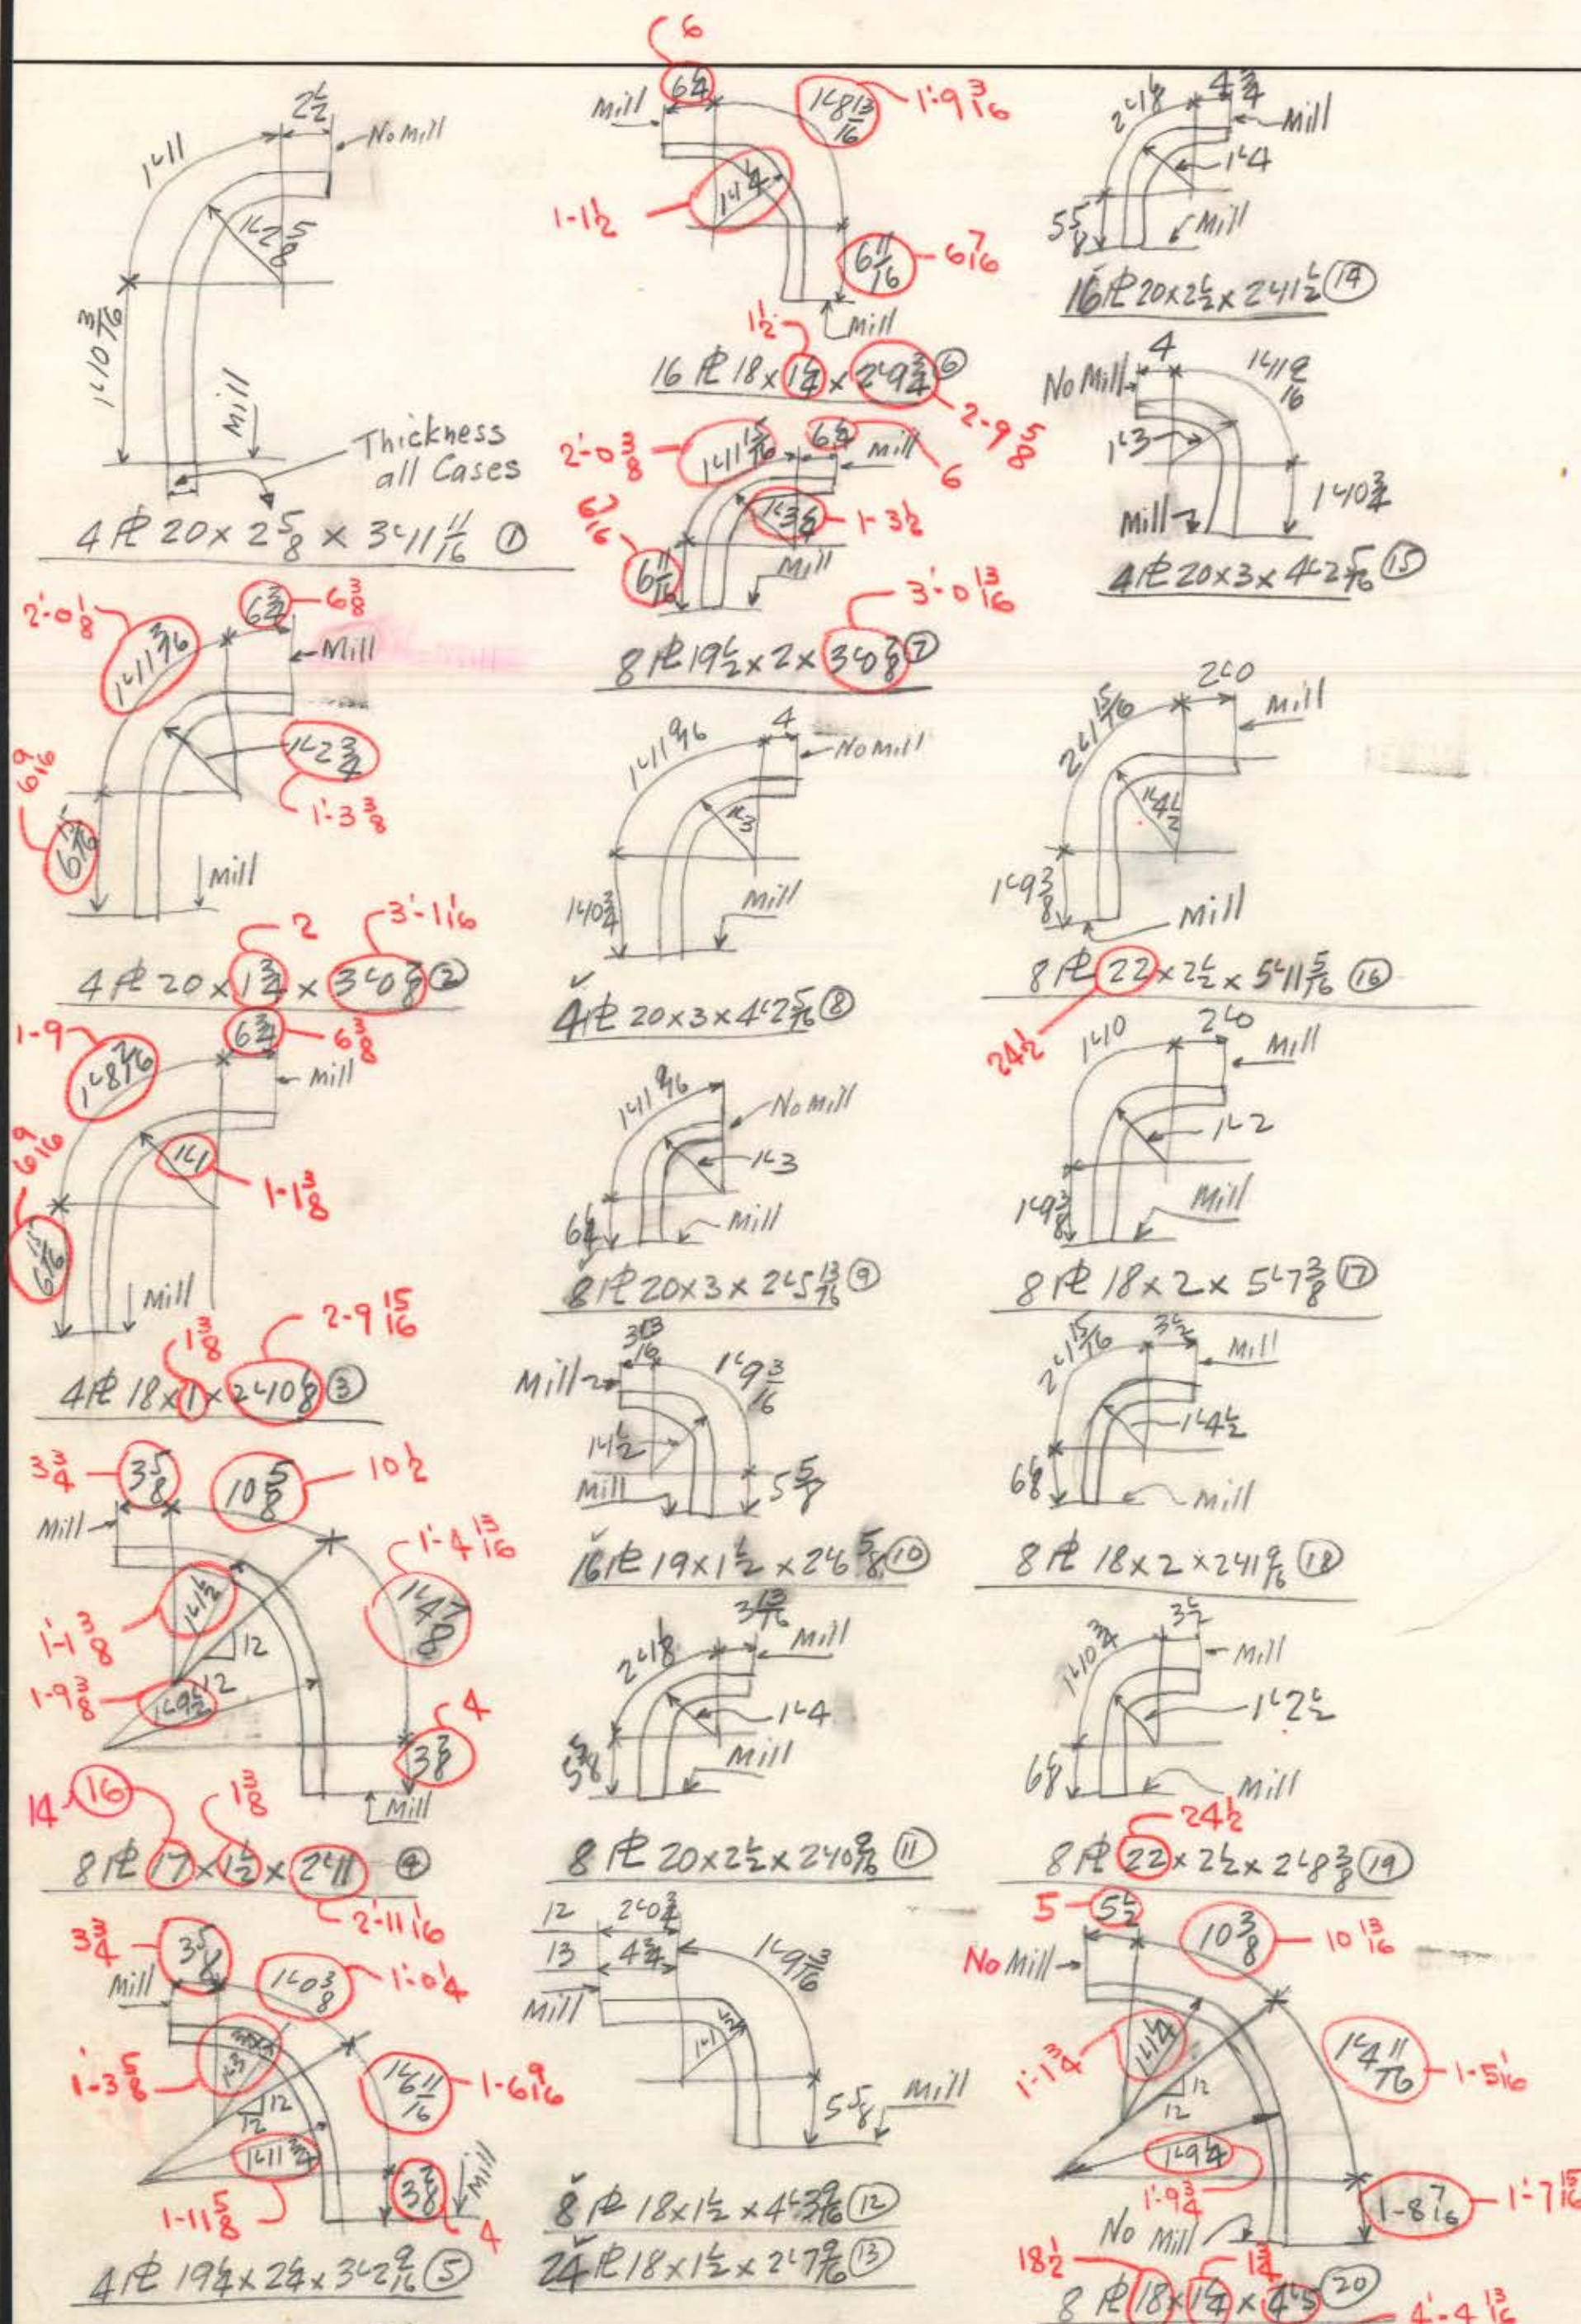

(PL lengths approximate Do not use to fabri. See Details)

Hartford Library

RIVETS		DET.		DATE		REVISION		CONTRACT NO.		SHEET NO.	
UNLESS NOTED		CHK'R F.F.		DATE 10-11-54		Revised 10-29-54		4089		FDI	
PEN HOLES		IN CHARGE				11-18-54					