
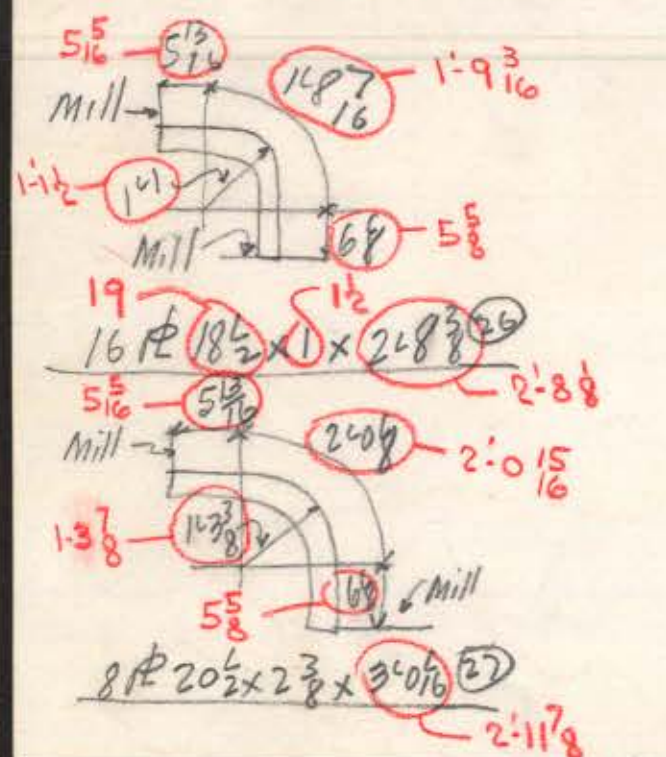
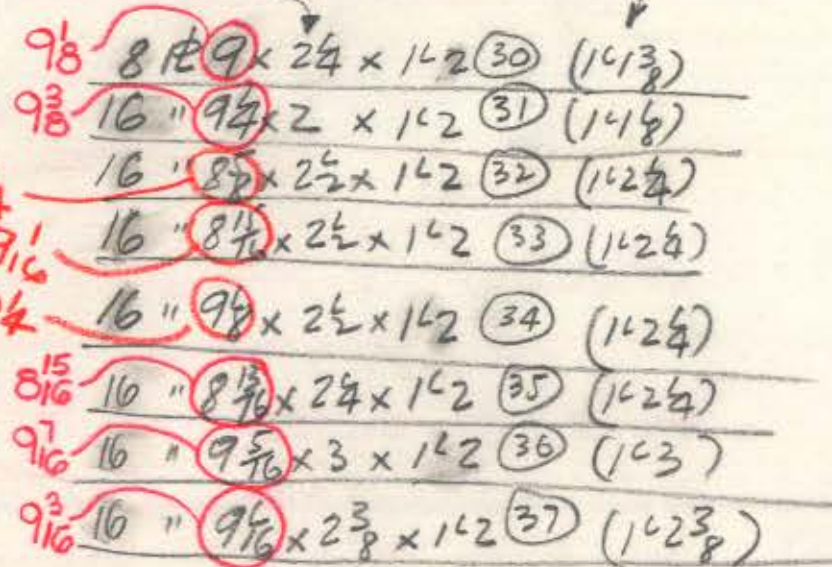
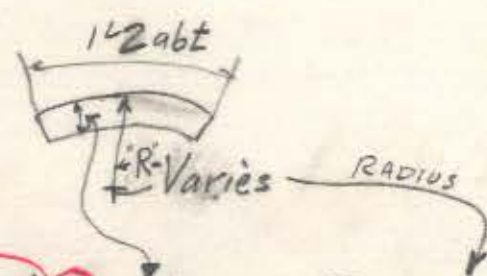


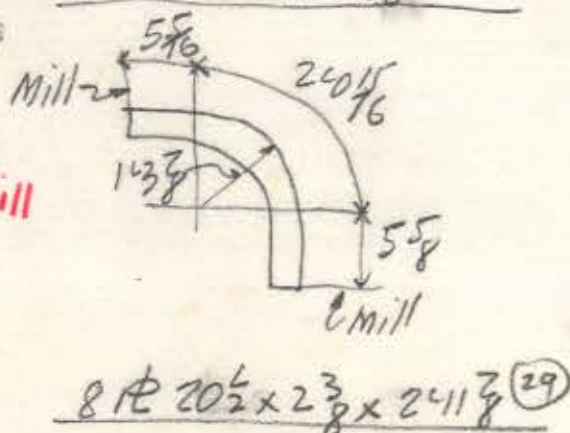

(Φ Lengths approx. Do not use to fabr. Sec Details)

Hartford Library				TOTAL	ORD.	PLATE	STD.	BOLT	RIV.	BAR	SM. STD.	PAINT	
RIVETS	UNLESS NOTED	DET.	DATE	REVISION Revised 10-29-54 - F.F. " R. #25 & #24 - R.C.G. 11-3-54 " 11-18-54							CONTRACT NO.	SHEET NO.	
OPEN HOLES	UNLESS NOTED	CHK'R F.F.	DATE 10-11-54								4089	FD2	
		IN CHARGE											